


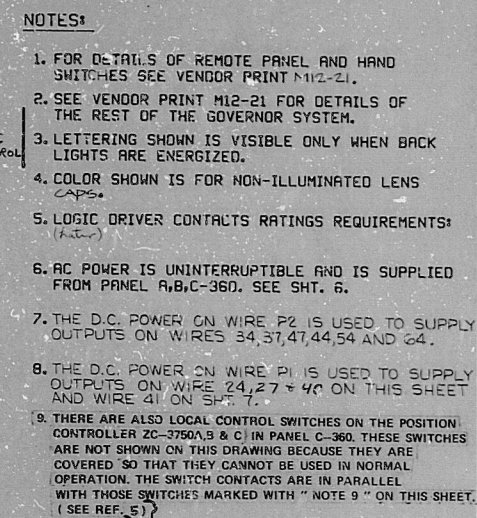

BECHTEL SAN FRANCISCO			
PUBLIC SERVICE ELECTRIC AND GAS COMPANY HOPE CREEK GENERATING STATION			
LOGIC DIAGRAM REACTOR FEED PUMP TURBINE STEAM SYS.			
GOVERNOR INTERFACES			
	JOB No.	DRAWING No.	REV.
	10855	J-31-0	SHT 5
			5

S/U - FW

RIDS

8308050721

