


34
22
17
11
8.5
0.5
11
17
22
34

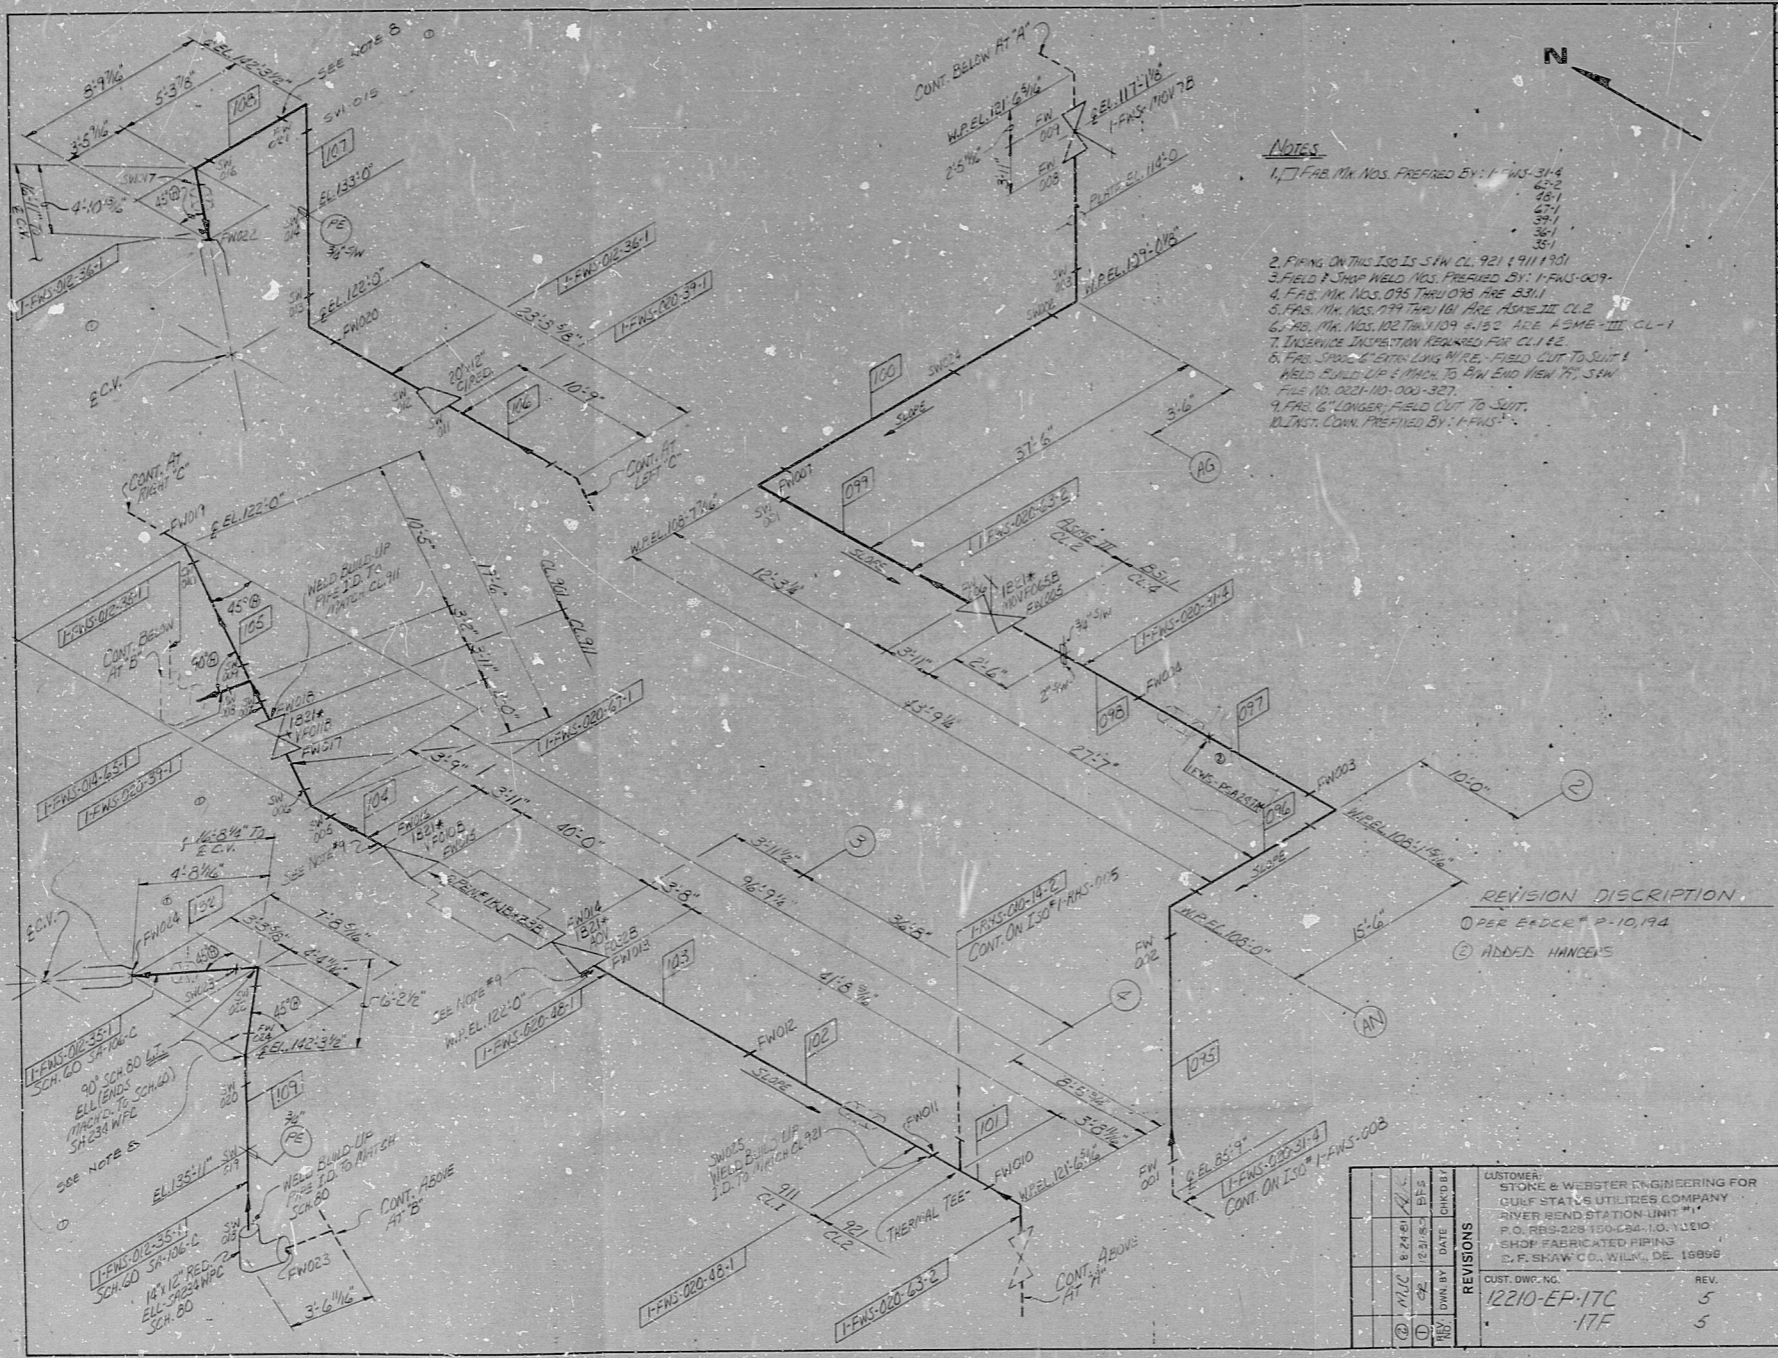

NOTES

- FAB. MK. NOS. FABRICATION BY: I-FWS-314
- FIELD 1 SHAP WELD NOS. FABRICATION BY: I-FWS-009



REVISION DESCRIPTION

① PER EDGE P-10, 194

② ADDED HANGES


BENJAMIN F. SHAW CO.
WILMINGTON, DELAWARE

FEED WATER

ERECTOR: B.F. SHAW

DATE: 3-21-81











ATTACH TO MFR'S DRAWING

APERTURE CARD 8202230640

RIDS

8202230640

