



J-41-0 SHT. 5

This drawing and its design it covers are the property of BECHTEL. They are merely loaned and on the borrower's express agreement that they will not be reproduced, copied, loaned, exhibited, nor used except in the limited way and private use permitted by any written consent given by the lender to the borrower.

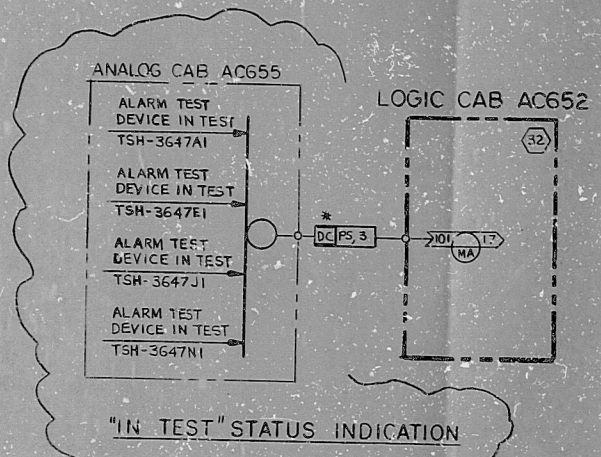

CROSS REFERENCE TABLE

SWITCH NO.	ANALOG CAB. NO.	LOGIC CAB. NO.	CLASS IE CHANNEL	CKT NO.	"IN TEST" STATUS ARROW
TSH-3647AI	AC655	AC652	A	32	J-101/MA/17
TSH-3647EI					
TSH-3647JI					
TSH-3647NI					
TSH-3647BI	BC655	BC652	B	27	J-101/MB/17
TSH-3647FI					
TSH-3647CI					
TSH-3647PI					
TSH-3647GI	CC655	CC652	C	33	J-101/MC/17
TSH-3647LI					
TSH-3647DI					
TSH-3647HI					
TSH-3647MI	DC655	DC652	D	28	J-101/MD/17
TSH-3647RI					

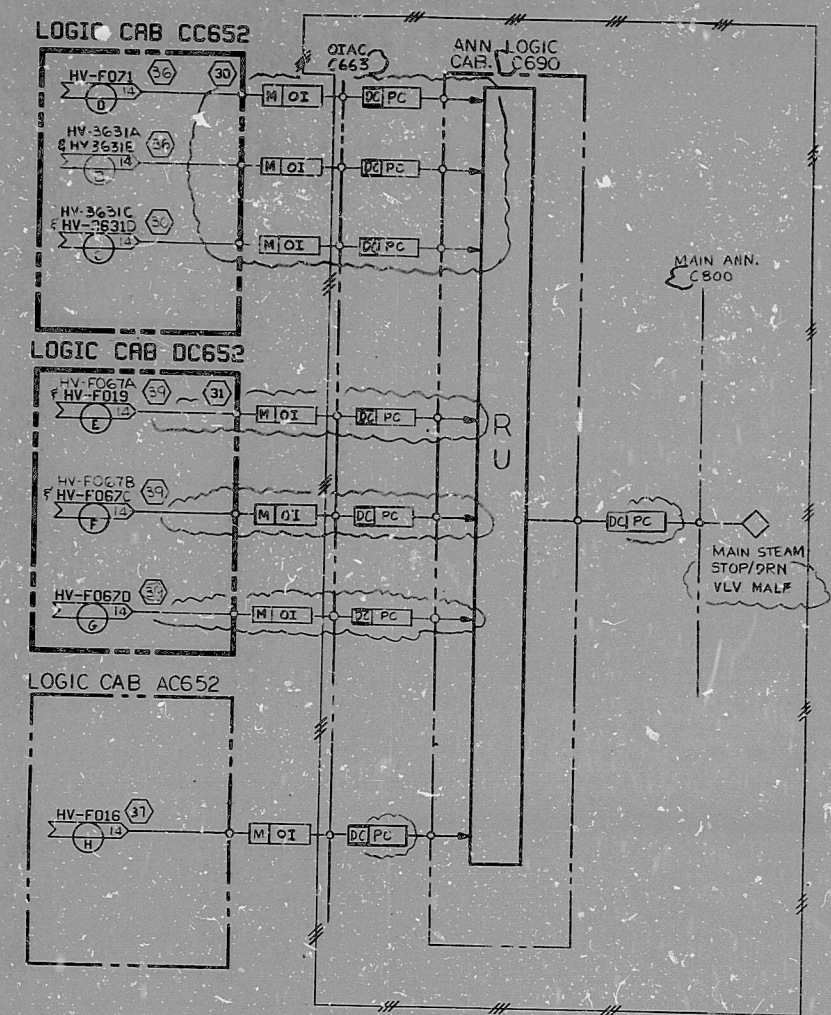

MAIN STEAM STOP DRAIN VALVE MALFUNCTION ALARM

PRO APERTURE CARD

DESIGN FREEZE ISSUE	4/1/78	BY	CHK	APP												
REVISED BAILEY INTERFACE AS NOTED	4/1/78	BY	CHK	APP												
INCORPORATED DCN #1	4/1/78	BY	CHK	APP												
REVISED AS NOTED	4/1/78	BY	CHK	APP												
ISSUED FOR CONSTRUCTION	4/1/78	BY	CHK	APP												
<table border="1"> <tr> <th>NO.</th> <th>DATE</th> <th>REVISIONS</th> <th>BY</th> <th>CHK</th> <th>APP</th> </tr> <tr> <td>1</td> <td>4/1/78</td> <td>DESIGN</td> <td>ML</td> <td>ML</td> <td>ML</td> </tr> </table>					NO.	DATE	REVISIONS	BY	CHK	APP	1	4/1/78	DESIGN	ML	ML	ML
NO.	DATE	REVISIONS	BY	CHK	APP											
1	4/1/78	DESIGN	ML	ML	ML											
BECHTEL SAN FRANCISCO PUBLIC SERVICE ELECTRIC AND GAS COMPANY HOPE CREEK GENERATING STATION LOGIC DIAGRAM NUCLEAR BOILER "IN TEST" STATUS INDICATION & MAIN STEAM STOP/DRN VLV MALF ALARM <table border="1"> <tr> <td>JOB NO.</td> <td>DRAWING NO.</td> <td>REV.</td> </tr> <tr> <td>10855</td> <td>J-41-0 SHT. 5</td> <td>4</td> </tr> </table>					JOB NO.	DRAWING NO.	REV.	10855	J-41-0 SHT. 5	4						
JOB NO.	DRAWING NO.	REV.														
10855	J-41-0 SHT. 5	4														

S/U - AB, RE

27 x 34 "D" SIZE

RIDS

8308080076

