


This drawing and the design it covers are the property of BECHTEL. They are hereby loaned and on the borrower's express agreement that they will not be reproduced, copied, loaned, exhibited, nor used except in the limited way and under the conditions permitted by the lender to the borrower.

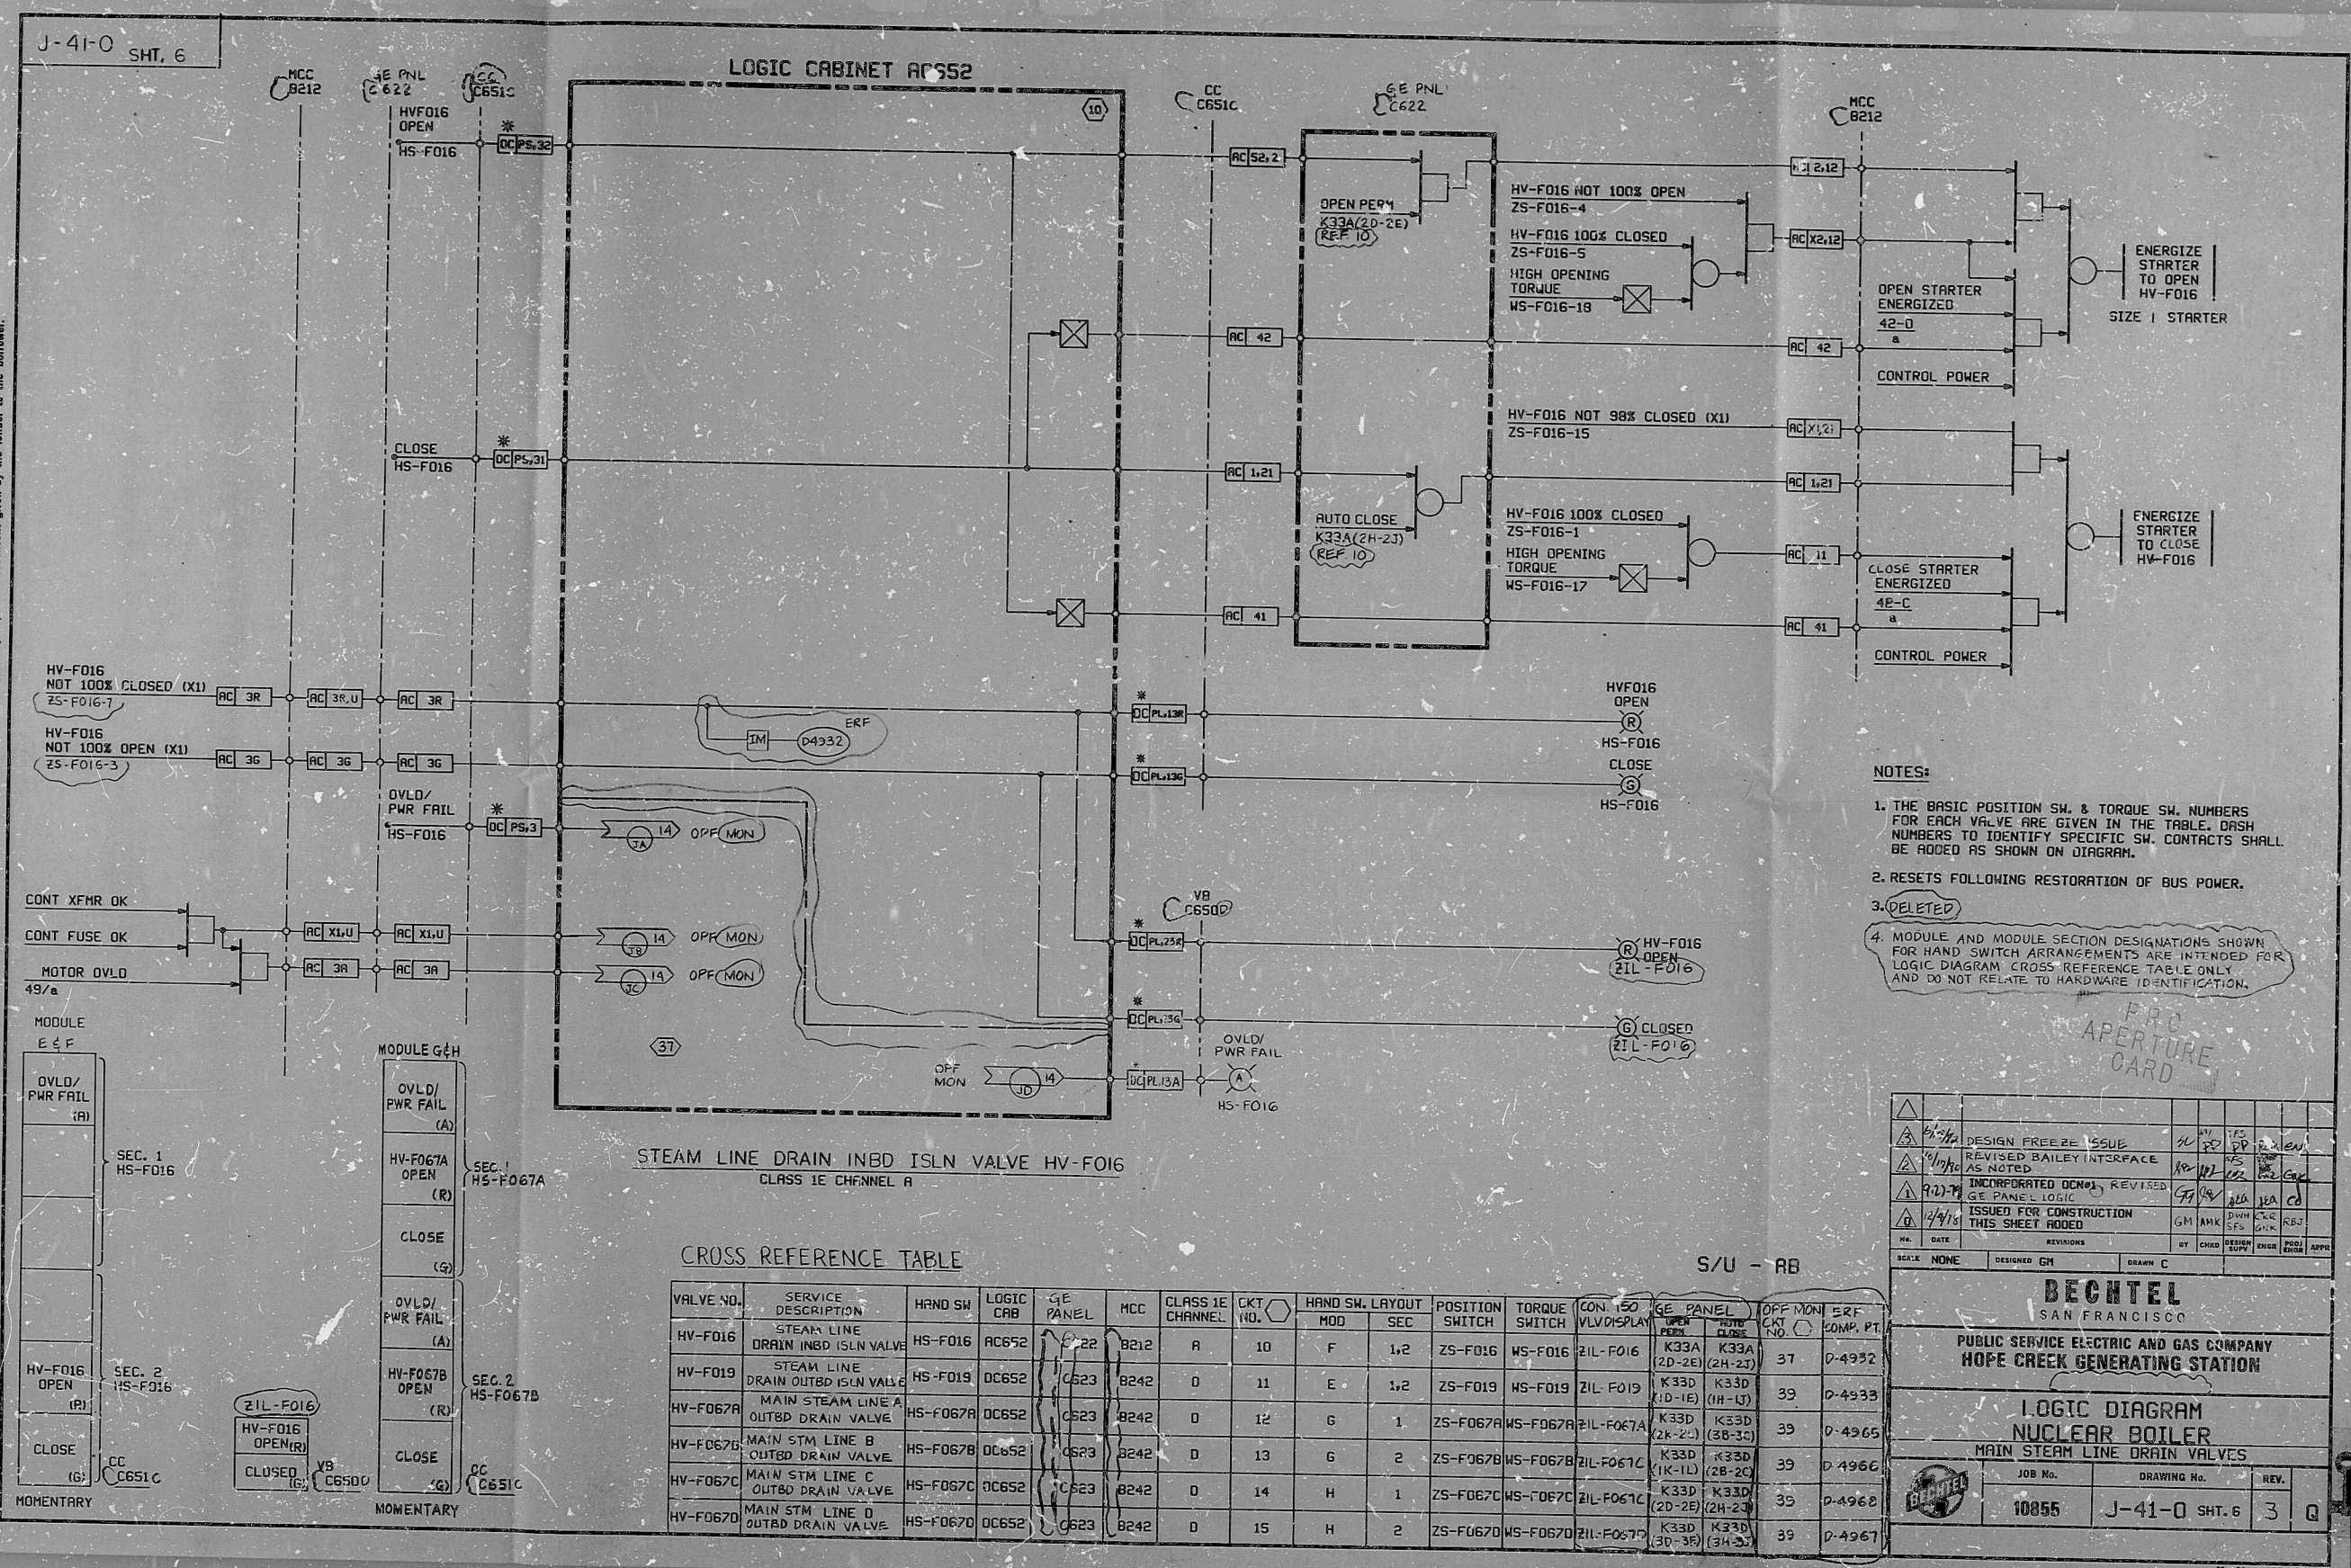

DESIGN FREEZE ISSUE	REVISED BAILEY INTERFACE AS NOTED	INCORPORATED DCN01, REVISED GE PANEL LOGIC	ISSUED FOR CONSTRUCTION THIS SHEET ADDED
DATE	REVISIONS	BY	CHKD
SCALE	NONE	DESIGNED	CH
		DRAWN	C
BECHTEL SAN FRANCISCO			
PUBLIC SERVICE ELECTRIC AND GAS COMPANY HOPE CREEK GENERATING STATION			
LOGIC DIAGRAM NUCLEAR BOILER MAIN STEAM LINE DRAIN VALVES			
JOB No.	DRAWING No.	REV.	Q
10855	J-41-0 SHT. 6	3	Q

RIDS

8308089078

