
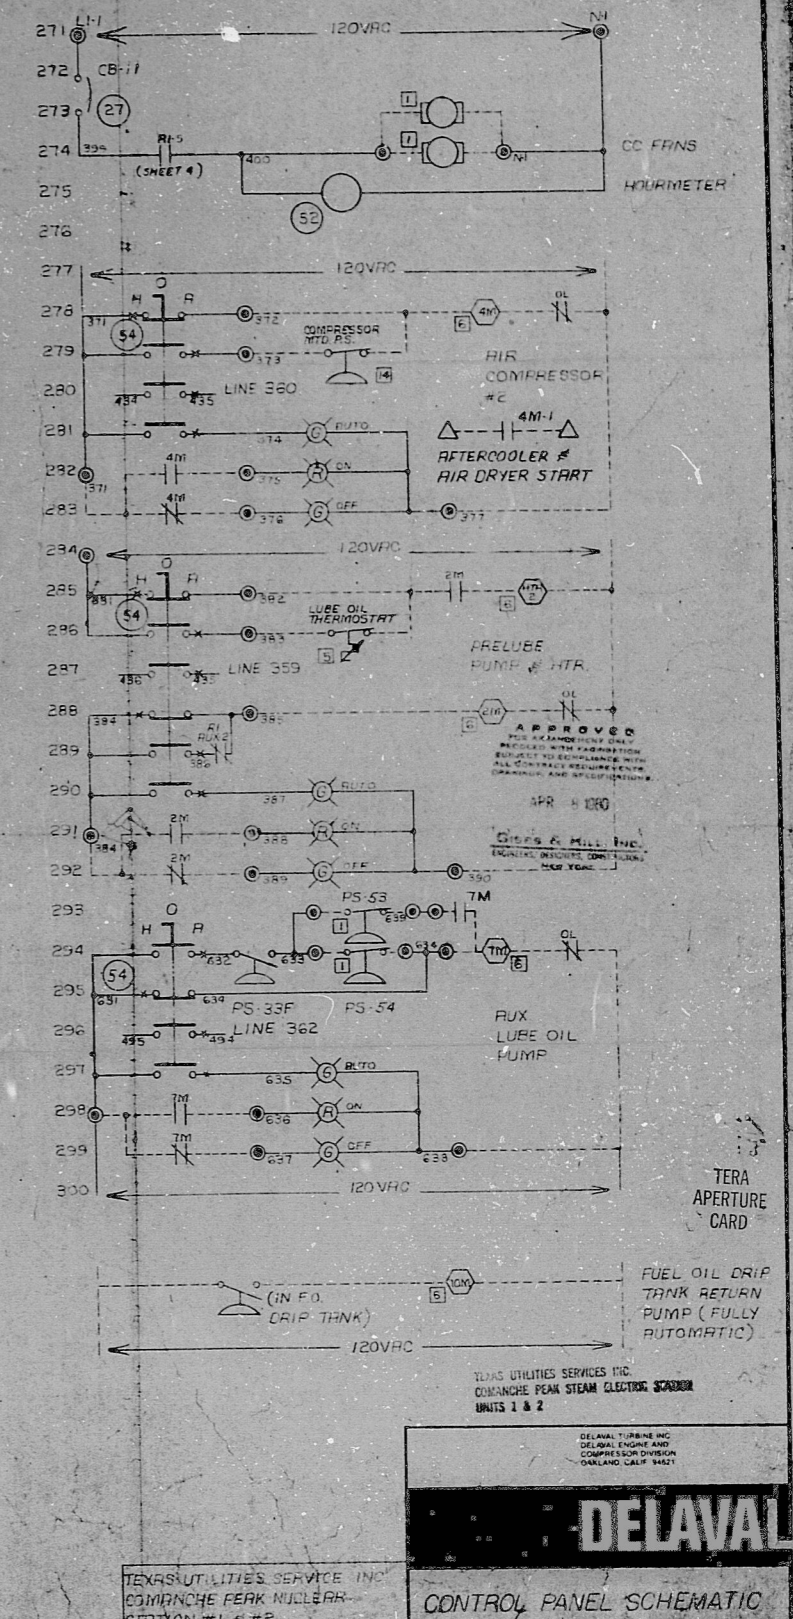
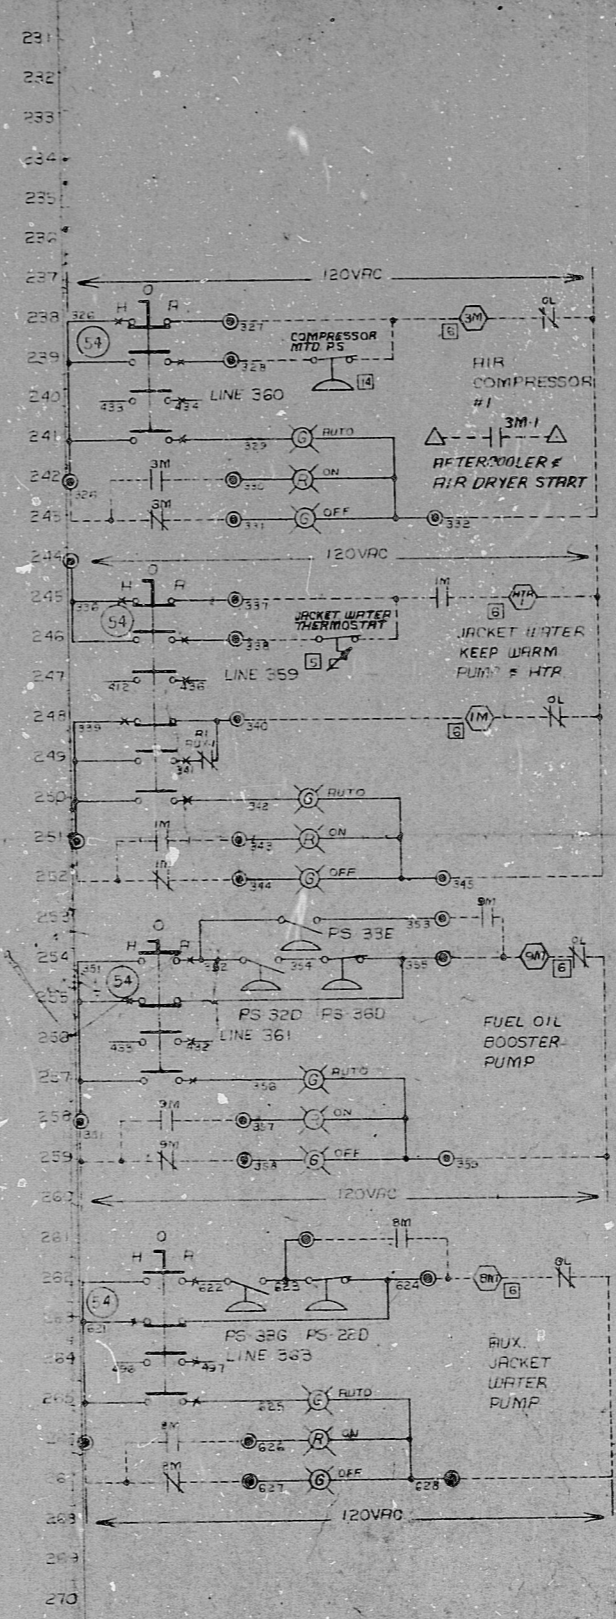


R16	311, 377
R17	374, 397
R18	504, 510
R19	507, 513
R20	569, 132

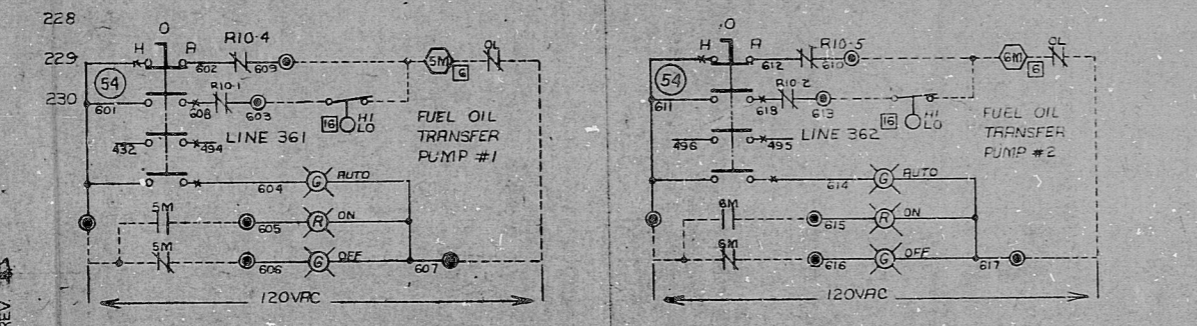

DELAVAL
 CONTROL PANEL SCHEMATIC
 TEXAS UTILITIES SERVICE INC.
 COMANCHE PEAK NUCLEAR STATION #1 & #2
 SHEET 5 OF 8
 09-500-76001

DATE RELEASED
 (SEE SHEET 8 FOR CURRENT REV)

RECEIVED

8867310307

PDR

8007210504

