


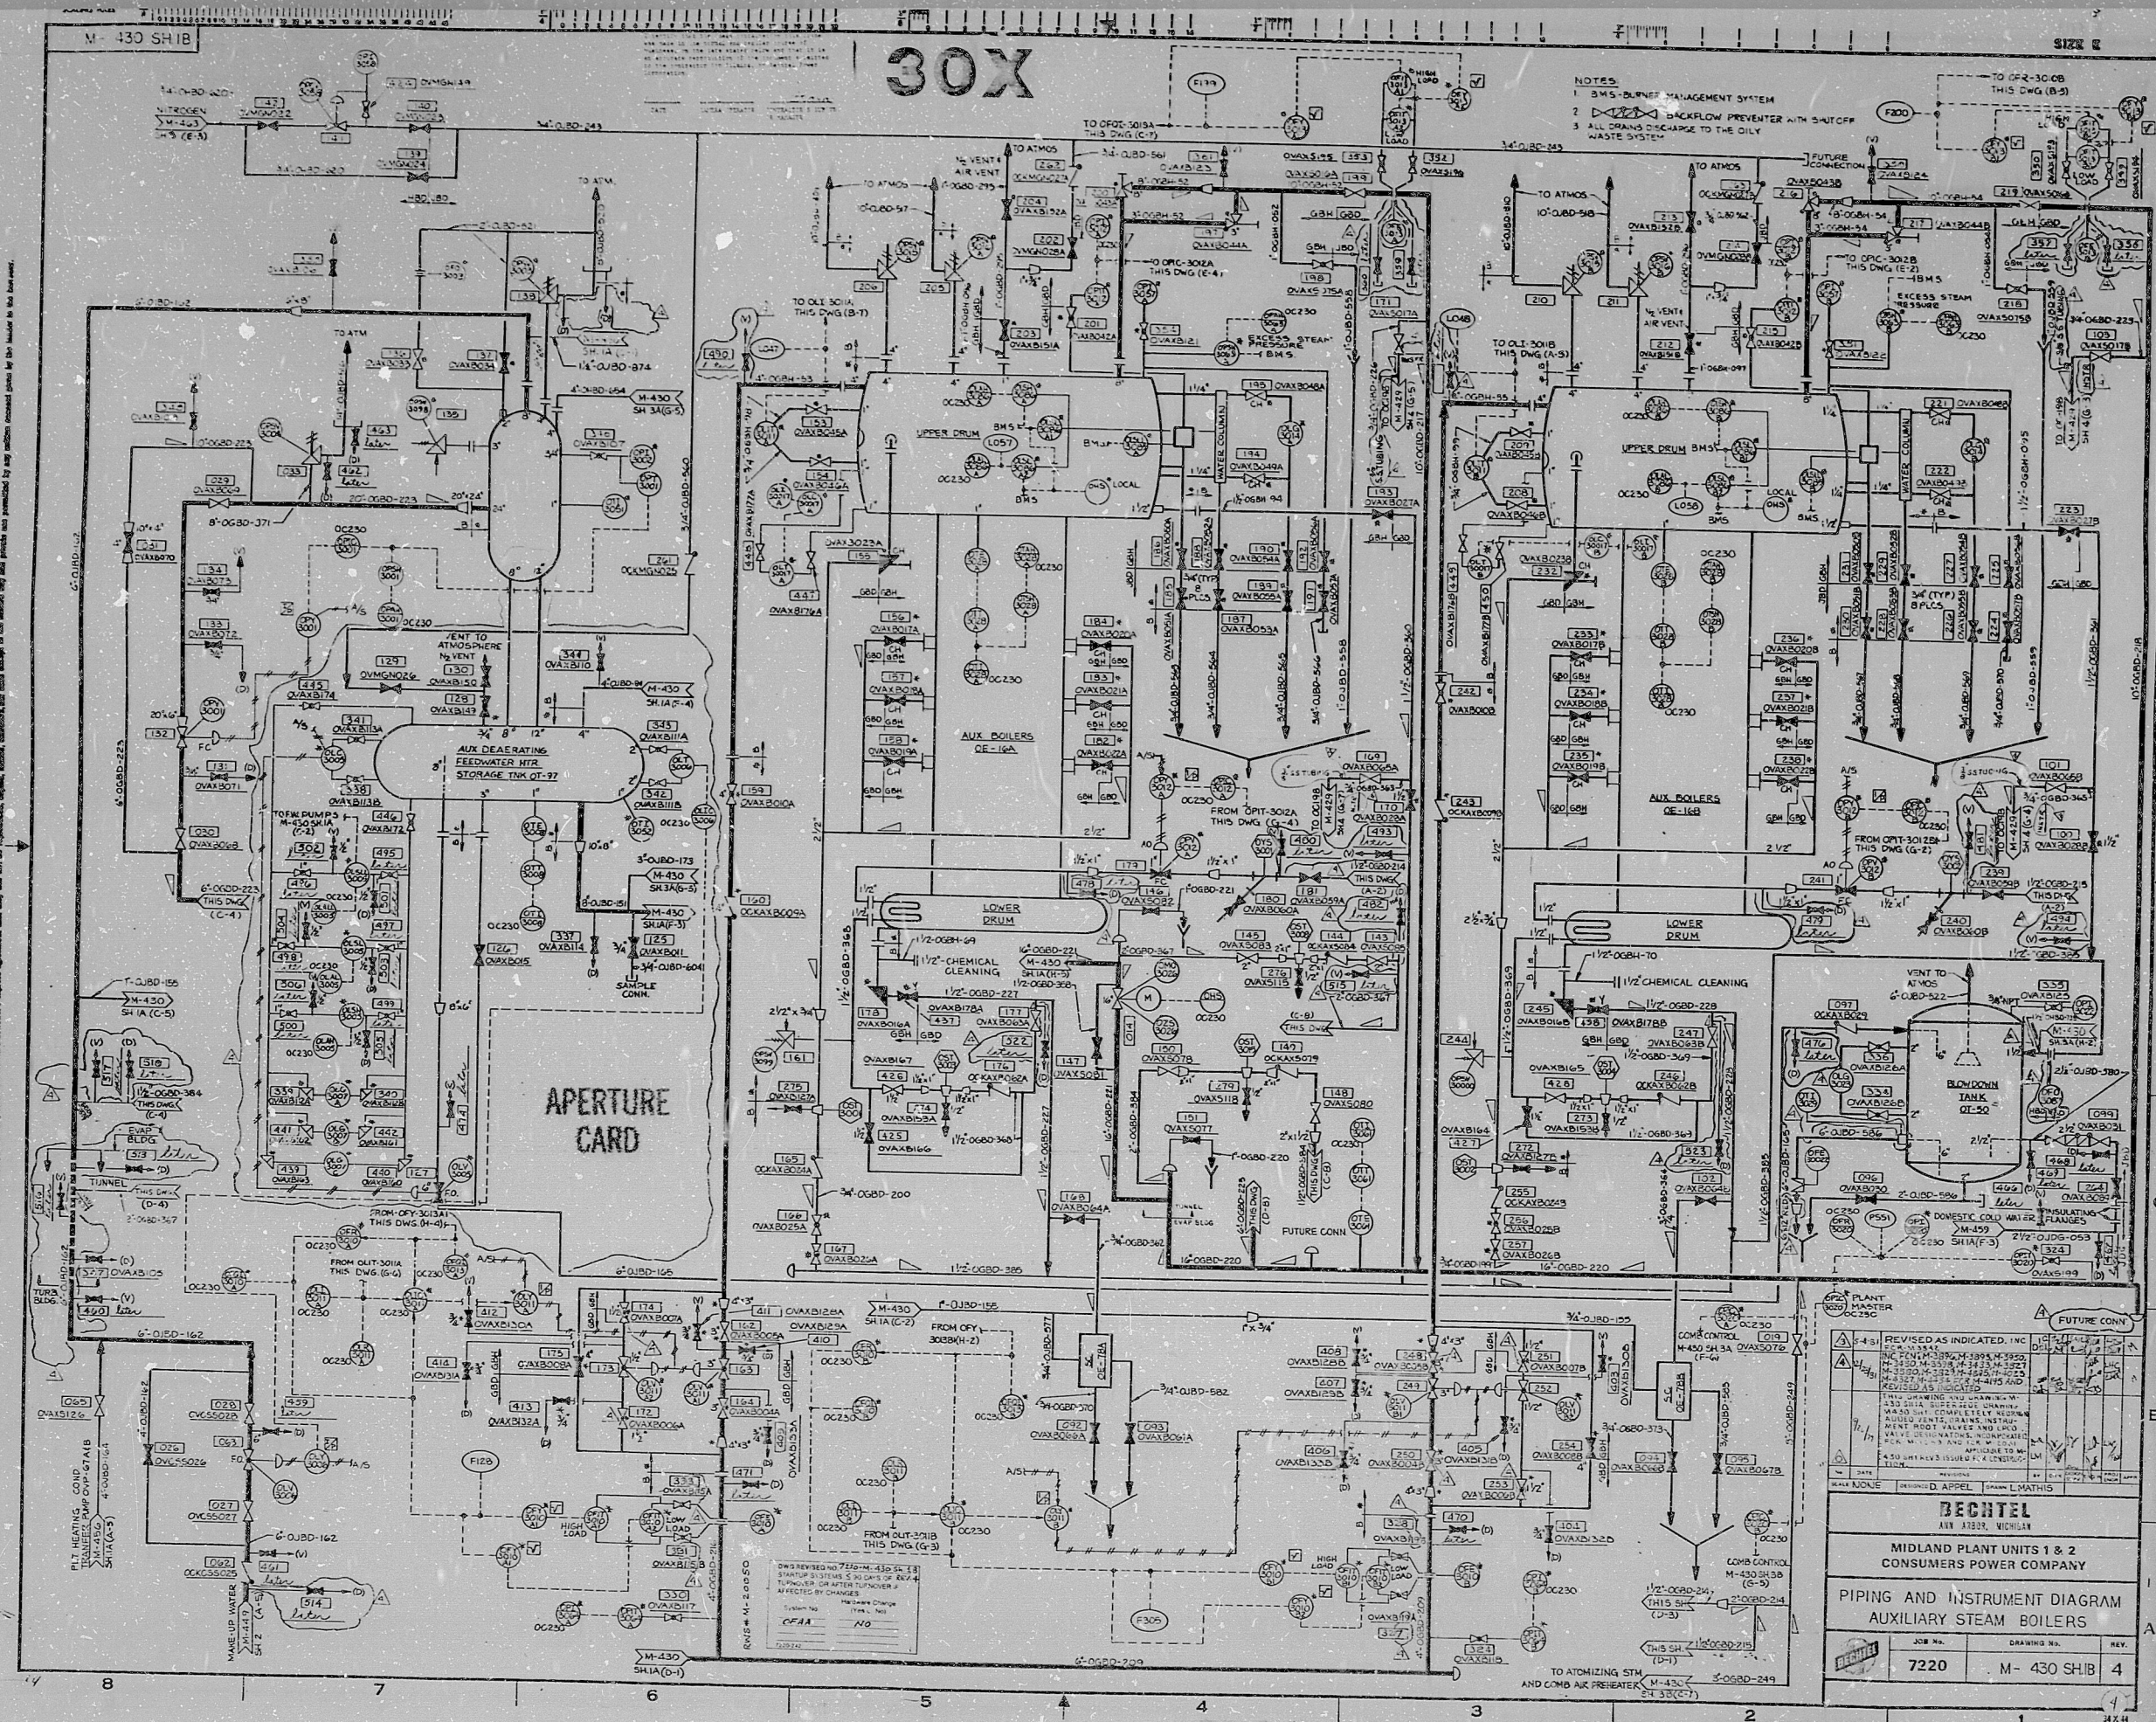

8203010425

