


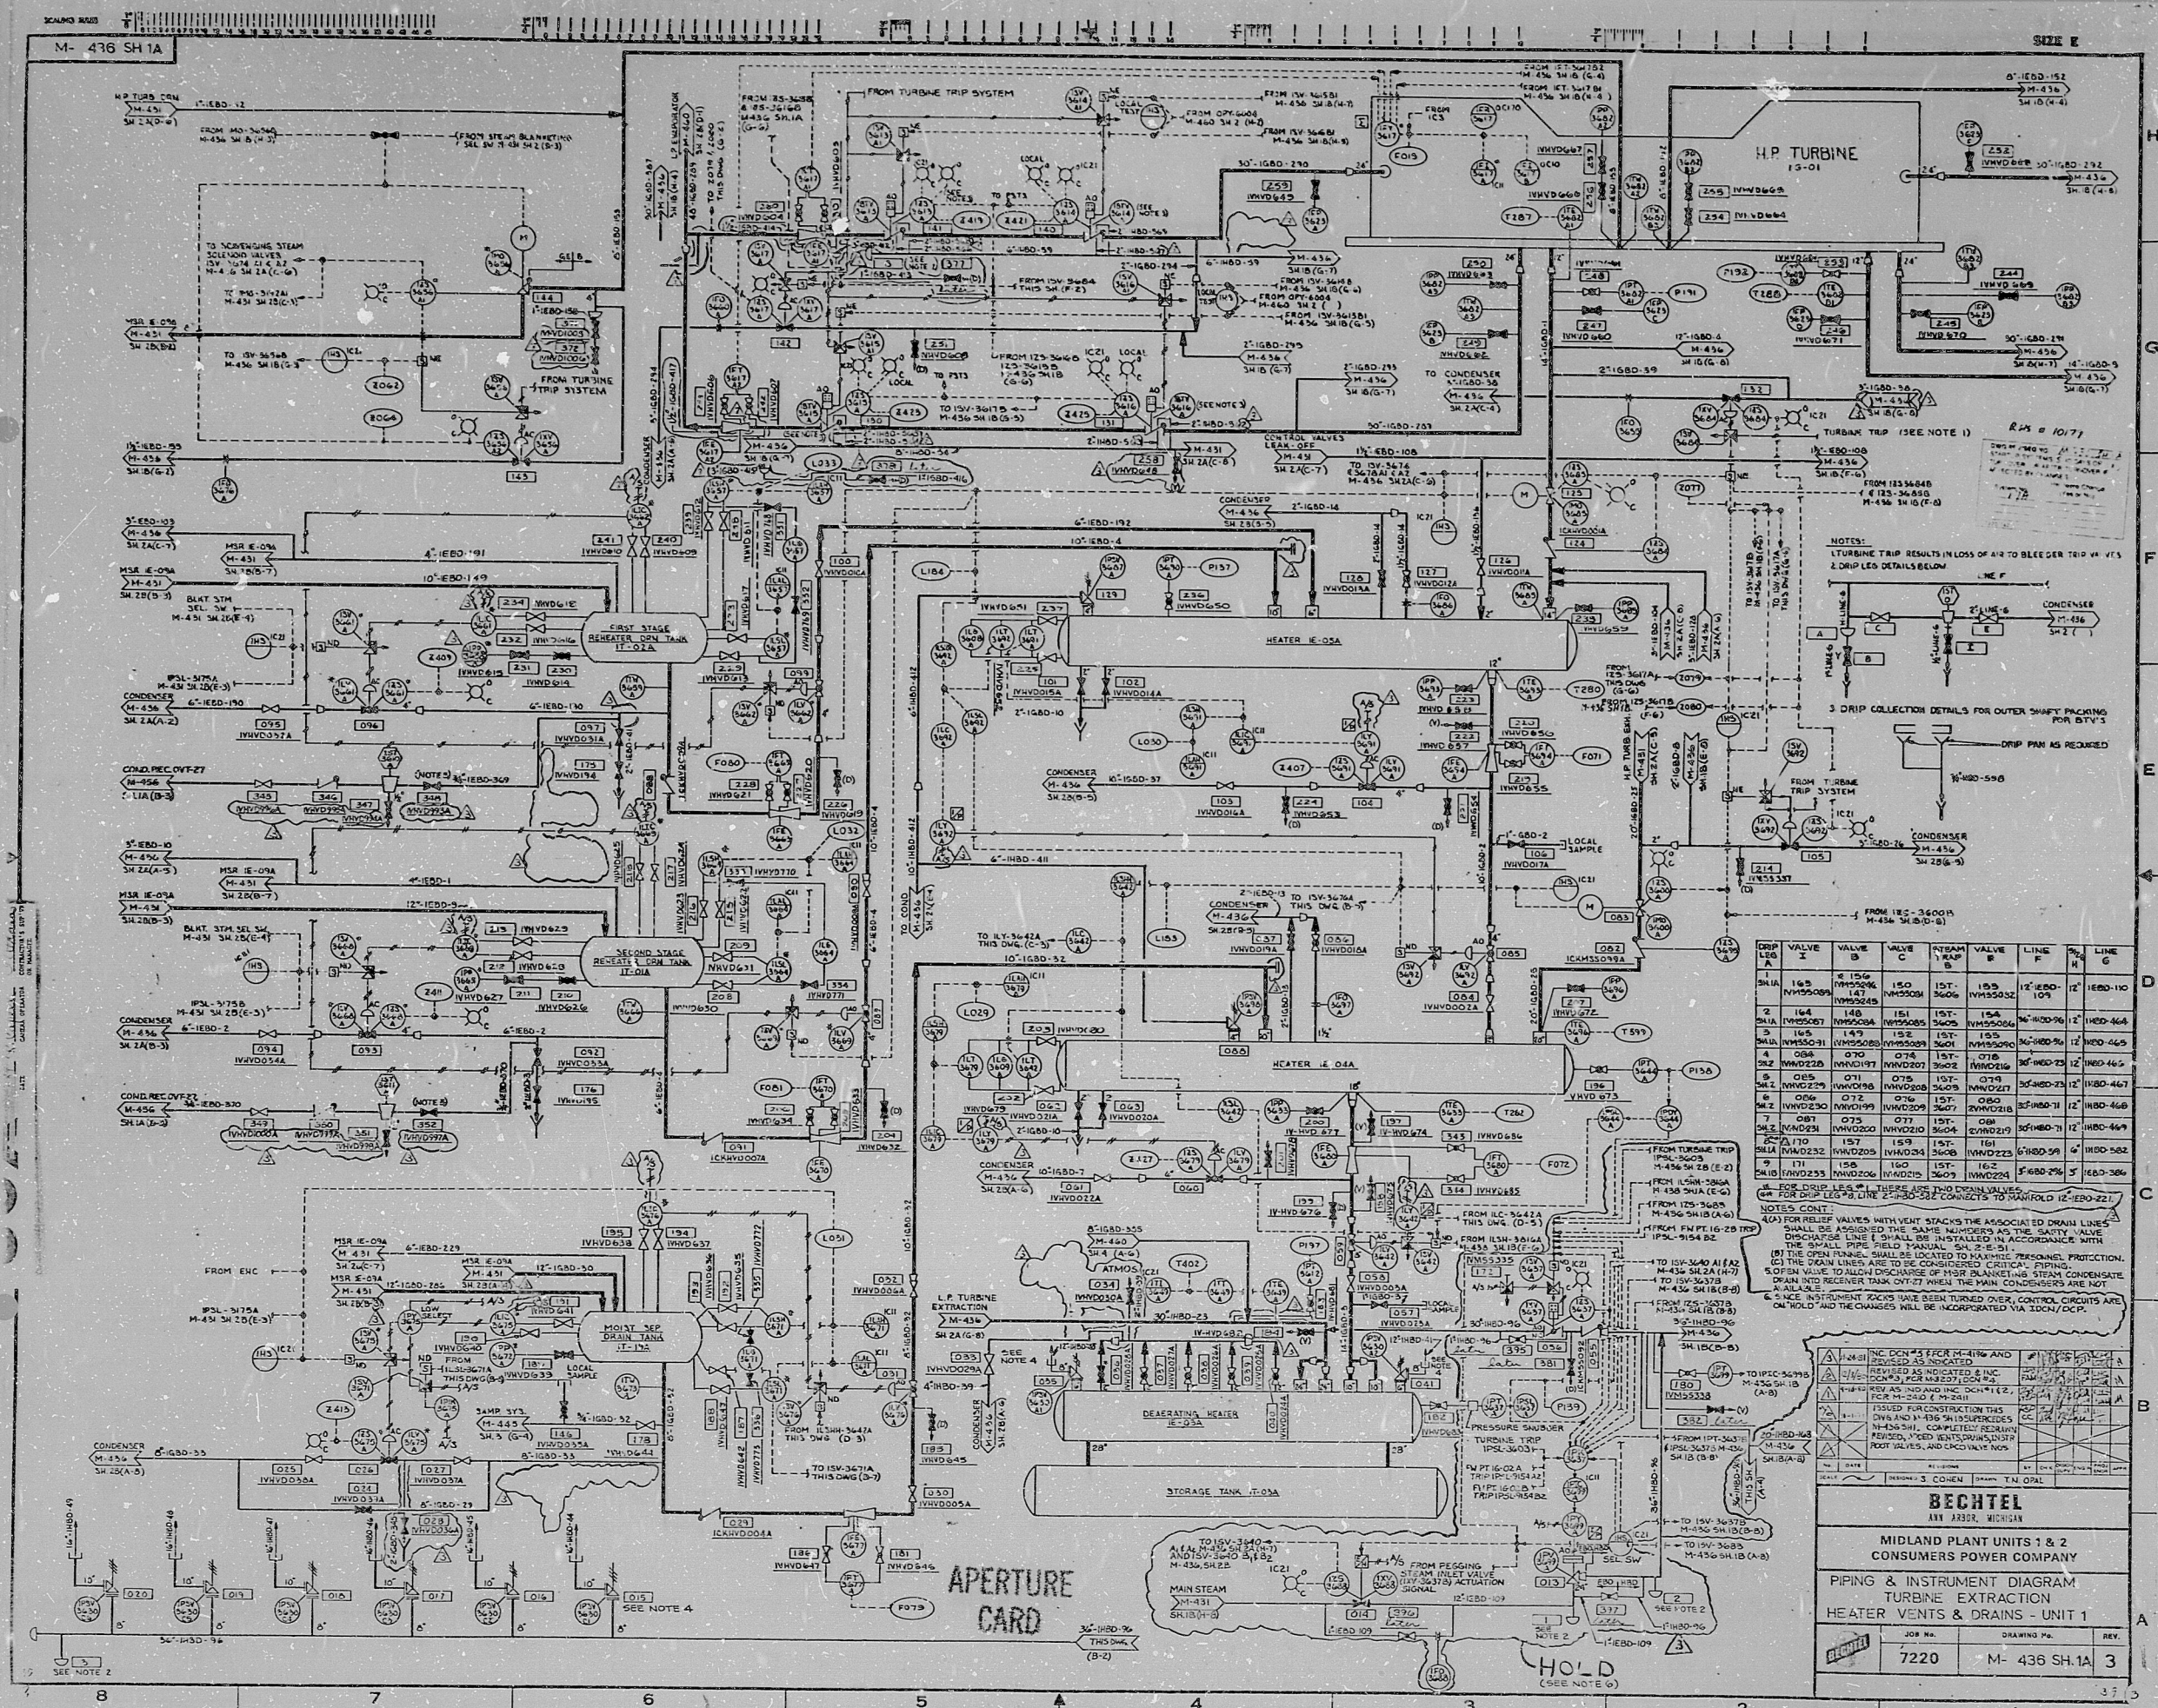

8203010429

