


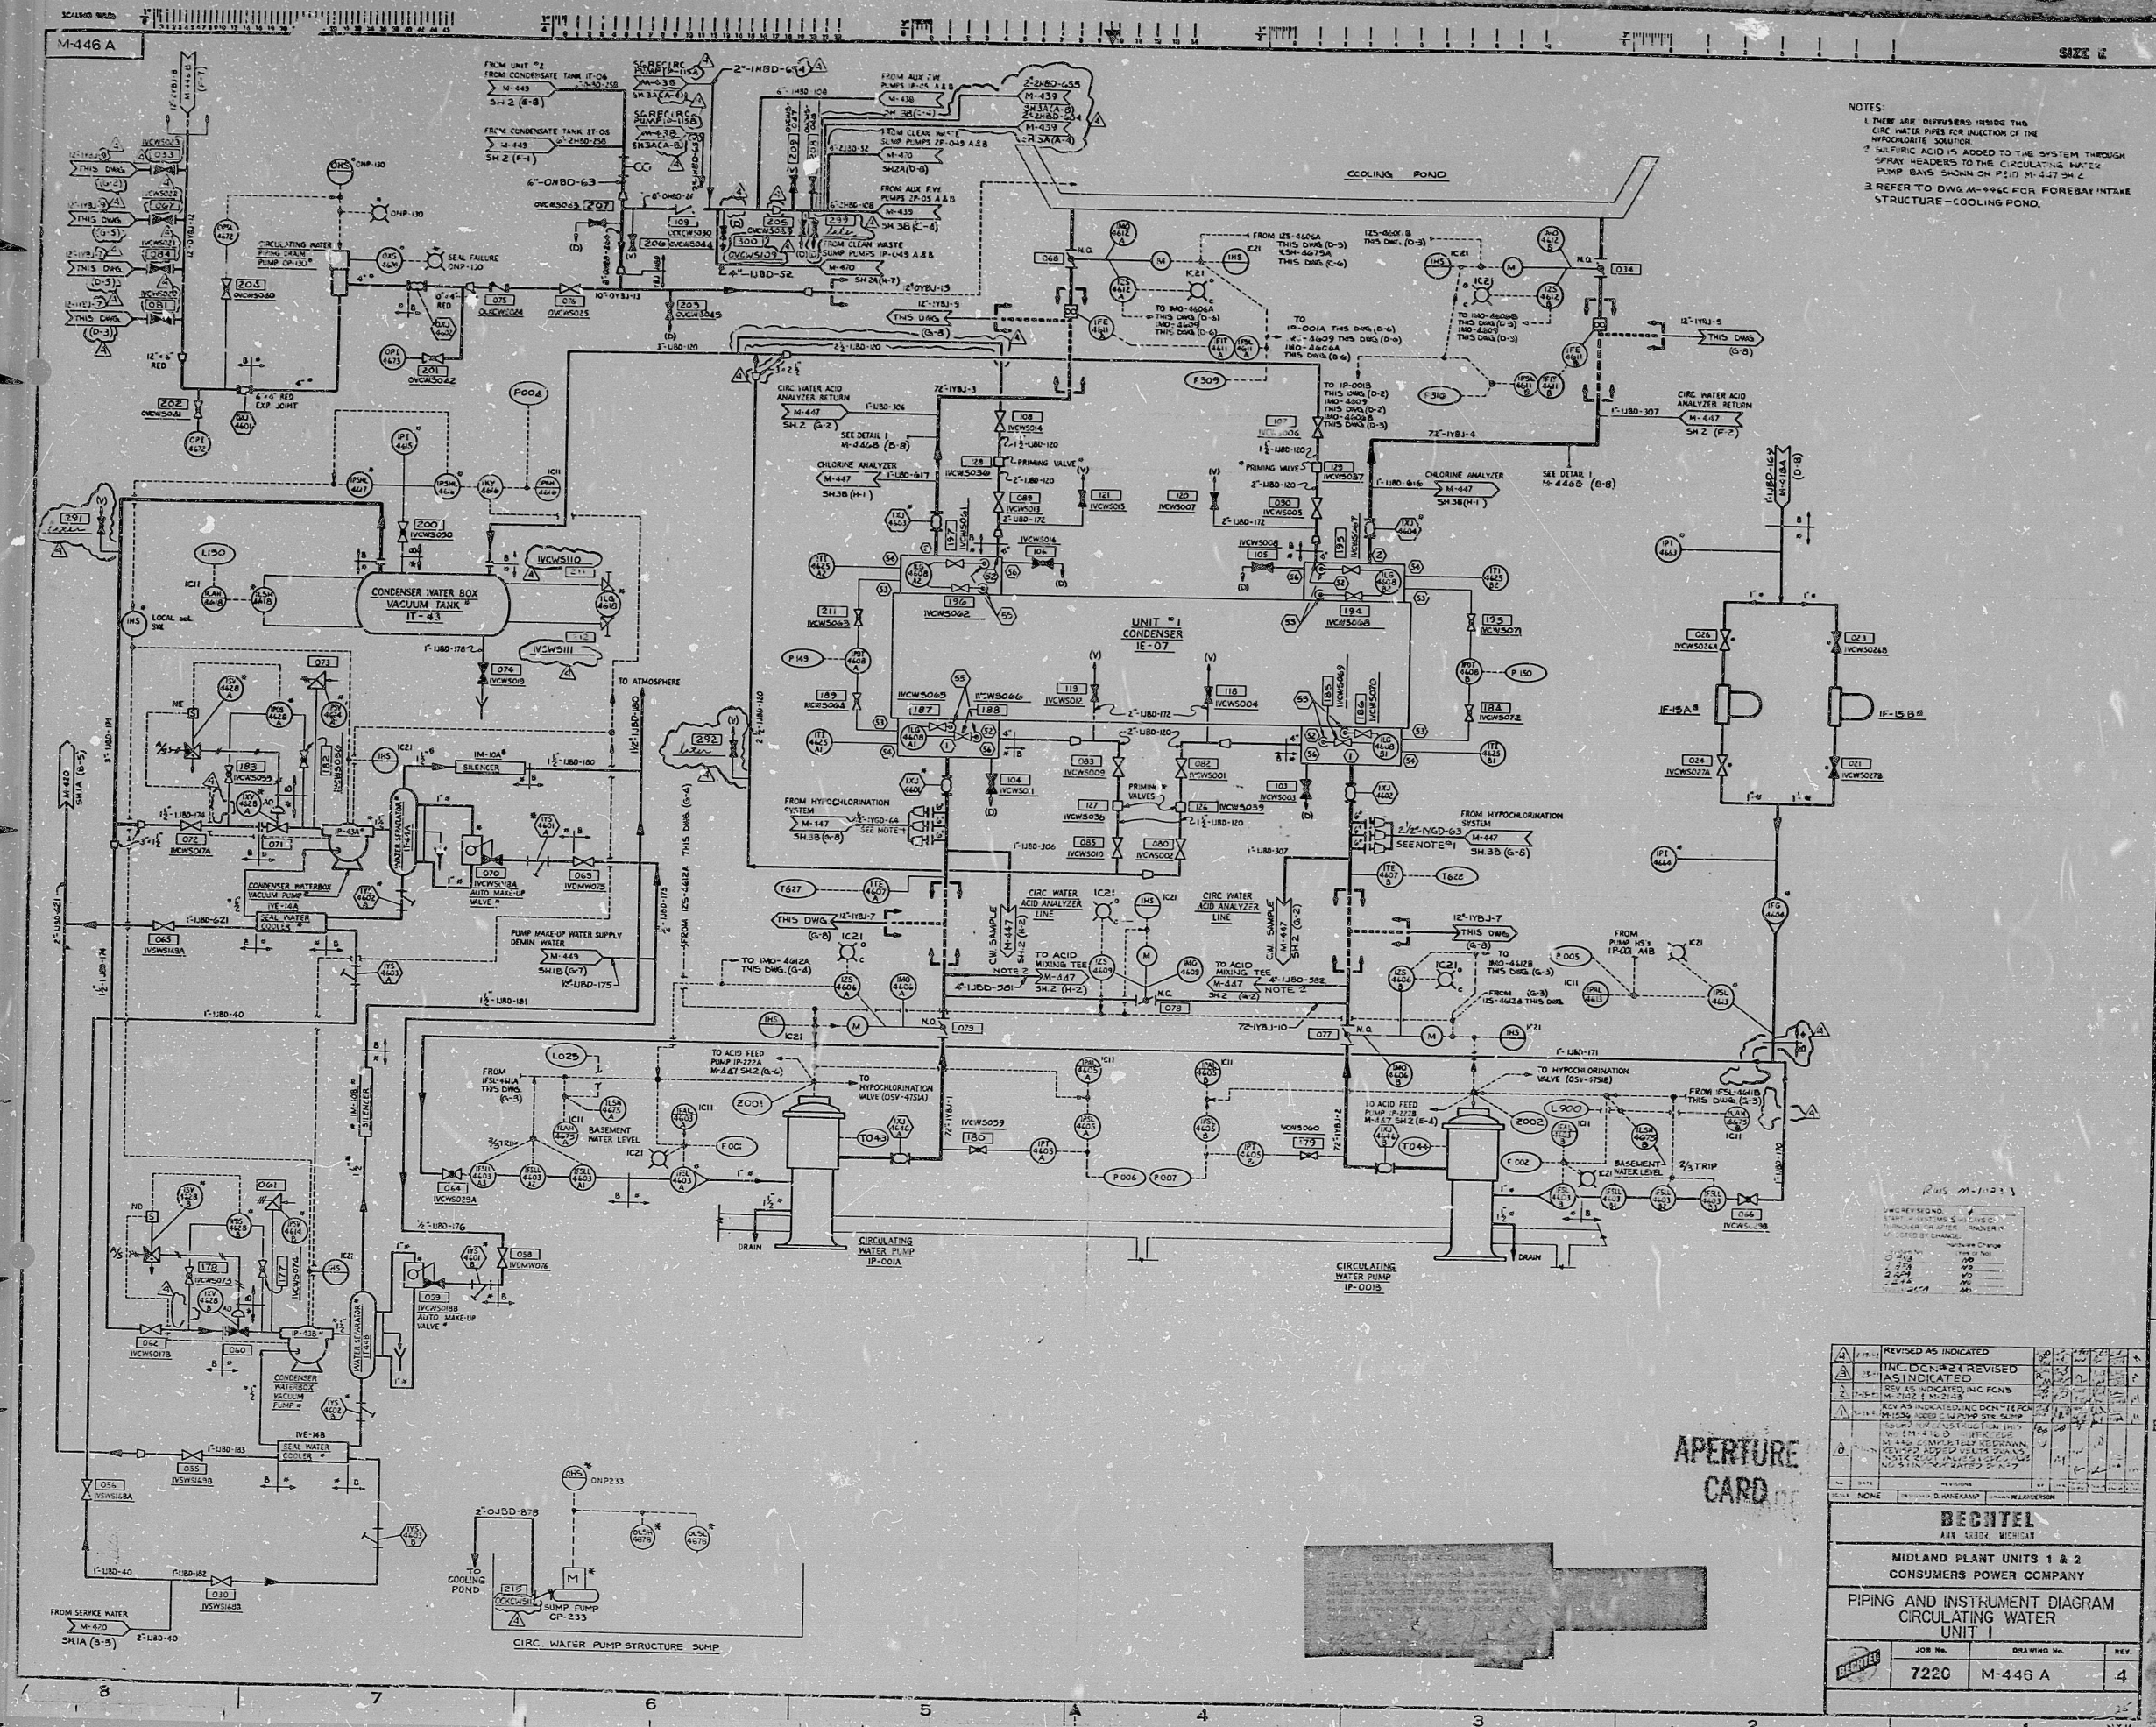

8203010480

