


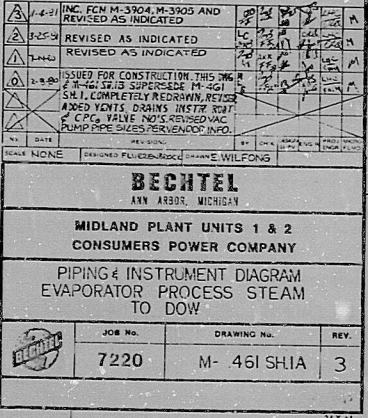



8203020148

