




RIDS

8308080207

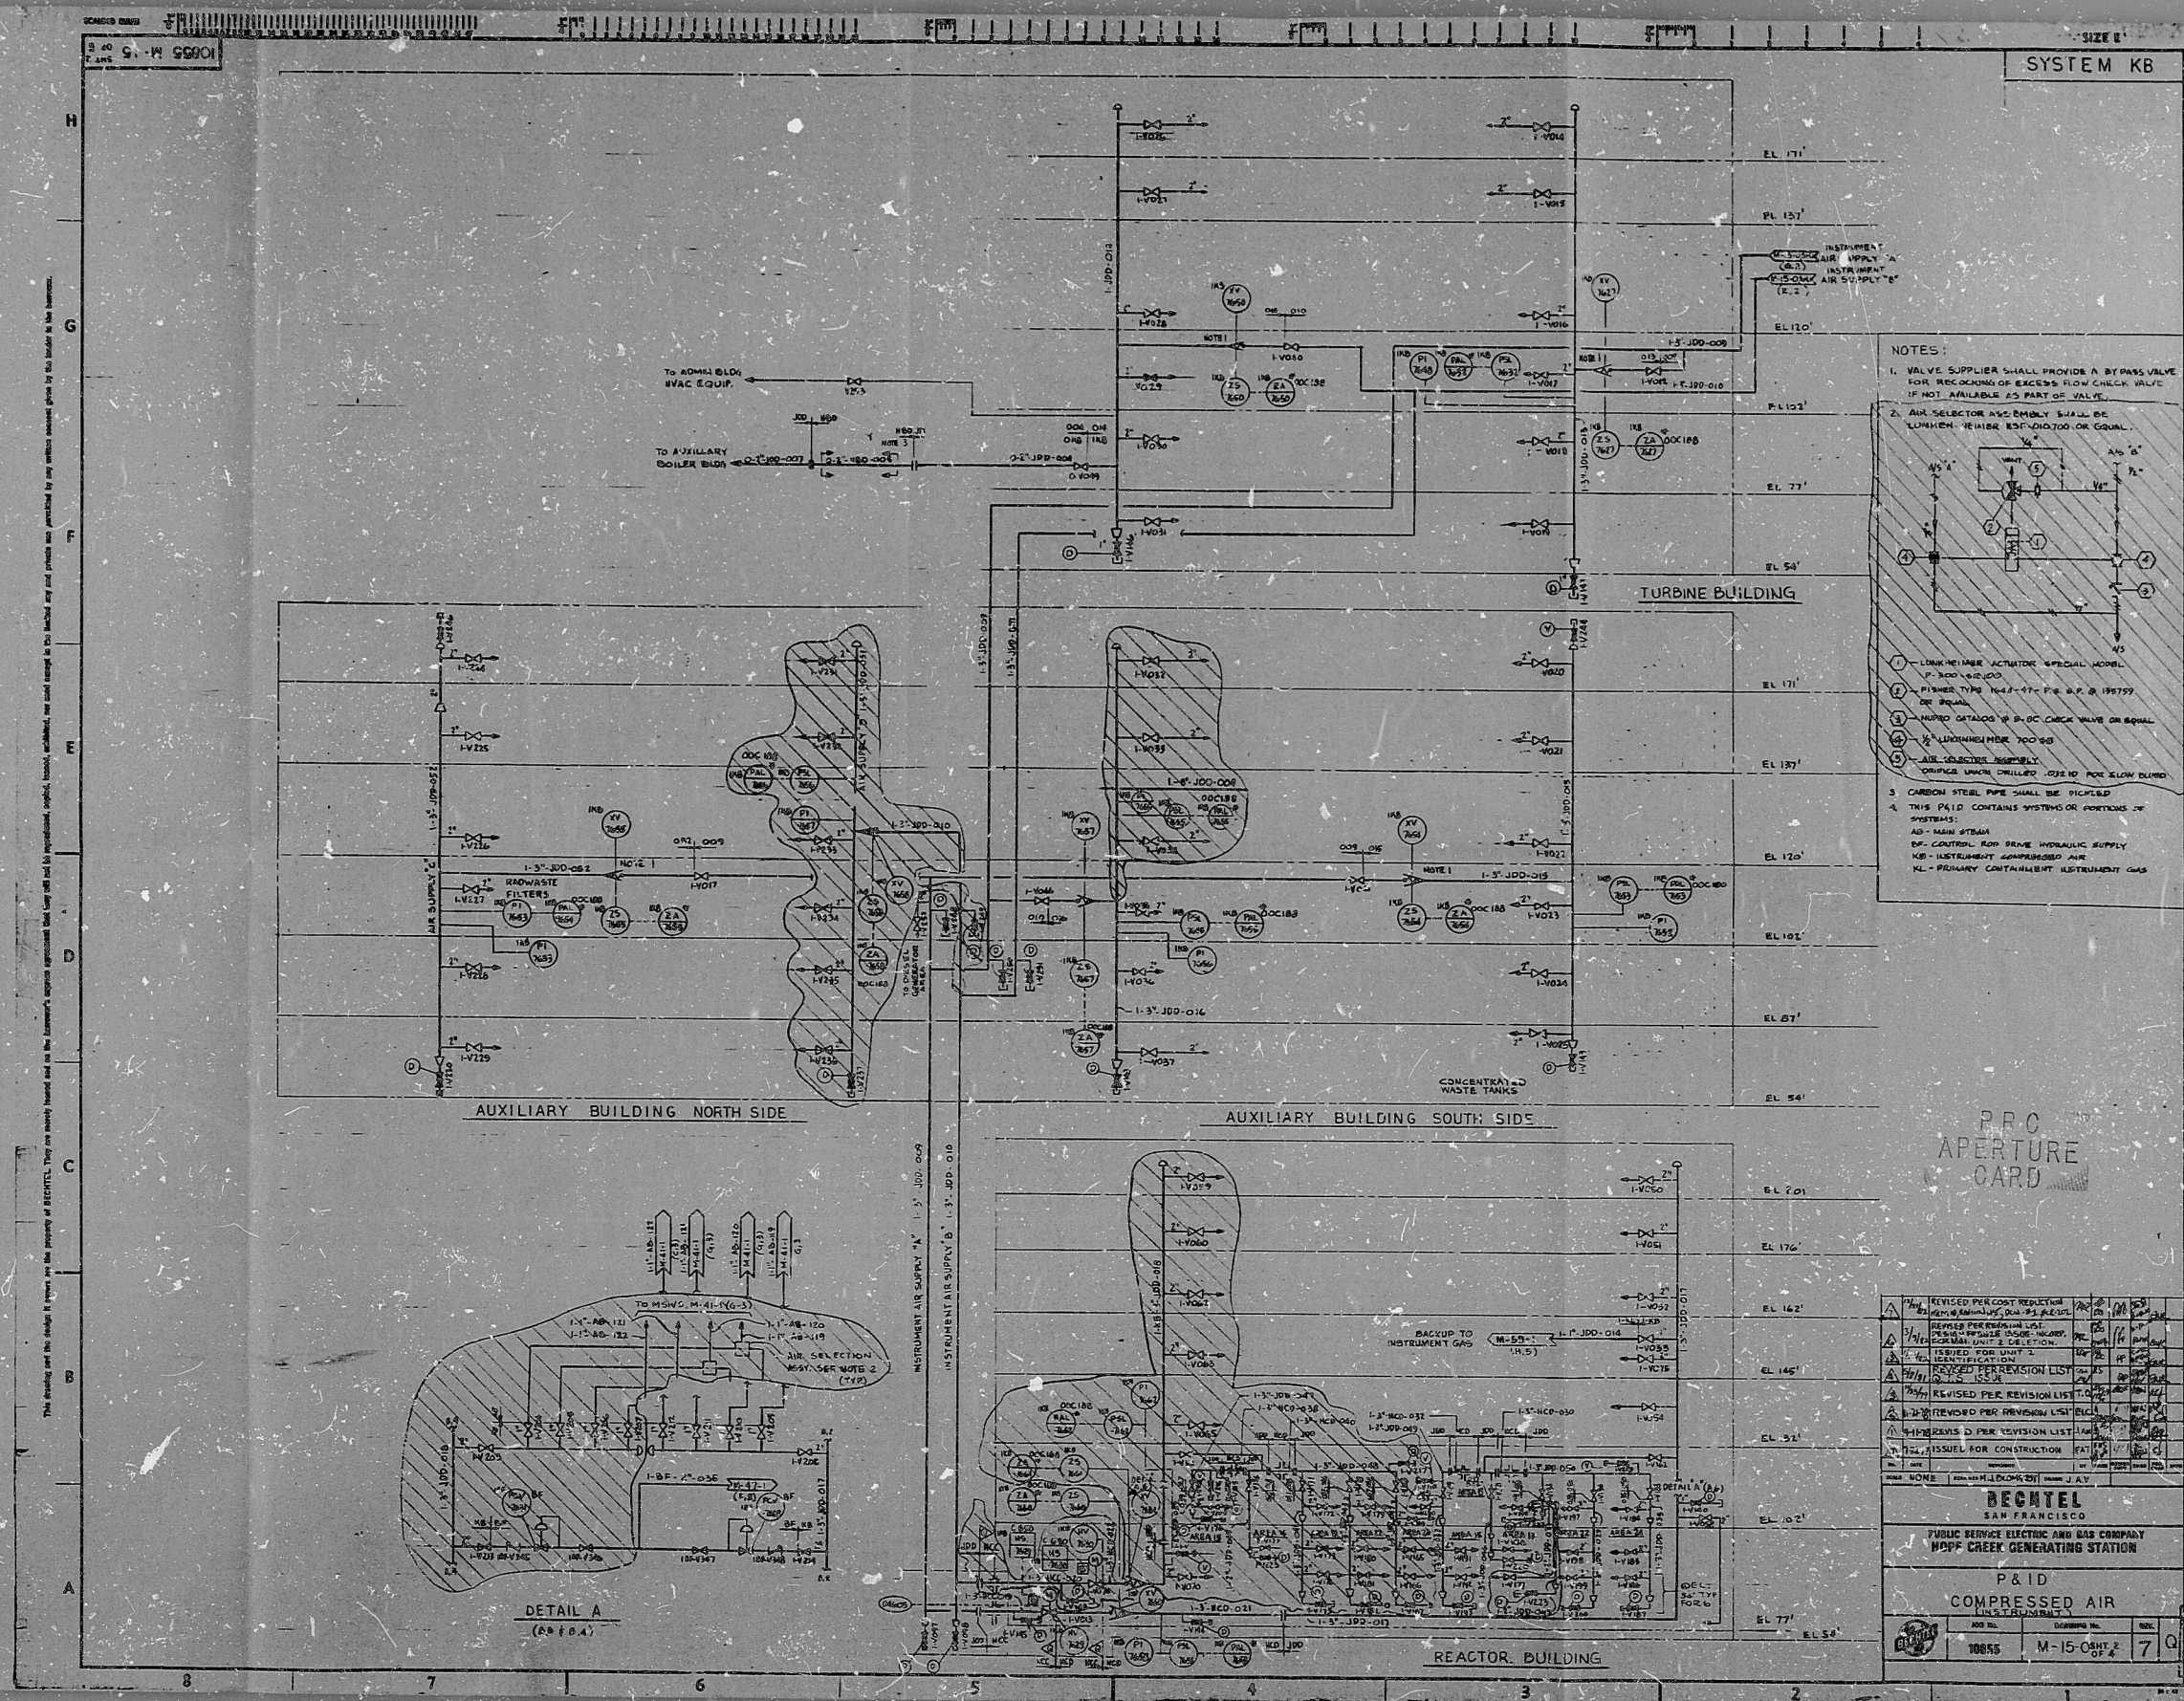