
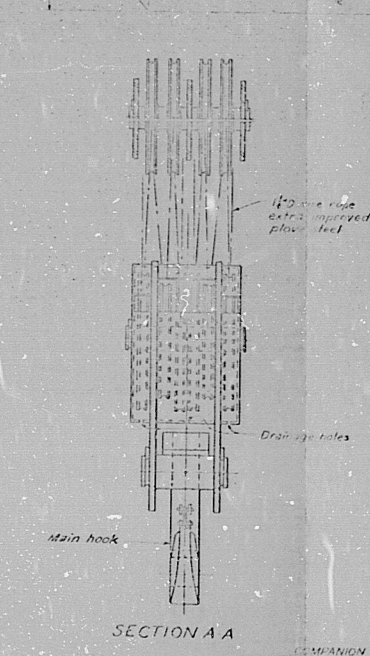
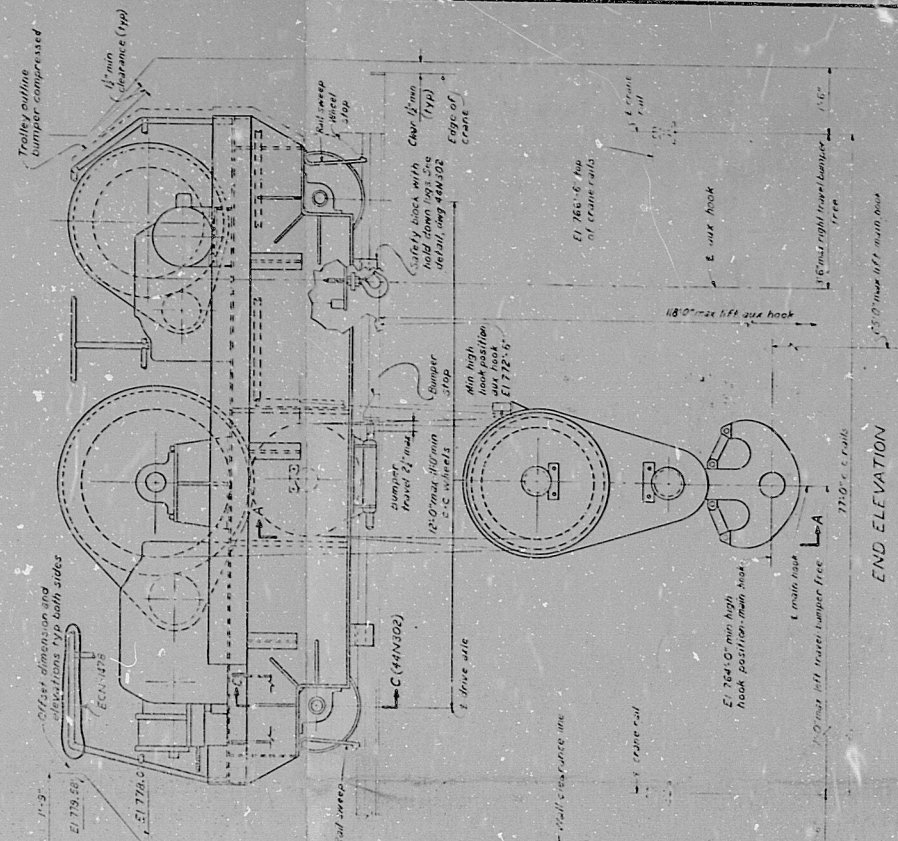
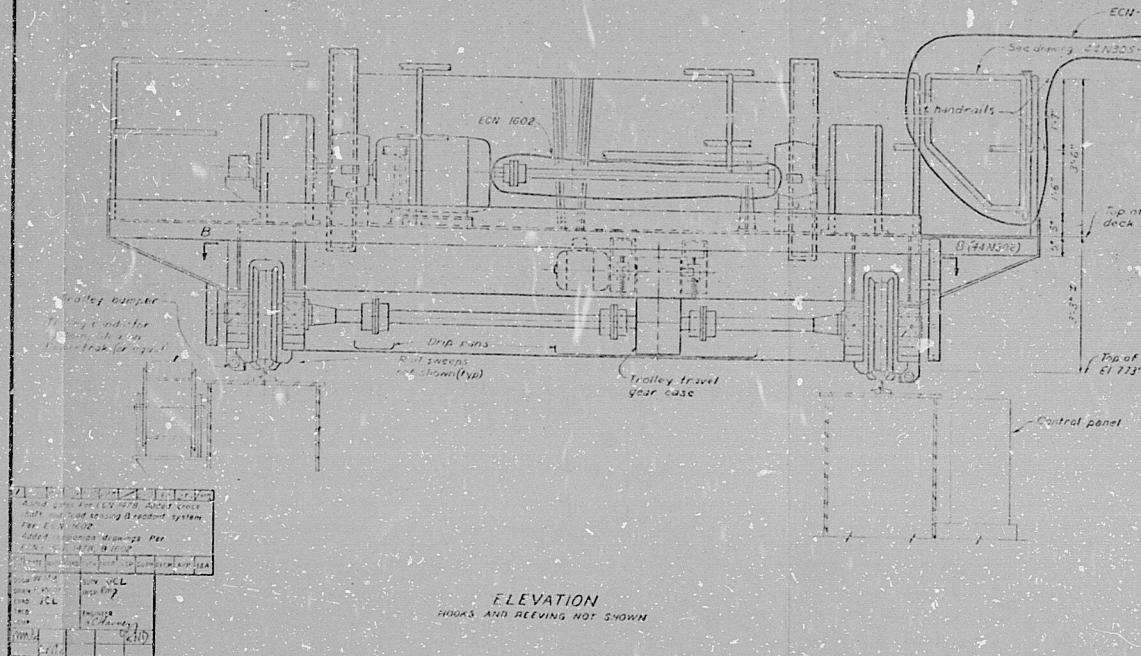


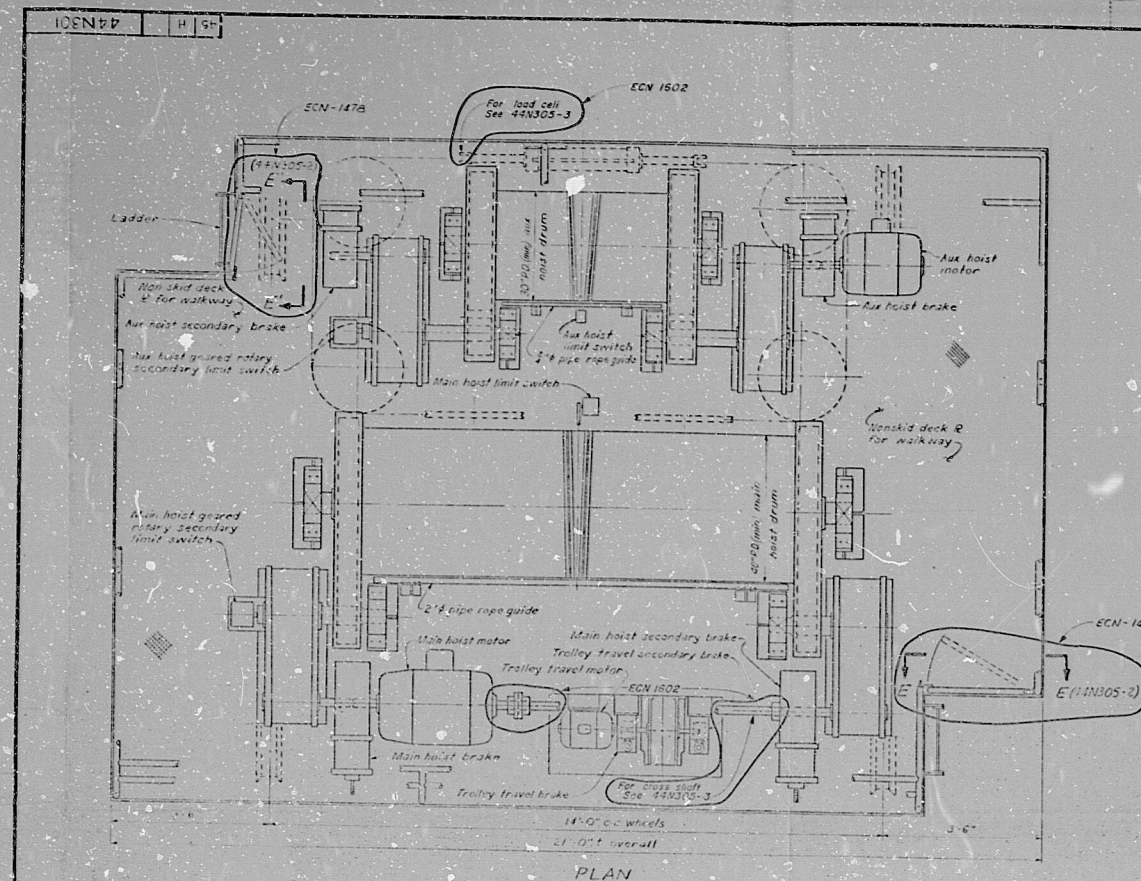

POOR ORIGINAL

- NOTES:
1. MAIN HOIST REEVEING, 12 PARTS OF 1-1/4" WIRE ROPES, EXTRA IMPROVED PLOW STEEL, SEE SPECIFICATIONS.
 2. AUXILIARY HOIST REEVEING, DIRECT LIFT WITH STEEL, 7/8" WIRE ROPES, EXTRA IMPROVED PLOW STEEL, SEE SPECIFICATIONS.
 4. FOR DRIP PAN, SEE SPECIFICATIONS.
 5. FOR GENERAL MAINTENANCE OF CRANE, SEE 444100.

APERTURE CARD

AUXILIARY BUILDING UNITS 1 & 2	
125-TON CRANE TROLLEY ARRANGEMENT	
SEQUOYAH NUCLEAR PLANT TENNESSEE VALLEY AUTHORITY DIVISION OF ENGINEERING DESIGN	
SUBMITTED ECN 1478 100 4,300-0	RECOMMENDED J.B. Williams S. Kline KNOXVILLE 3-17-71 410 301 41
THIS DRAWING IS UNDER CONFIGURATION CONTROL	

8203040515

PHOTOGRAPHED
IN KNOXVILLE

30V

RIDS

8203040515

