


This drawing and the design it covers are the property of BECHTEL. They are merely loaned and on the borrower's express agreement that they will not be reproduced, copied, loaned, exhibited, nor used except in the limited way and private use permitted by any written consent given by the lender to the borrower.

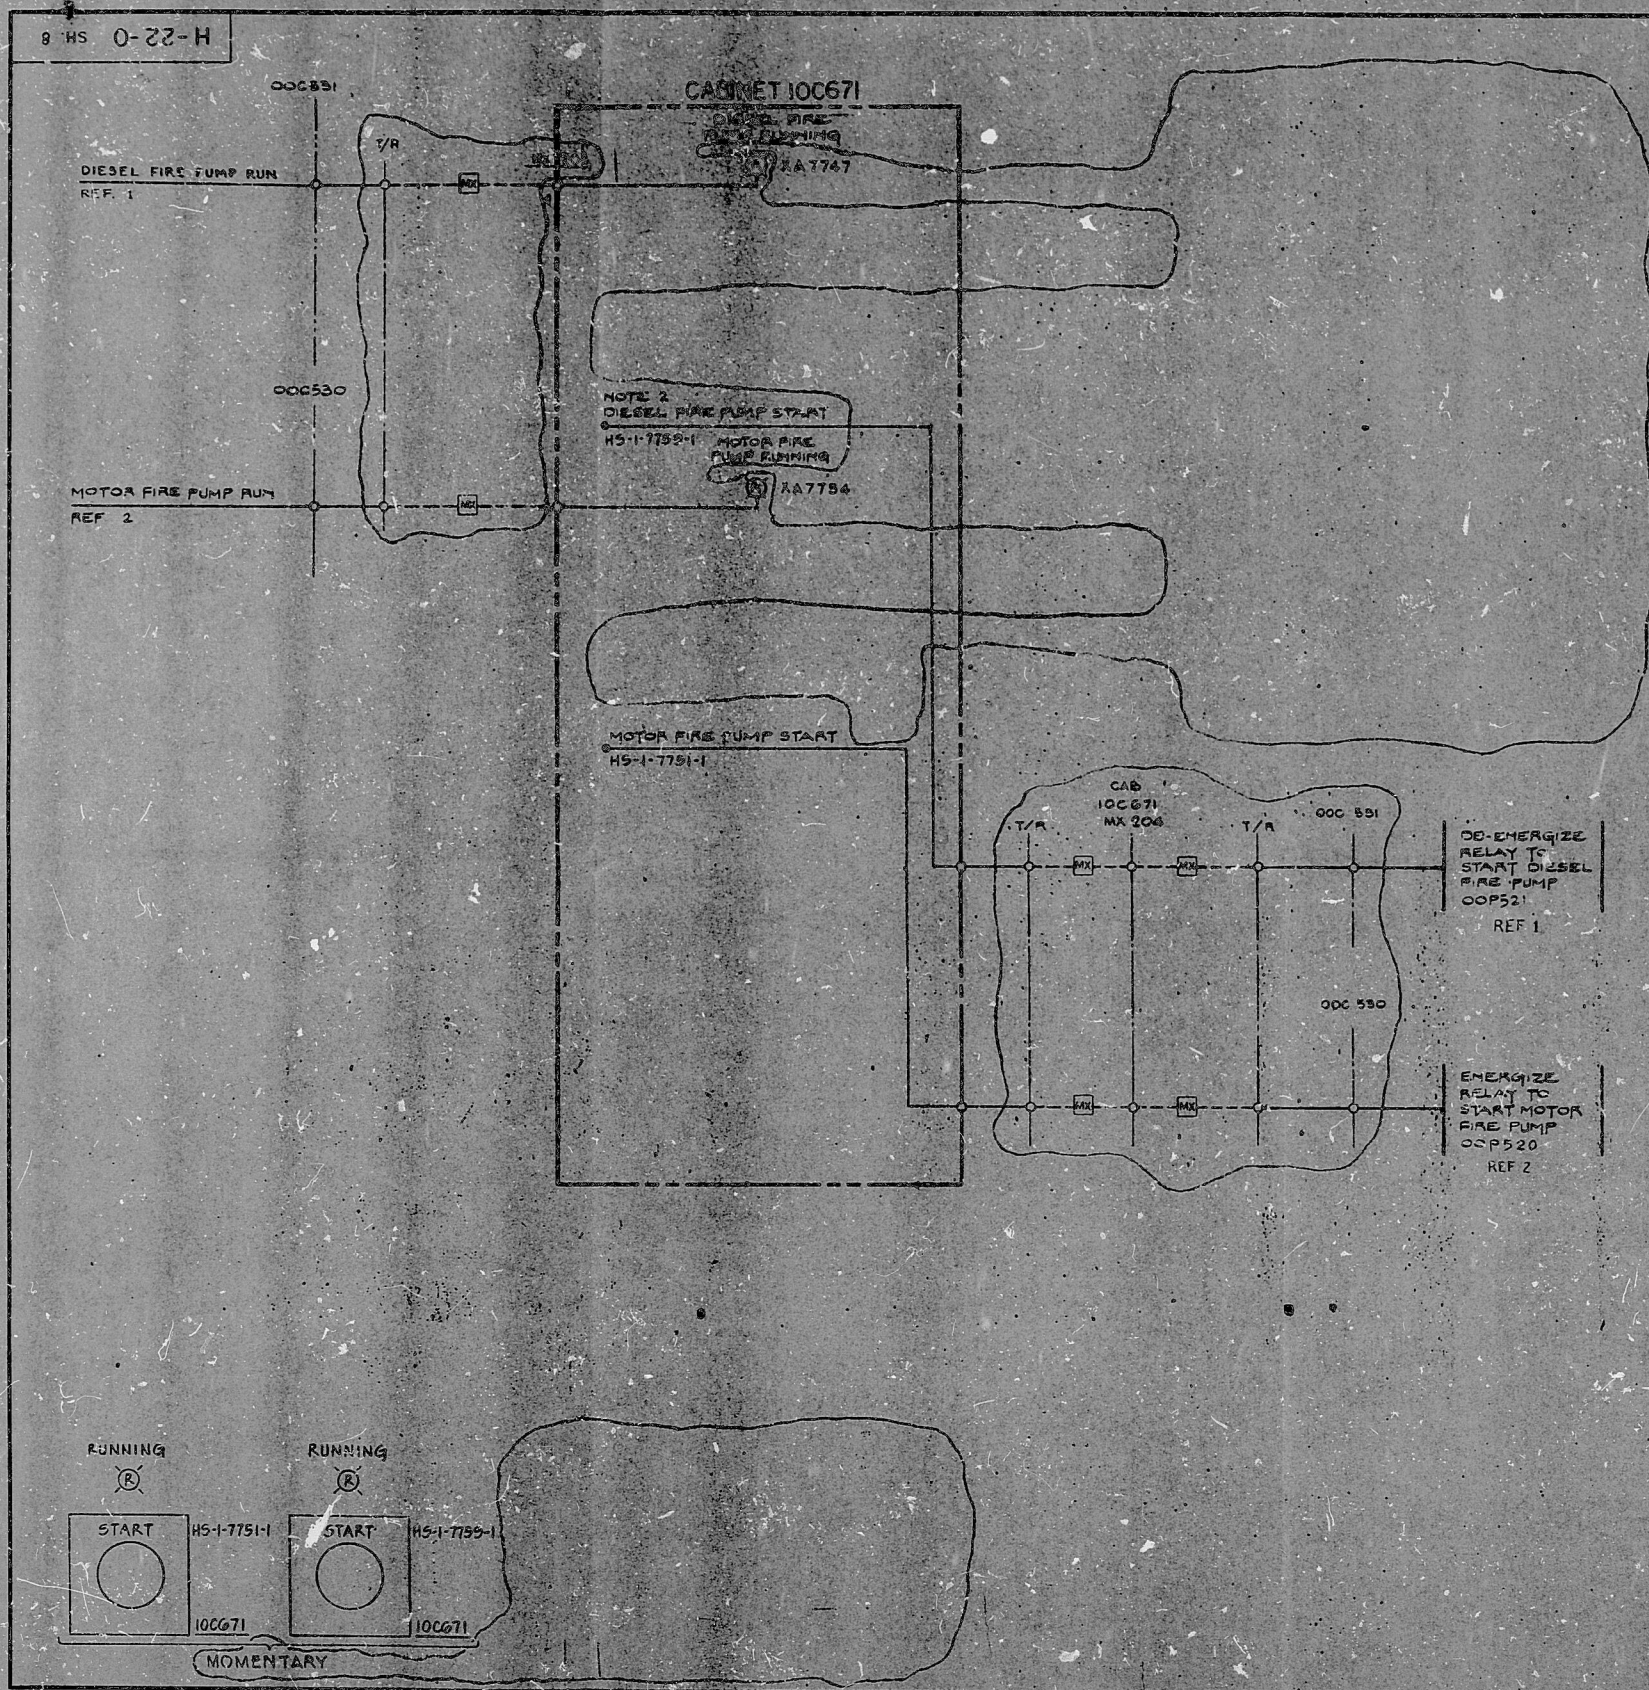

- NOTES**
1. DIESEL FIRE PUMP CONTROL CIRCUIT OPERATES AT 12 VDC.
 2. DIESEL FIRE PUMP START PUSHBUTTON IS NORMALLY CLOSED, OPEN TO START.

- REFERENCES**
1. SCHEMATIC WIRING DIAGRAM FOR MODEL 65C CONTROL, NS 76-01-0853, (BECHTEL DWG. 10055-MG60-33).
 2. SCHEMATIC WIRING DIAGRAM FOR MODEL FTA 1000, NL 0501-07, (BECHTEL DWG. 10055-MG60-36).

REVISION		DATE	BY	CHKD	APPD	REVISION	DATE	BY	CHKD	APPD

RIDS

8308080264

