


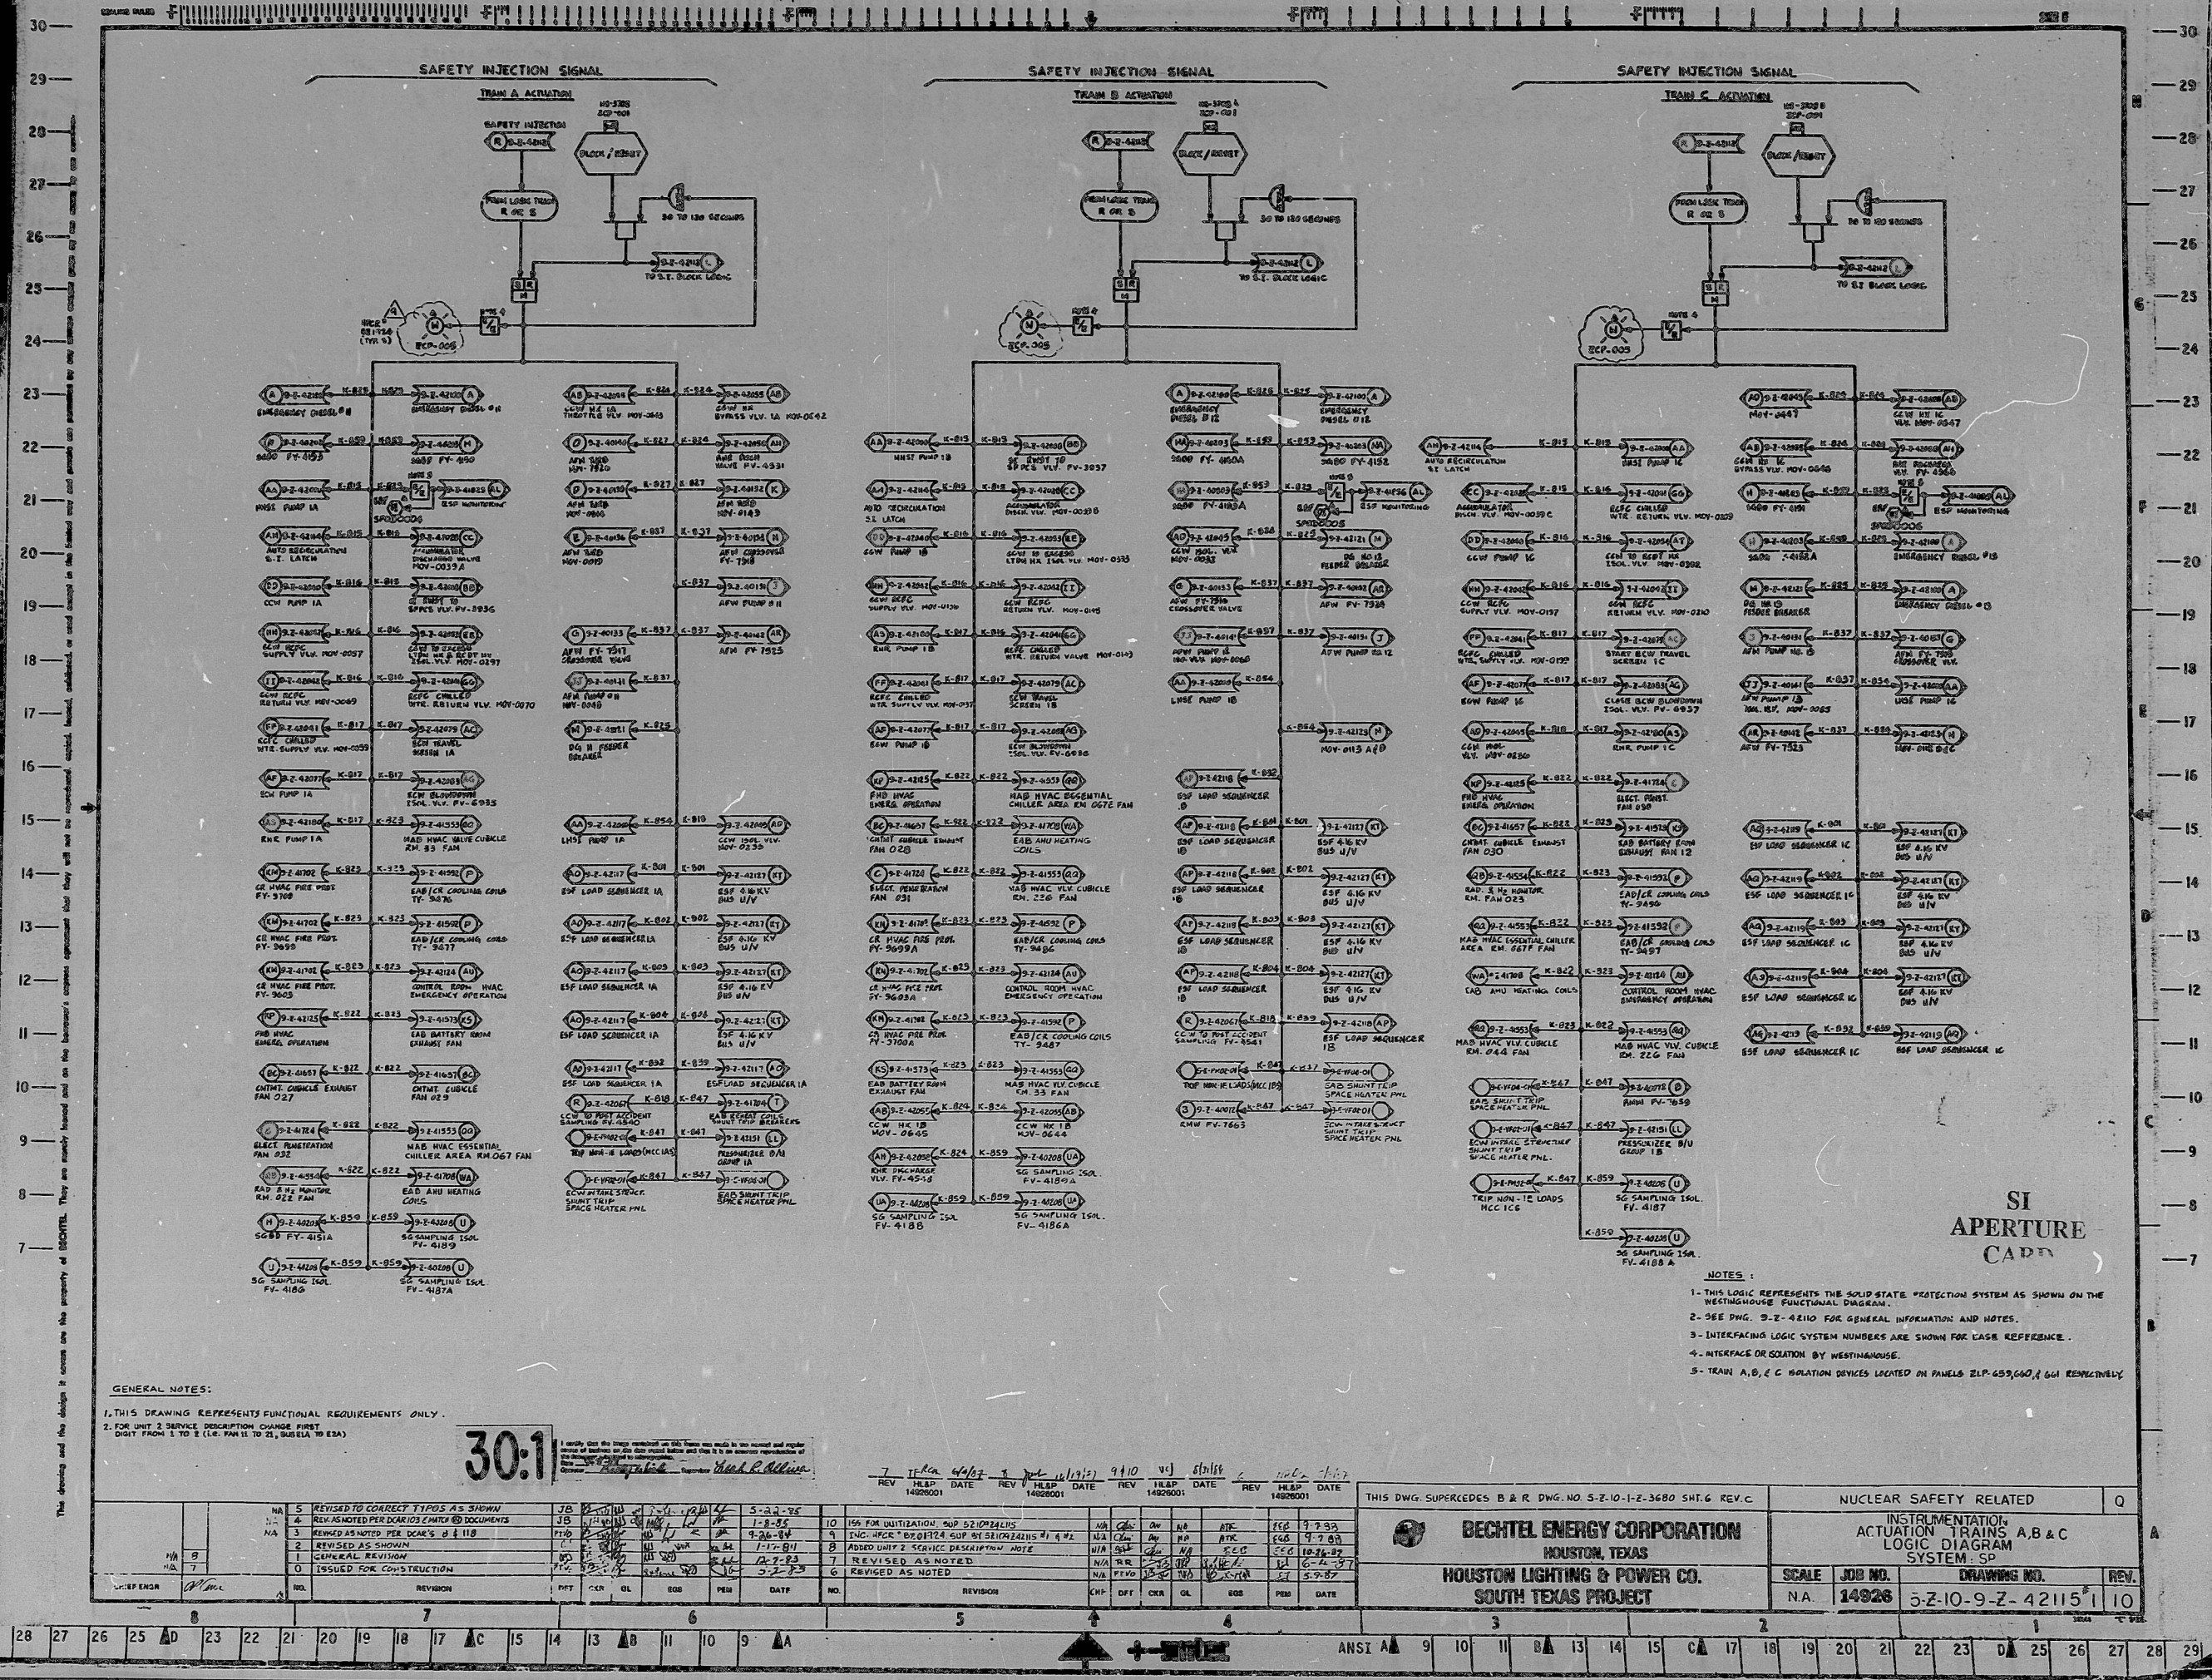

8907310167

PDR RIDS

