


9-2-42124

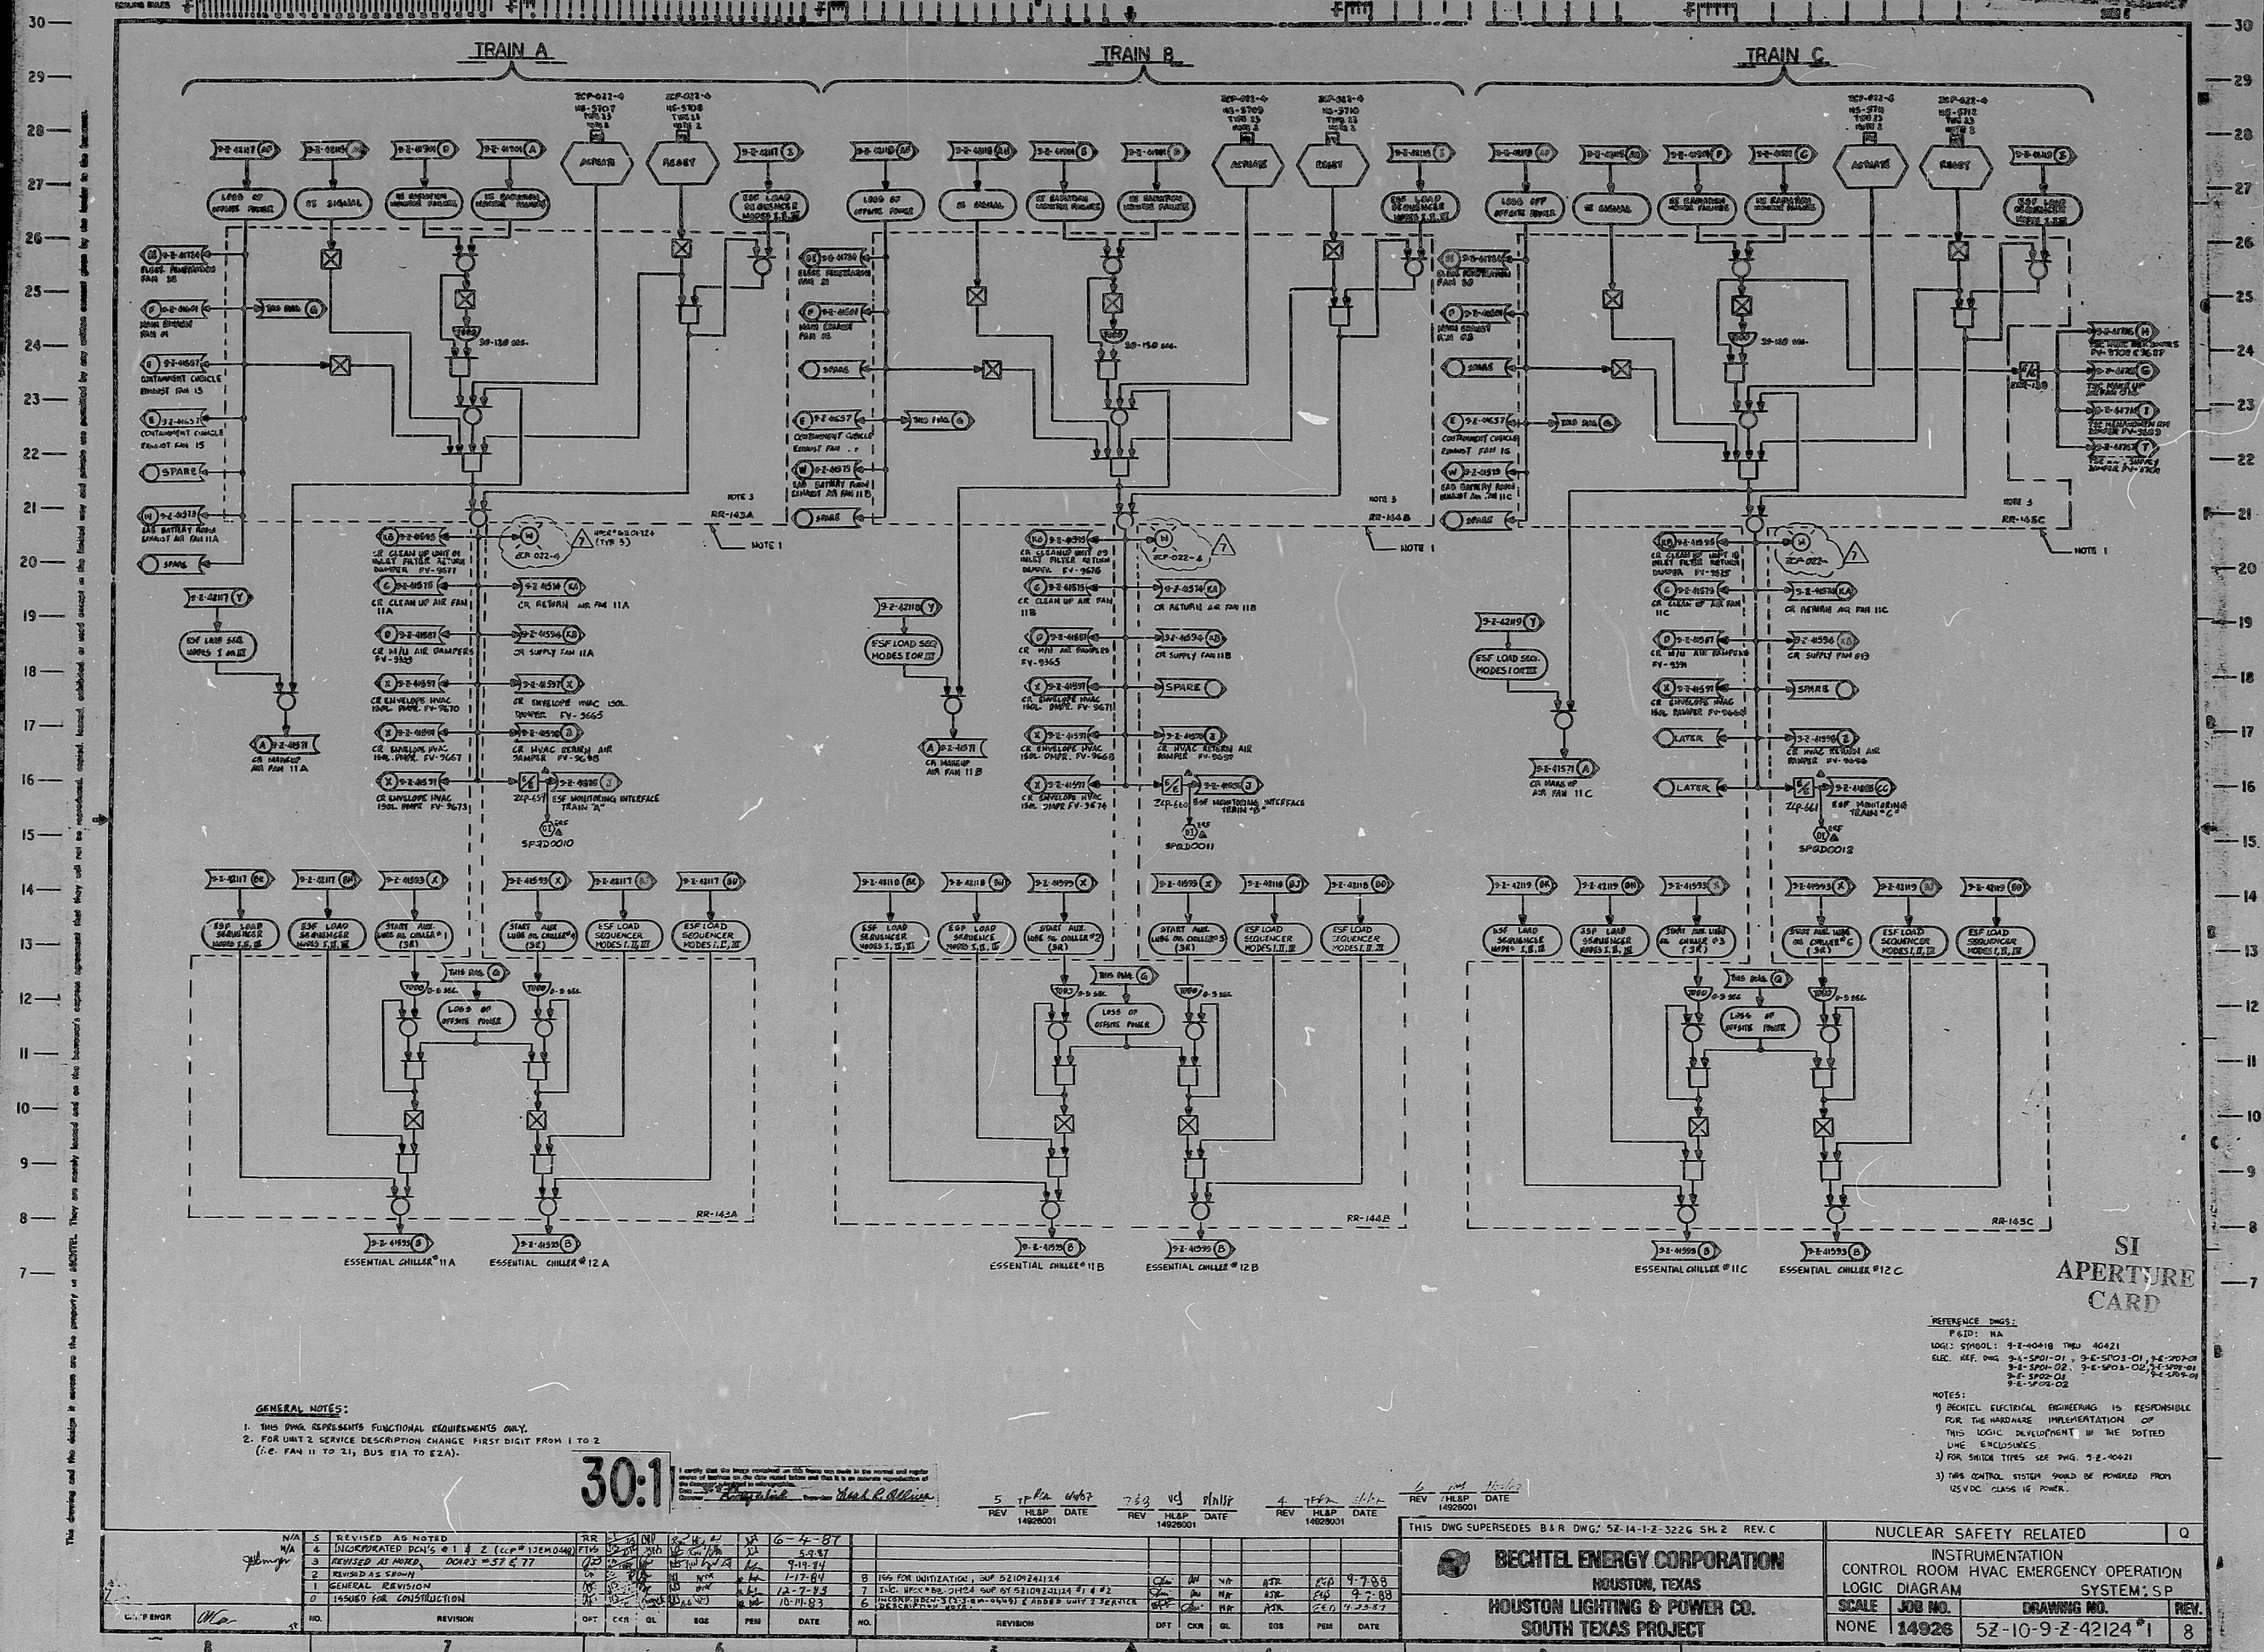

8907310225

PDR RIDS

