
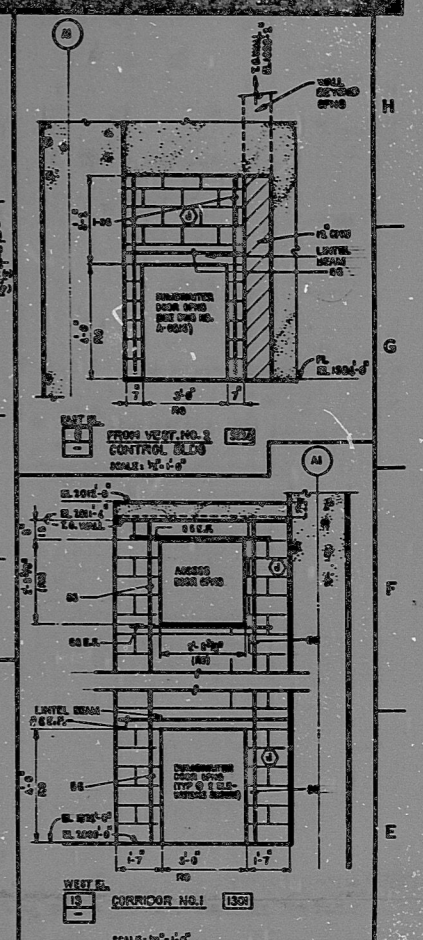
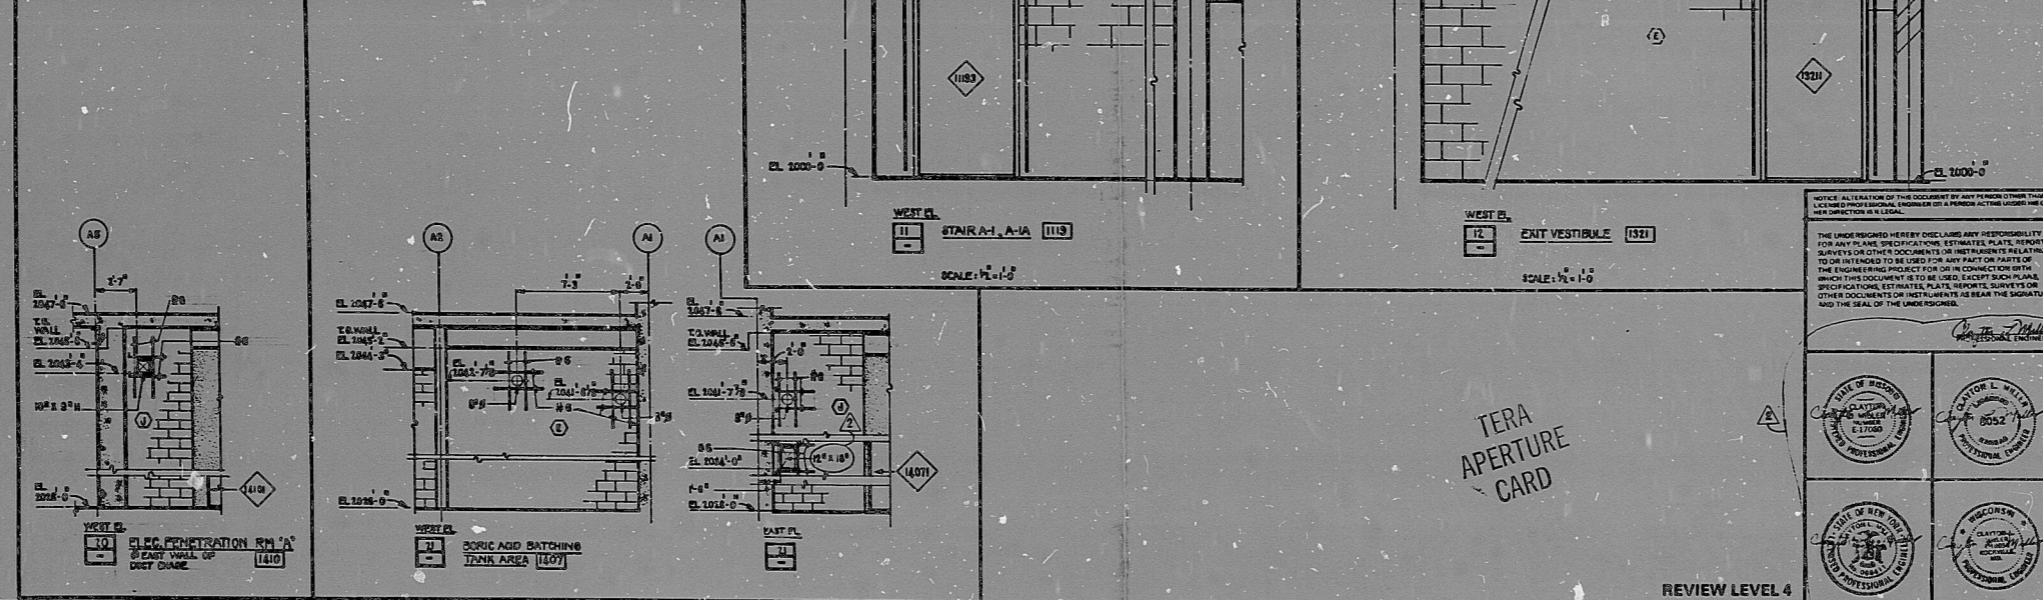
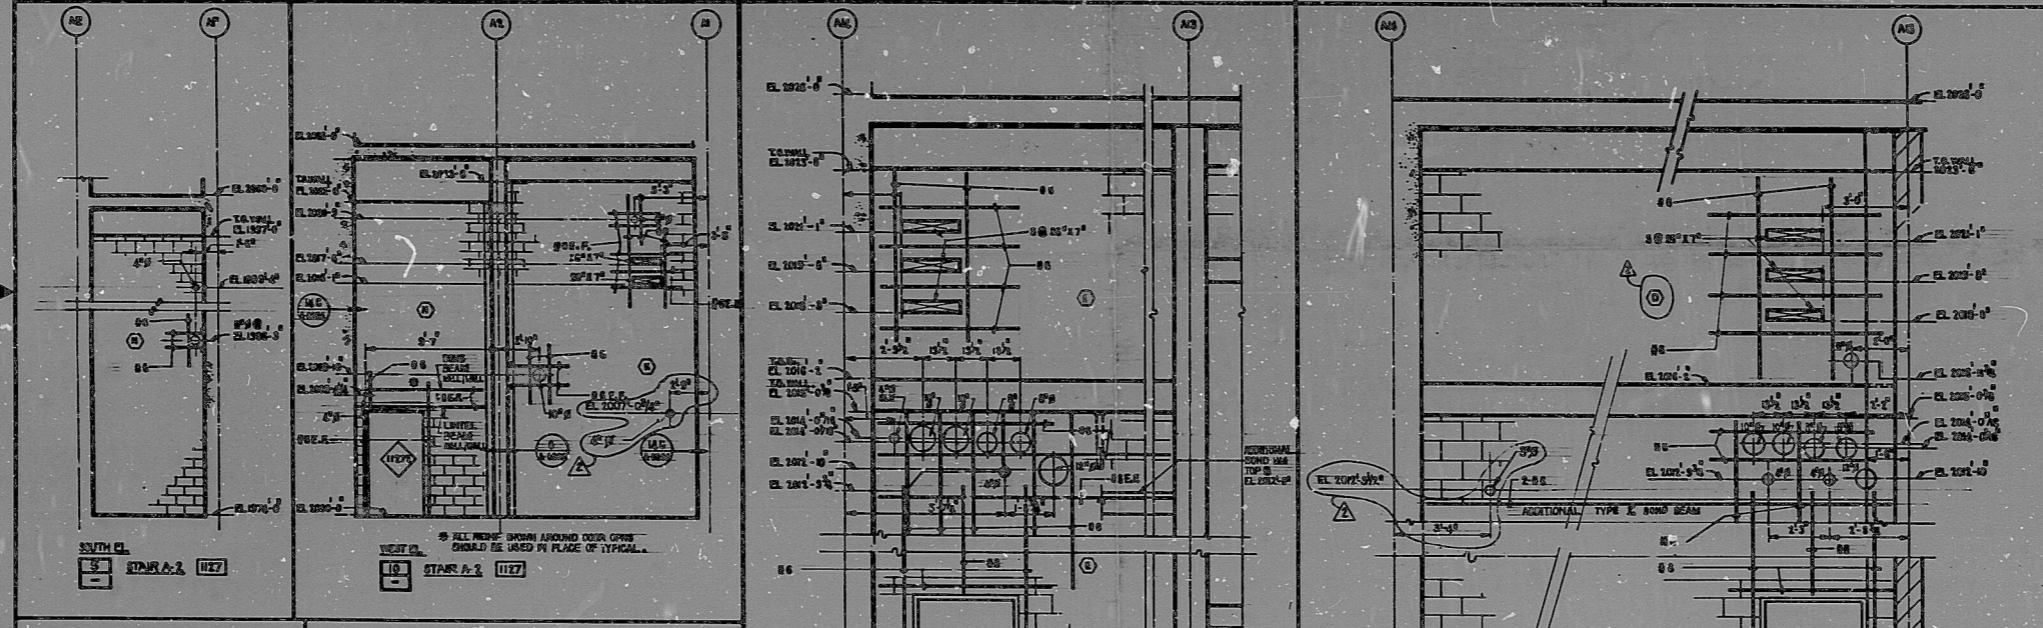


**A-0360-001 WALL PENETRATIONS  
AUXILIARY BUILDING**


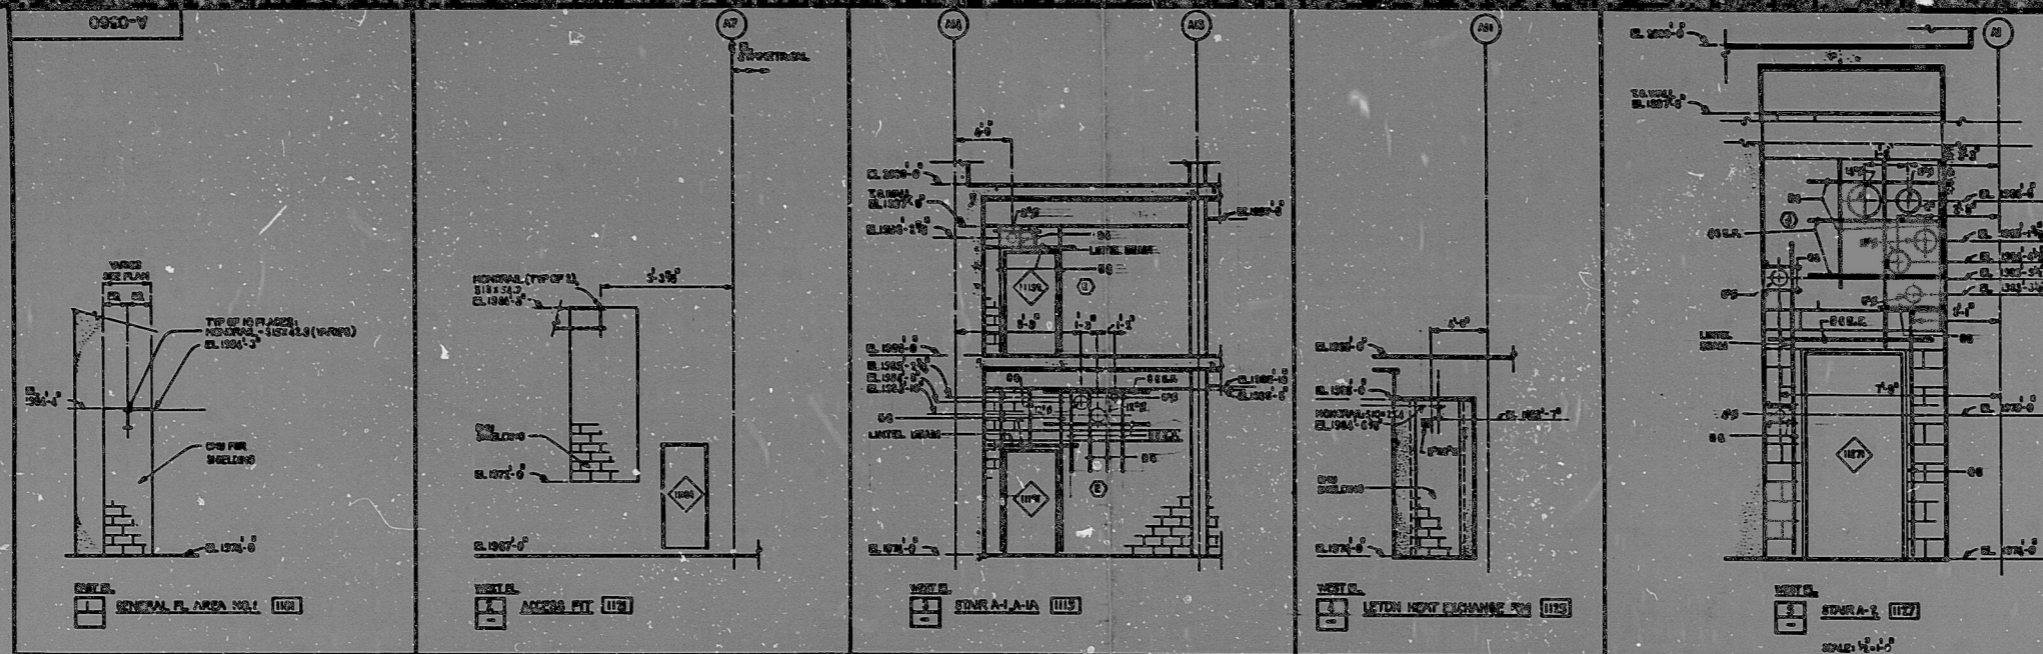

- NOTES:**
- FOR GENERAL NOTES, LEGENDS & SYMBOLS, SEE DWG NO. A-0360.
  - FOR GENERAL MATERIALS & SCHEDULES, SEE DWG NO. A-0360 & A-0361.
  - REINFORCING BARS EXTENDING UP OR DOWN SHOULD BE TYPICAL UNLESS OTHERWISE SHOWN.
  - ALL REINFORCING SHOULD BE IN ACCORDANCE WITH TYPICAL WALL REINFORCING.
  - ALL HOLES SHOWN ARE STANDARD SIZE HOLES.
  - ALL HOLES, UNLESS OTHERWISE SHOWN, SHALL BE REINFORCED ACCORDING TO DWG NO. A-0361.
  - WHERE SUPPLEMENTAL REBAR IS SHOWN AS NOTED HEREIN, CONSIDER WITH LOCATION OF THE TYPICAL REBAR, ONLY THE TYPICAL REINFORCING IS REQUIRED (UNLESS OTHERWISE SHOWN).
  - AT THE CONCRETE OPTION BLOCK SCALES SHOWN ON THIS DRAWING MAY BE CHANGED TO REINFORCED CONCRETE. U.S.A. DETAILS FOR REINFORCED CONCRETE SHALL BE AS SHOWN ON DRAWING NO. A-0362 & A-0363.

**REF DWGS:**  
 ARCHITECTURAL: A-0361, -0362, -0363, -0364, -0365 - FL. PLANS  
 A-0366, -0367, -0368 - MASONRY DETS


**BECHTEL**  
 SAN FRANCISCO, CALIFORNIA

**SNUPPS**  
 ARCHITECTURAL  
 CMU WALL PENETRATIONS  
 AUXILIARY BUILDING

JOB NO. 10466      REVISION NUMBER 2


TERA  
 APERTURE  
 CARD

125000000



PDR

8007300521

