
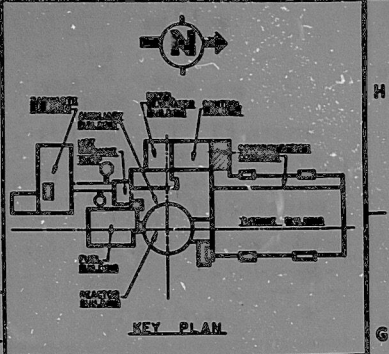
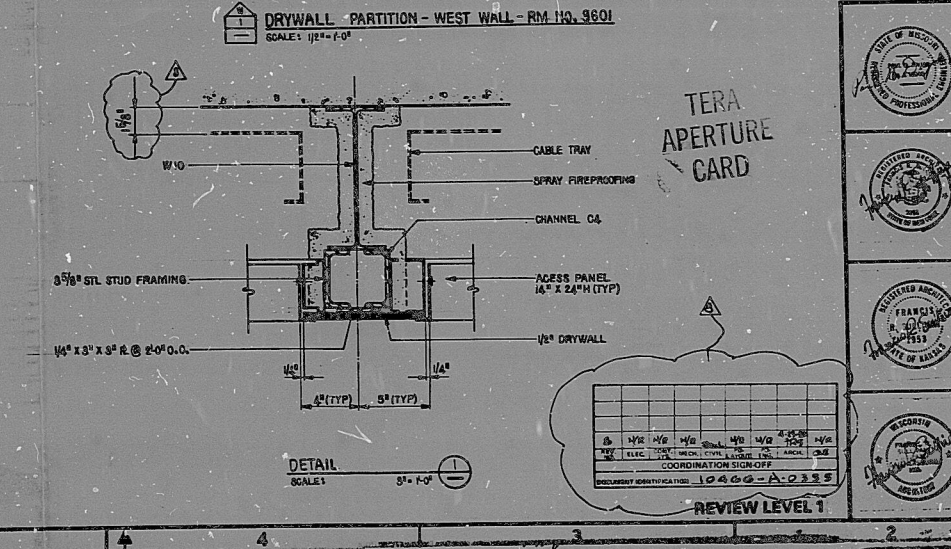
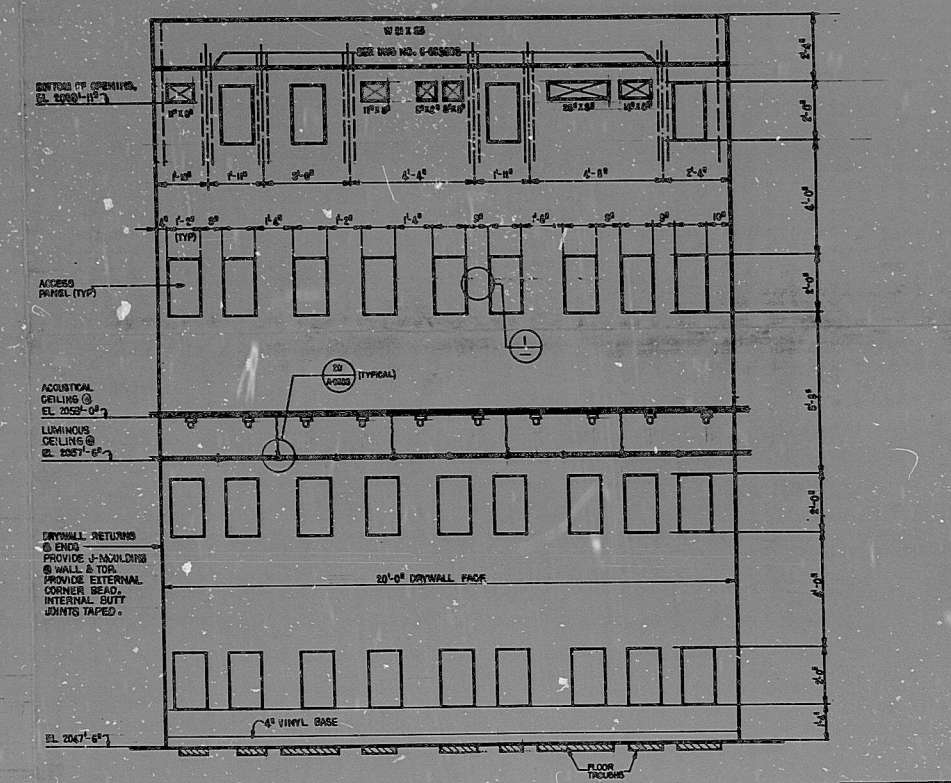
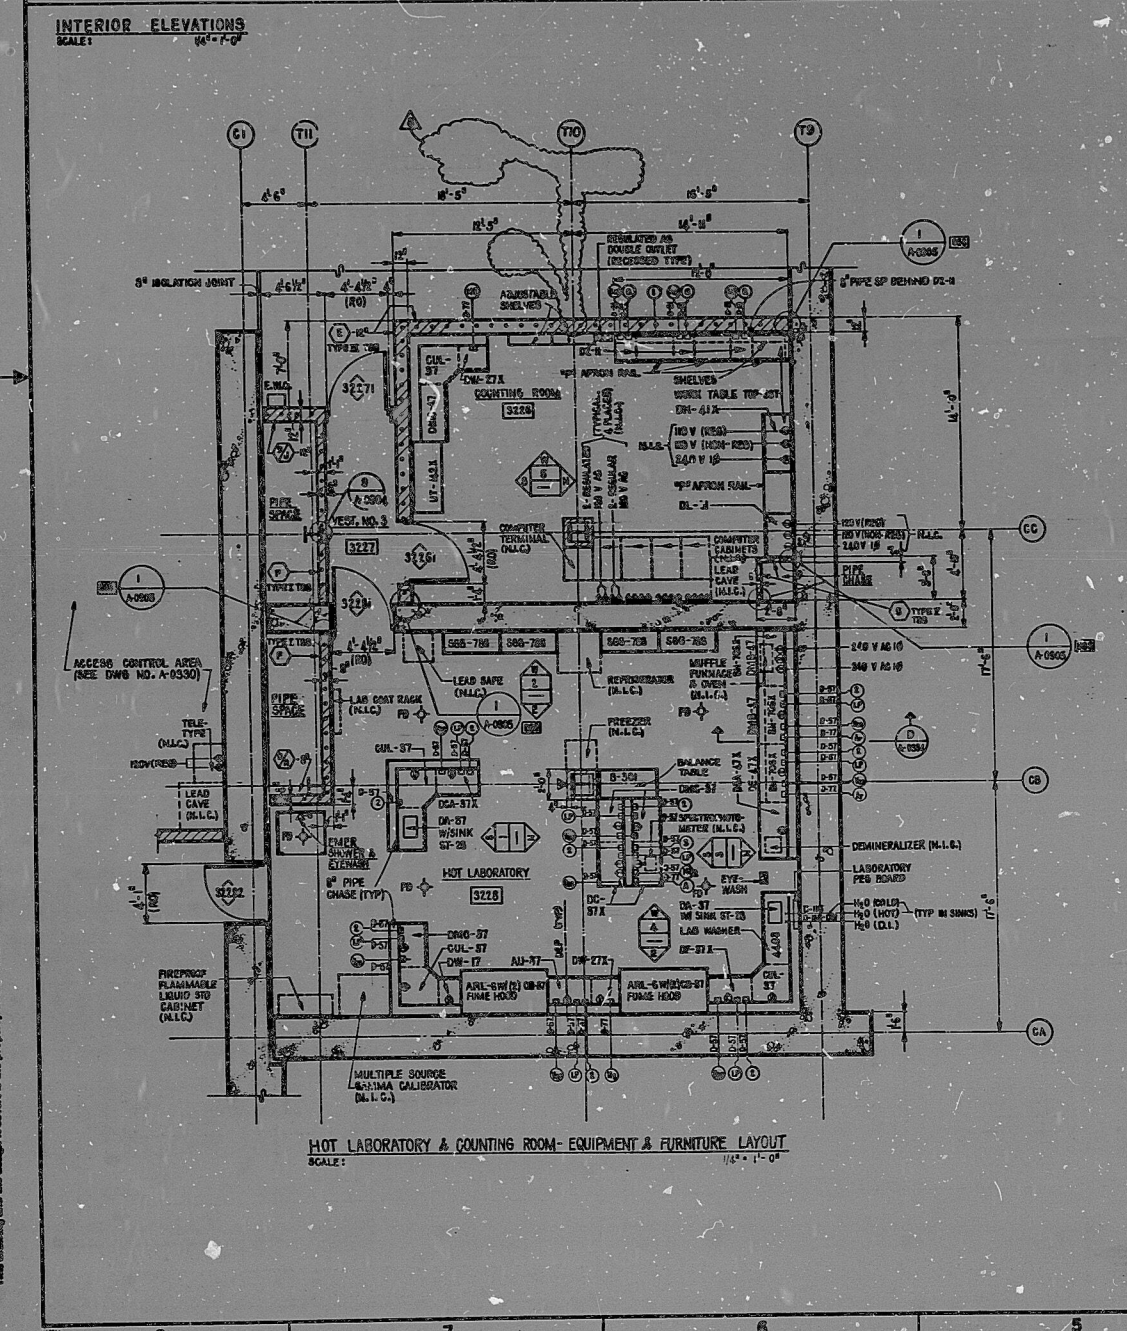




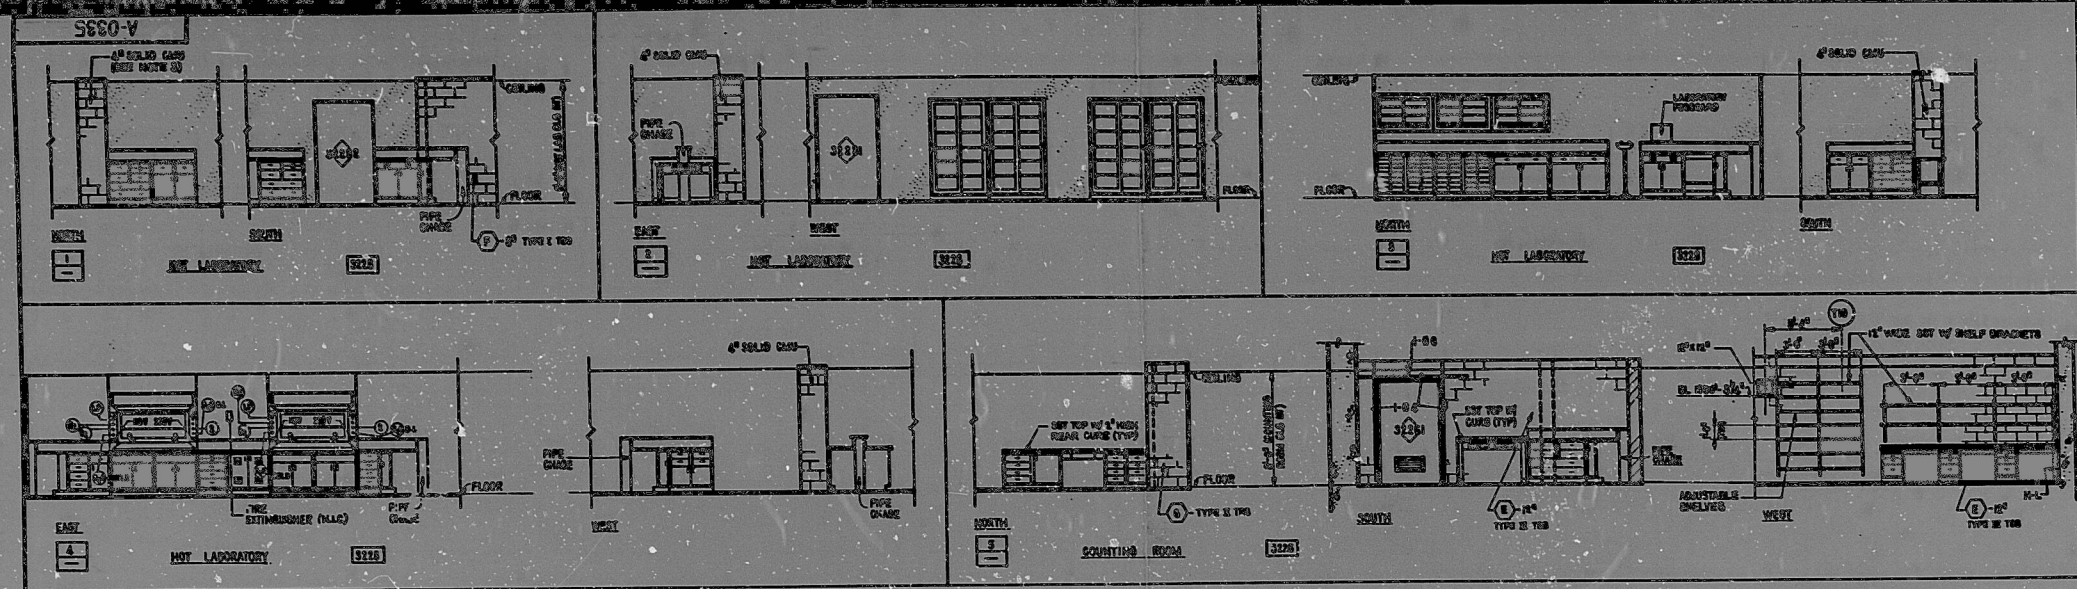

**NOTES**

- FOR GENERAL NOTES, SEE DRAWING NO. A-0331.
- ALL CURB WALLS SHOULD BE 8\"/>
- SEE SCHEDULE A-0335 FOR FINISH SCHEDULE.
- FOR GENERAL LABORATORY, COUNTING ROOM SCHEDULES, SEE DRAWING NO. A-0335.

**LEGEND**

- ① - ACCESS (NOT ON LAZE IS SHOWN REARER)
- ② - METRIC GAUGE
- ③ - WINDOW
- ④ - DOOR
- ⑤ - PARTITION
- ⑥ - CEILING CAS
- ⑦ - ELECTRICAL OUTLET (LIMITED W/AL OUTLETS SUPPLY (W/AL OUT)
- ⑧ - ELECTRICAL OUTLET (120 V AS W/AL) NO DEP
- ⑨ - TELEPHONE OUTLET
- ⑩ - COMPRESSED AIR
- ⑪ - ACETYLENE
- ⑫ - WITTHOUSE
- HL-C - NOT IN CONTRACT, ORDER FURNISHED
- TR - TOP BRUSH (SEE SECTION), SEE SCHEDULE
- DB - END WALL SUPPORT, SEE DETAILS

**REFERENCE DRAWINGS**

- A-0331 - GENERAL BUILDING & COMMUNICATIONS FLOOR PLAN @ EL. 100'-0\"/>
- A-0332 - GENERAL CEILING DETAILS
- A-0333 - DOOR SCHEDULE
- A-0334 - DOOR SCHEDULE
- A-0335 - FINISH SCHEDULE
- A-0336 - FINISH SCHEDULE
- A-0337 - ACCESS ON GEN. AREA, CENTRAL A COMPUTER ROOM, REFLECTOR CEILING PLANS
- C-0339 - CONCRETE HEAT LINE, COMMUNICATIONS CENTER

**NOTES (CONTINUED)**

7. SYMBOL SHOWING AS DUAL X IS VERTICAL REF. Y IS HORIZONTAL REF. SEE SCHEDULE DWS A-0325.

NOTICE: ALTERATION OF THIS DOCUMENT BY ANY PERSON OTHER THAN THE LICENSED ARCHITECT OR ANY PERSON ACTING UNDER THEIR DIRECTION IS ILLEGAL.

**BECHTEL**  
ARCHITECTURAL  
HOT LABORATORY EQUIPMENT & FURNITURE LAYOUT, ELEVATIONS AND DETAILS-EL 100'-0\"/>

NO.	DATE	REVISIONS	BY	CHK	APP
1		REVISED AS NOTED, COORDINATED			
2		APPROVED FOR CONSTRUCTION			
3		REVISED AS NOTED			

**SCALE:** AS SHOWN DATE: 10-20-66 (DESIGNED: 10-20-66) DRAWN: 10-20-66

I certify that the image contained on this frame was made in the normal and proper course of business, on the date listed below and that it is an accurate reproduction of the document(s) submitted to micrographic.

DATE: 10-20-66 OPERATOR: [Signature] SUPERVISOR: [Signature]

30X

800200 562



PDR

8007300562

