


[illegible]

BECHTEL SAN FRANCISCO		
UNIT NO. 1 PILGRIM STATION NO. 600 STON EDISON COMPANY		
NDUIT & TRAY LAYOUT LINE BUILDING - AREA 9 PLAN BELOW EL.23'-0"		
200 No. 5498	DRAWING No. E-327	STY. E2

PDR.

8008210387

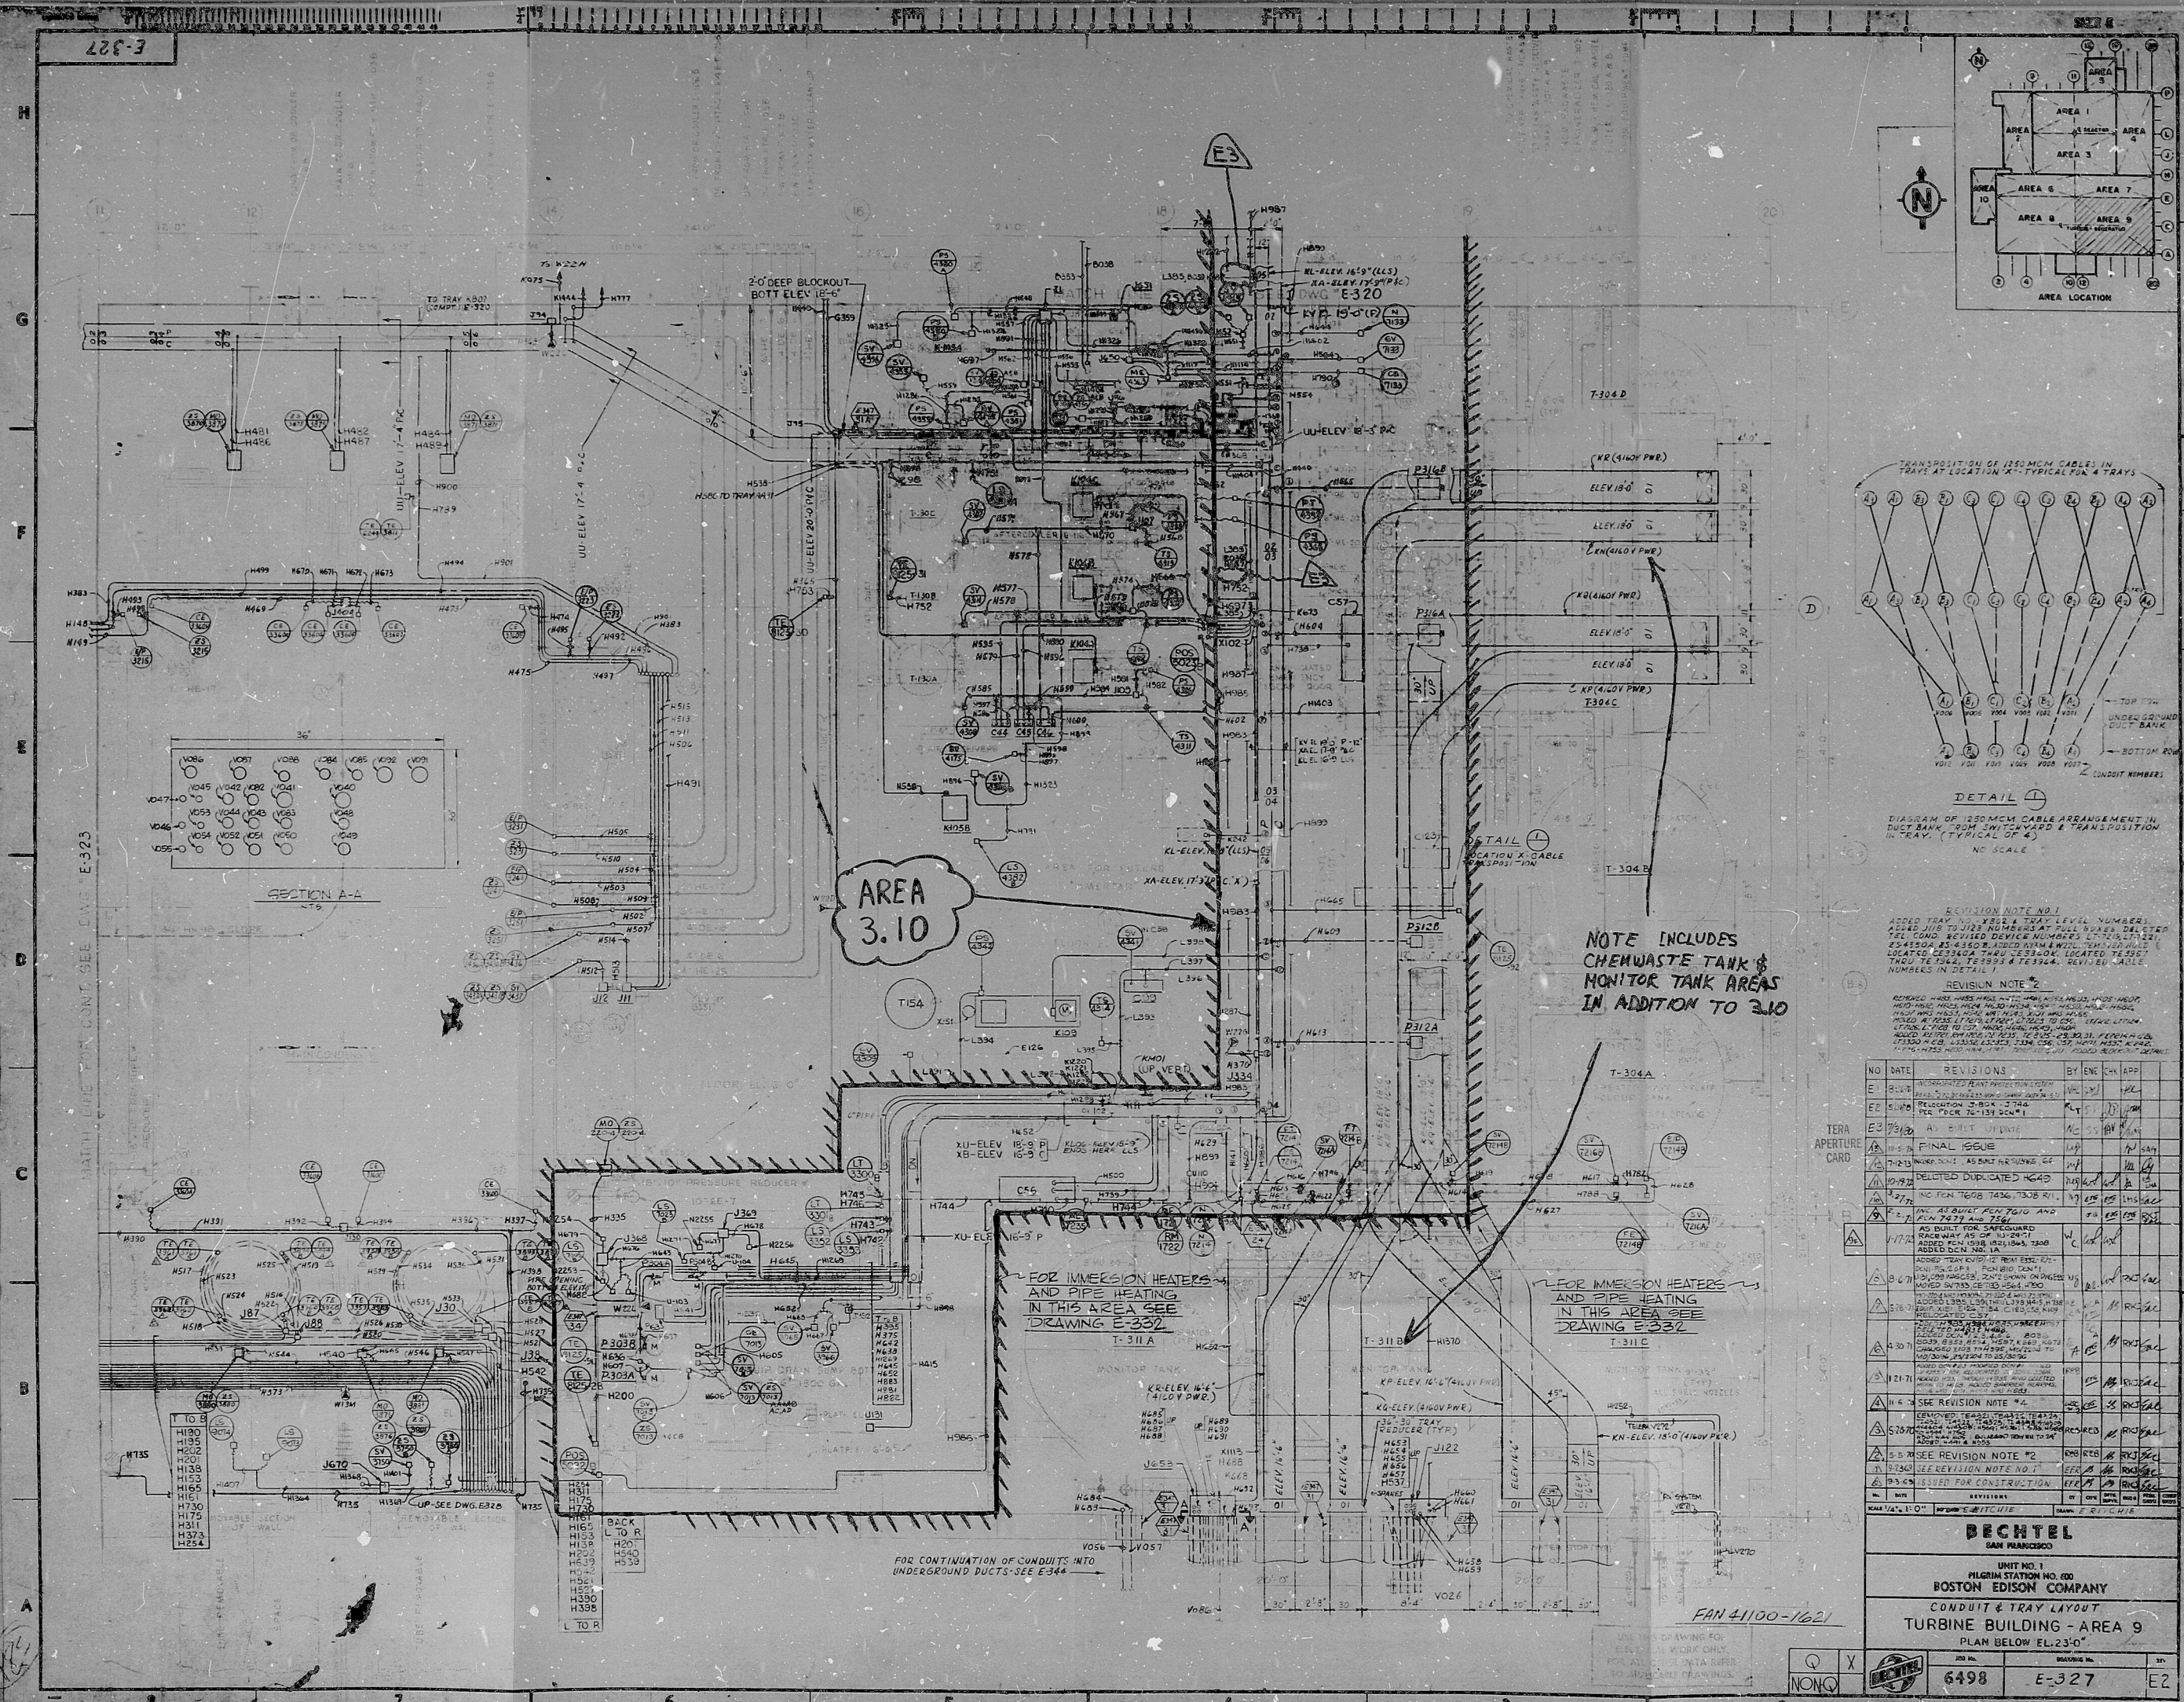