


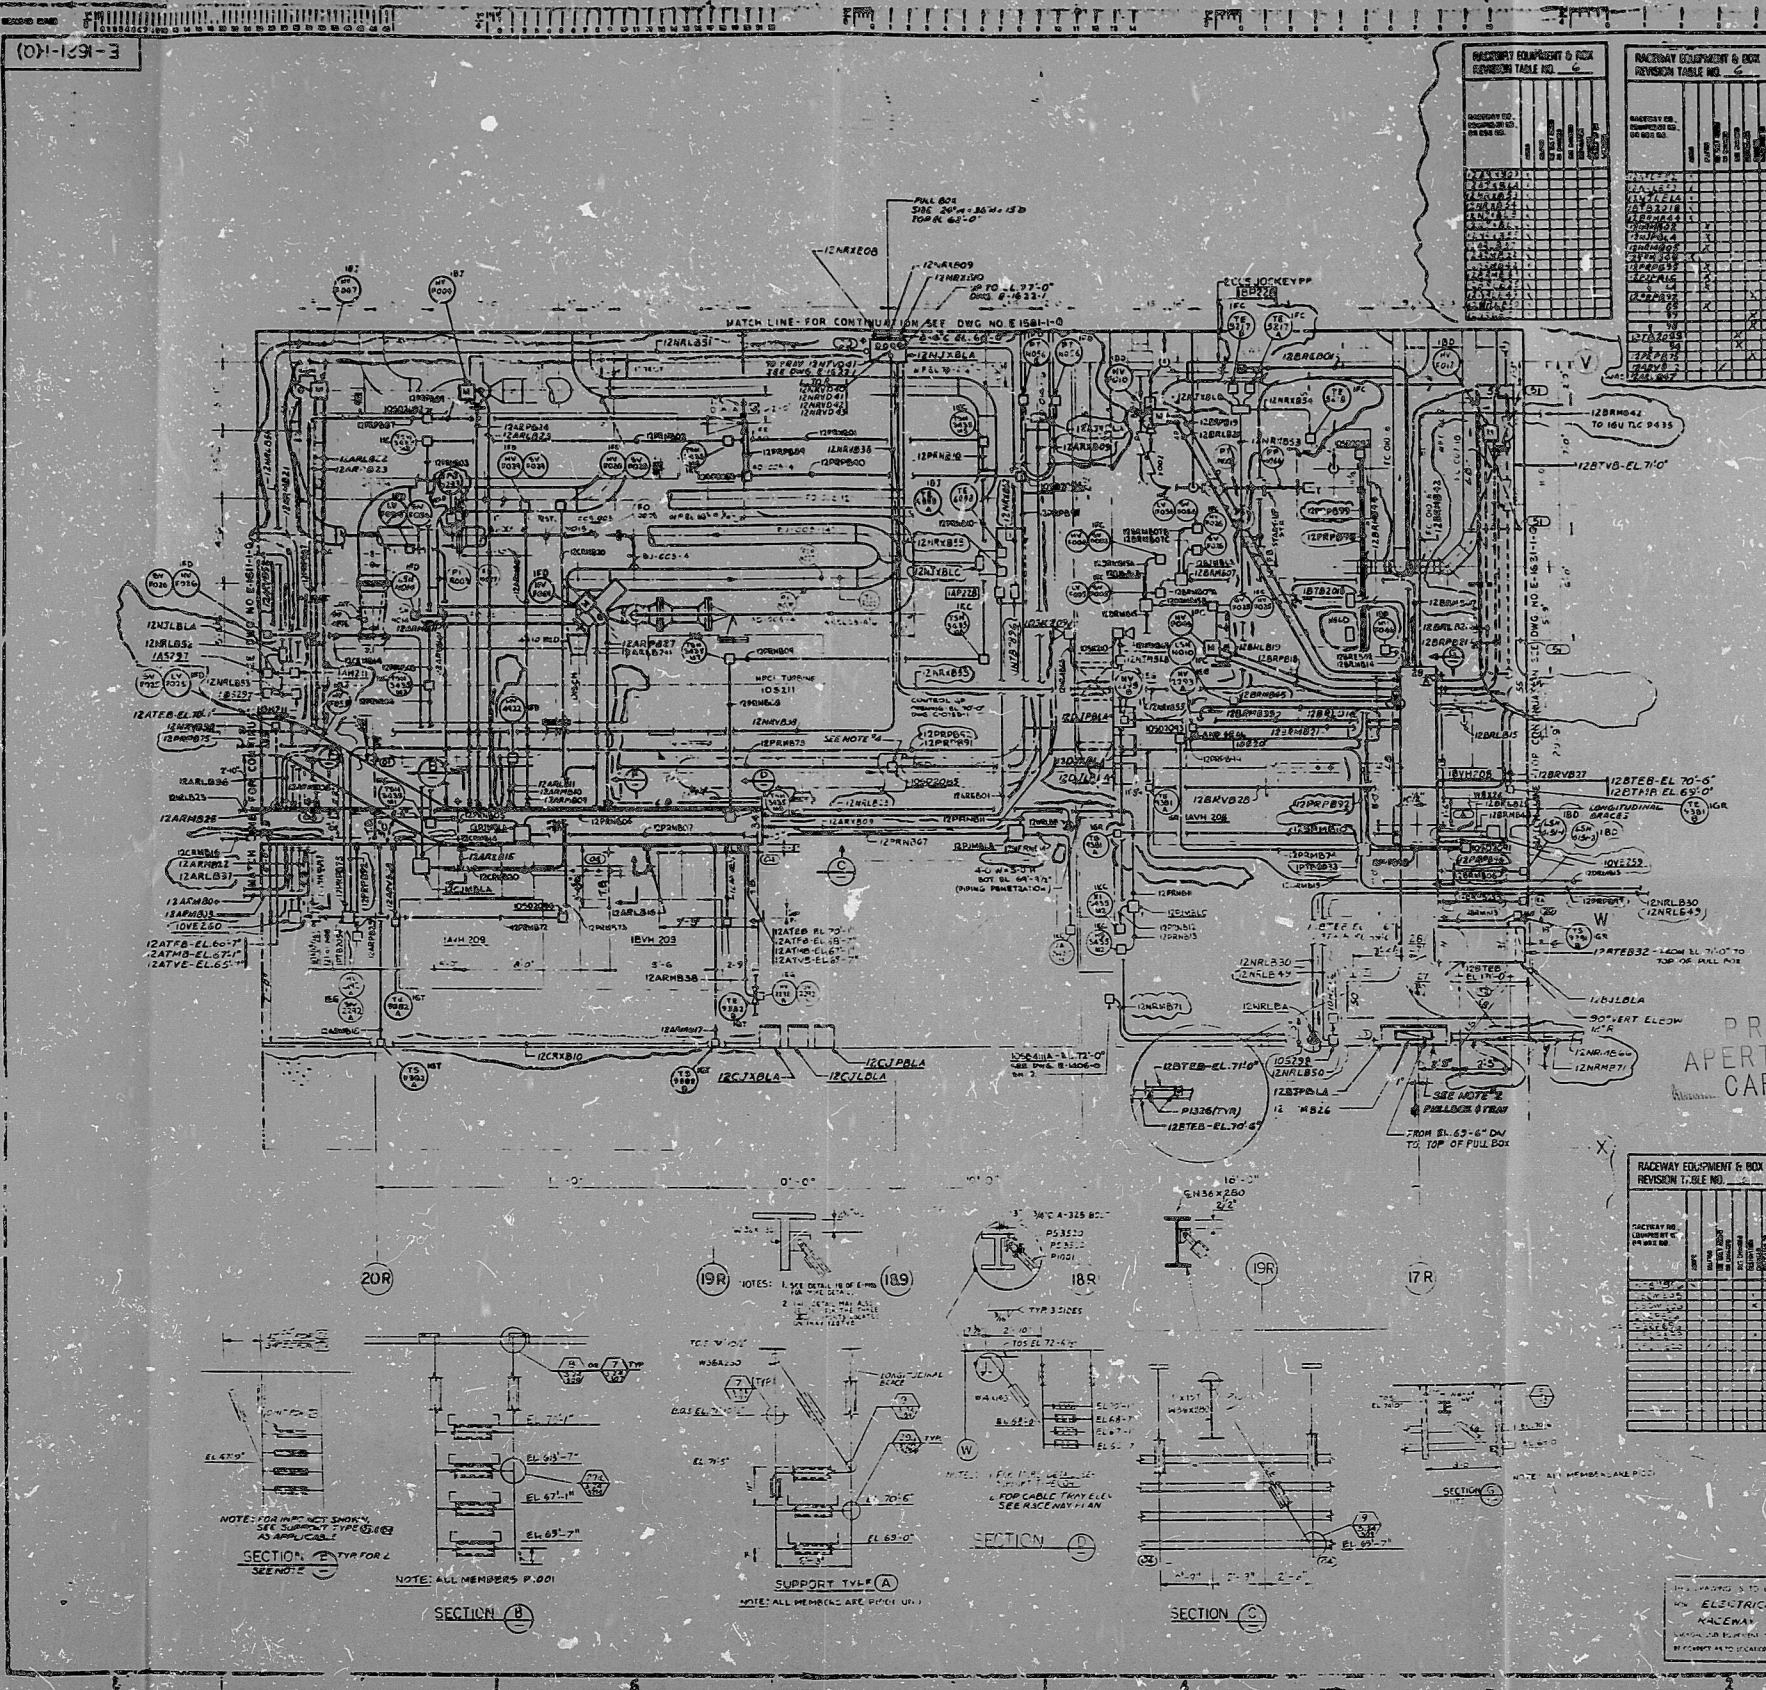

- NOTES:
1. ALL CABLE TRAYS ARE 24" UNLESS SHOWN OTHERWISE.
 2. FOR LOCATION OF JUNCTION BOXES, SEE EMBEDDED CONDUIT DRAWINGS.
 3. CLASS 16 RACEWAY TRAY & CONDUIT, ETC., ARE IDENTIFIED FOR "O" LISTED INSTALLATION BY LETTERS A, B, C, D, W, X, Y, OR Z, IN THE THIRD CHARACTER OF THE RACEWAY NUMBER.
 4. ALL FIRE DETECTORS ARE MOUNTED ON THE CEILING.

- REFERENCE DRAWINGS

PRO-
APERTURE
CARD



RACEWAY PLAN
RECTOR BUILDING AREA 23
PLAN EL 54-0'

E-1621-1 150

SHEET 2 OF 2

RIDS

830808056

