


This drawing and the design it covers are the property of BECHTEL. It is to be used only for the project for which it was prepared and is not to be reproduced, copied, loaned, exhibited, or used for any other purpose without the written consent given by the lender to the borrower.

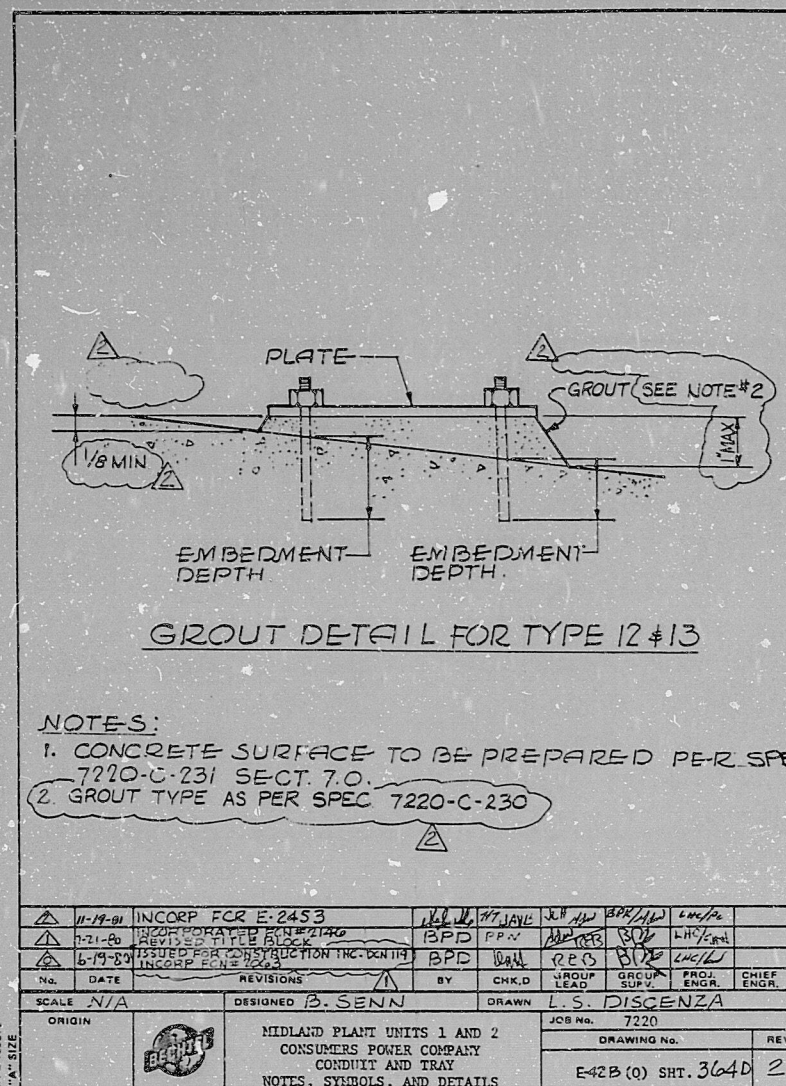

APERTURE
CARD

"I certify that the image contained on this frame was made in the normal and regular course of business, on the date stated below and that it is an accurate reproduction of the document submitted to the contractor for filming, by Bechtel Power Corporation."

R. DATE 1/25/72
CAMERA OPERATOR Merrill
CONTRACTOR'S SUP'VR. OR MANAGER

16X

RIDS

8203090198

