


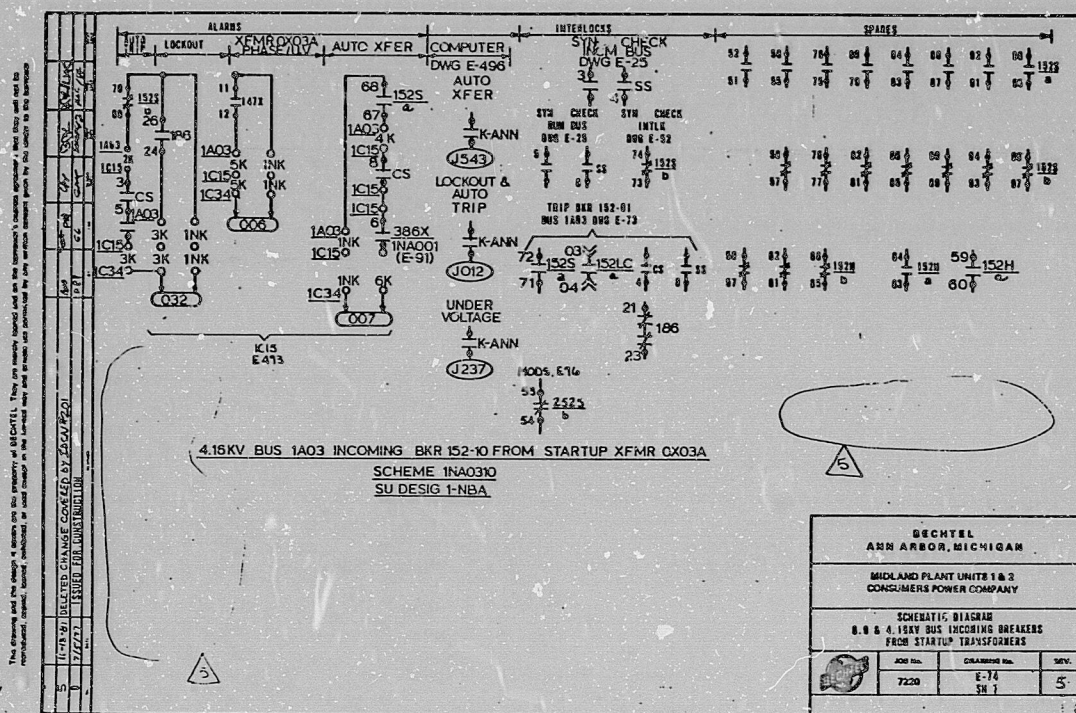

CERTIFICATE OF MICROFILMING

"I certify that the image contained on this frame was made in the normal and regular course of business, on the date stated below and that it is an accurate reproduction of the document submitted to the contractor for filming, by Bechtel Power Corporation."

Date 1-27-82 Camera Operator Rose Spices Contractor's Sup'vr Sue Crockett

16X

APERTURE CARD

RIDS

8203090334

