
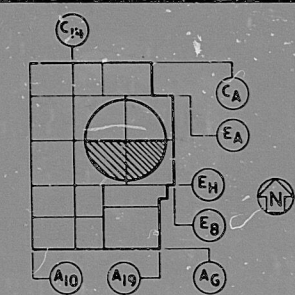


REVISION		DATE		REVISION		DATE	
BY	CHKD	APPR.1	APPR.2	APPR.3	APPR.4	APPR.5	

11208-007-57
FOR CONT SEE LMG.
151-11208-007

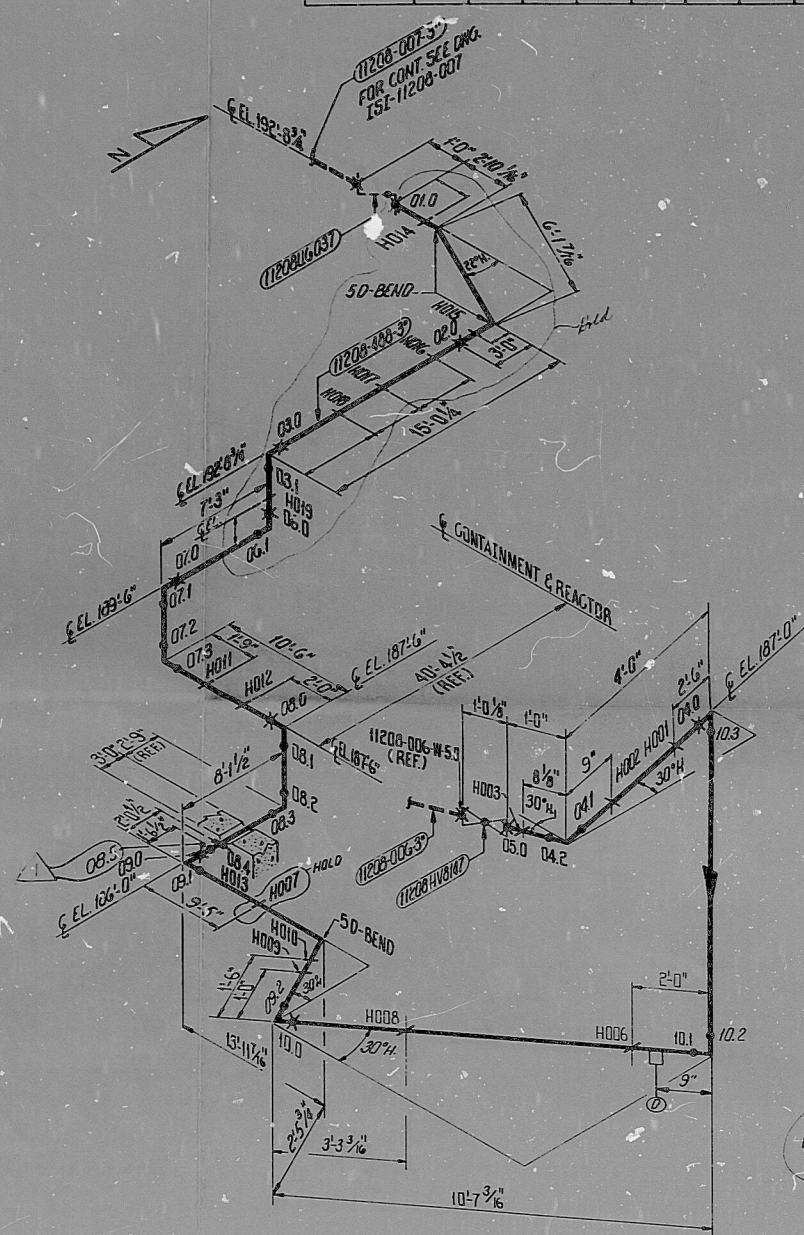

KEY PLAN
LEVEL "B"

LEGEND:

- 1.  INDICATES FIELD WELD.
- 2.  INDICATES SHOP WELD.
- 3.  INDICATES INTERGRALLY WELDED SUPPORT ATTACHMENT.
- 4.  CONTAINMENT PENETRATION.
- 5.  BRANCH CONNECTION WELD.
- 6.  PIPE RESTRAINT

REFERENCE DRAWINGS:

P&I.D. _____ 1X408111, 114
FAB ISO. _____ { 1K4-1208-448-03.04
1K4-1208-006-01

PIPING LAYOUT DWG. _____ 1X4DL 1A06, D05, D06
CIVIL / STRUCTURAL _____ 1X2D48A004, 007
HANGER DETAIL DWG. _____ 1X2D48F002
VI-1209-488-H001, 234, 5
6, 7, 9, 10, 11, 12, 13.

F-SHEETS _____ F-13118, 13119, 13120,
F-13121, 4892, 5860,
5861, 5862, 5863, 5864

ISI CLASSIFICATION DWG. — ISI-D-028

NOTES:

1. SEE ISI PLAN FOR SELECTION AND FREQUENCY OF EXAMINATIONS.
2. FOR PIPE WELD END PREP. SEE BECHTEL DWG. AX4DR001 APPENDIX D. (U.N.O)

TI
APERTURE
CARD

Southern Company Services, Inc.

GEORGIA POWER COMPANY

VOGTLE ELECTRIC GENERATING PLANT
UNIT 1 - LINE NO.488
INSERVICE INSPECTION ISOMETRIC
CHEMICAL & VOLUME CONTROL
SYSTEM 1208

DESIGNED <i>F.T.</i>	DRAWN <i>C.S.B.</i>	CHECKED <i>H.S.</i>

REACT	PROJECT ID	GRANTING AGENCY	
NONE		75F-11208-000	1

1	2	
---	---	---	---	---	---	---	---	---	----	----	-----

100

10

100

PDR RIDS

85X3040558

