



E-587 SH2 OF 2

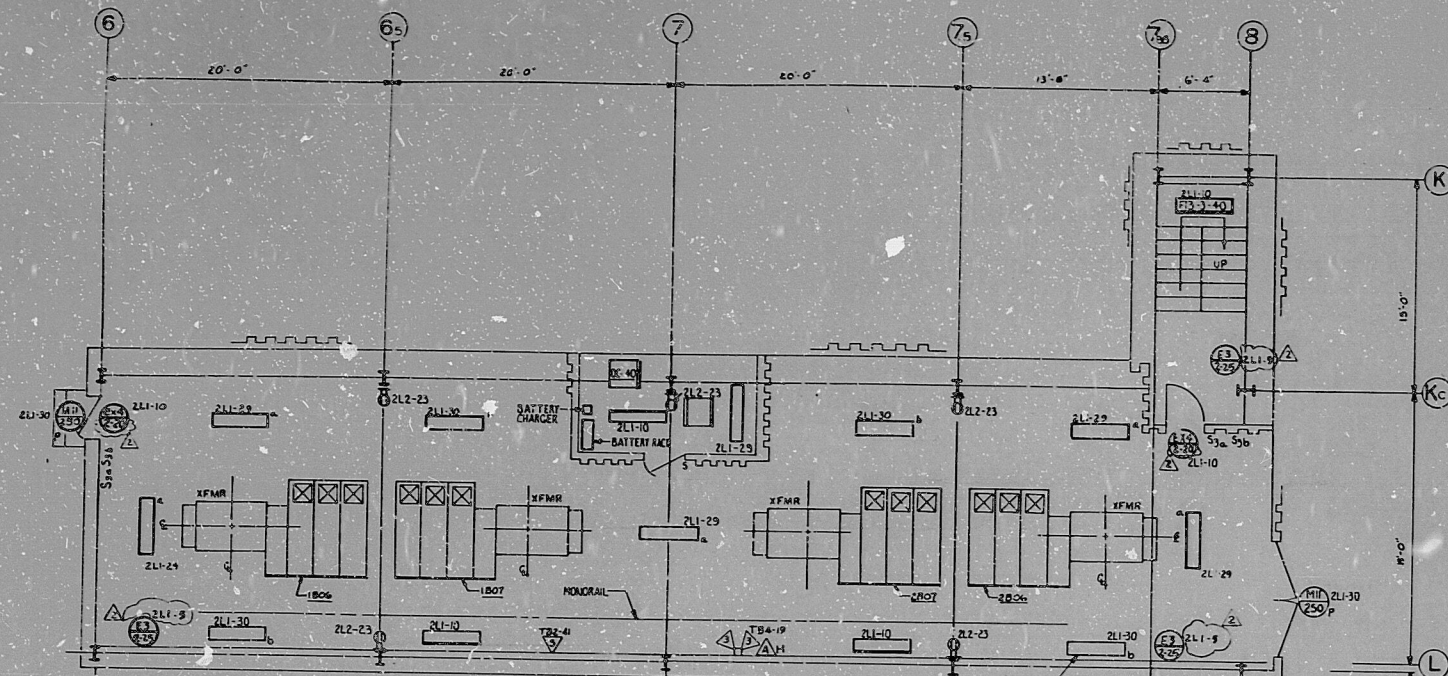

LIGHTING & COMMUNICATIONS PLAN FL EL 715'-7"
SCALE: (N.T.S.)

FIG. 1-40 (TYP FOR 13 FIXTURES)
MOUNTING HEIGHT IS 10'-0" ABOVE
FINISH FLOOR. FOR MOUNTING DETAIL
SEE E-44, SH 46.

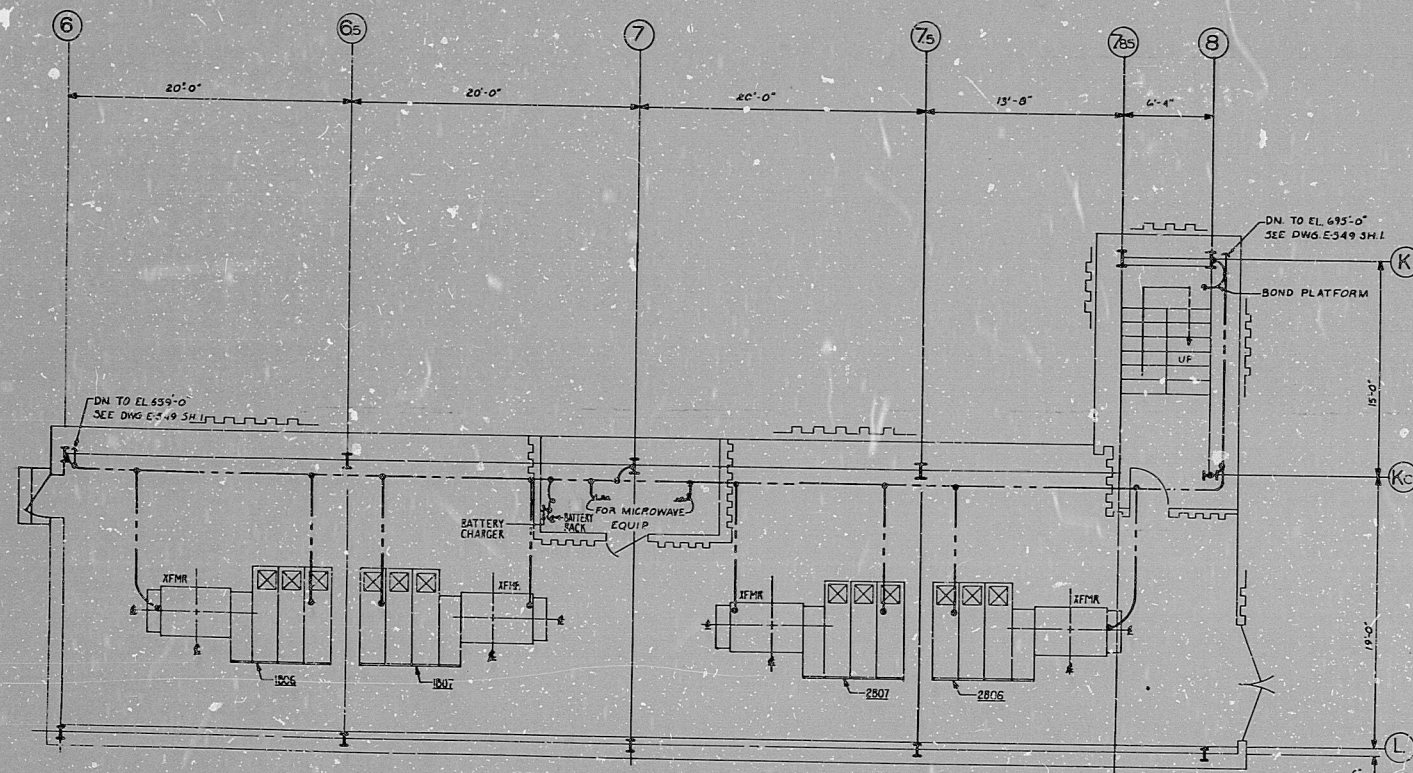

GROUNDING LAYOUT FL EL 715'-7"
SCALE: 1/4"=1'-0"

REFERENCE DRAWINGS

- E-41 GROUNDING NOTES, SYMBOLS, AND DETAILS
- E-42 COMMUNICATIONS NOTES, SYMBOLS, AND DETAILS
- E-43 LIGHTING NOTES, SYMBOLS, AND DETAILS
- E-44 LIGHTING PANEL SCHEDULE

30X


DATE: 10/10/70 BY: C. STONE

APERTURE
CARD

Rev. E-110925
DRAWING NO. E-587 SH2 OF 2
System No. 7220
Date 11/10/70

NO.	DATE	REVISION	BY	CHECKED
1	10/10/70	ISSUED FOR CONSTRUCTION	C. STONE	
MIDLAND PLANT UNITS 1 & 2 CONSUMERS POWER COMPANY				
LIGHTING COMMUNICATIONS & GROUNDING TURBINE BUILDING UNIT 2 EL 715'-7" & EXISTING ROOF				
7220	E-587 SH2 OF 2	2		

USE THIS DRAWING FOR
ELECTRICAL WORK ONLY
FOR ALL OTHER DATA REFER
TO APPLICABLE DRAWINGS

RIDS

8203090488

