

48

48

22

22

11

11

11

11

58

58

8.5"

8.5"

11"

11"

17"


17"

22"

22"

34

34

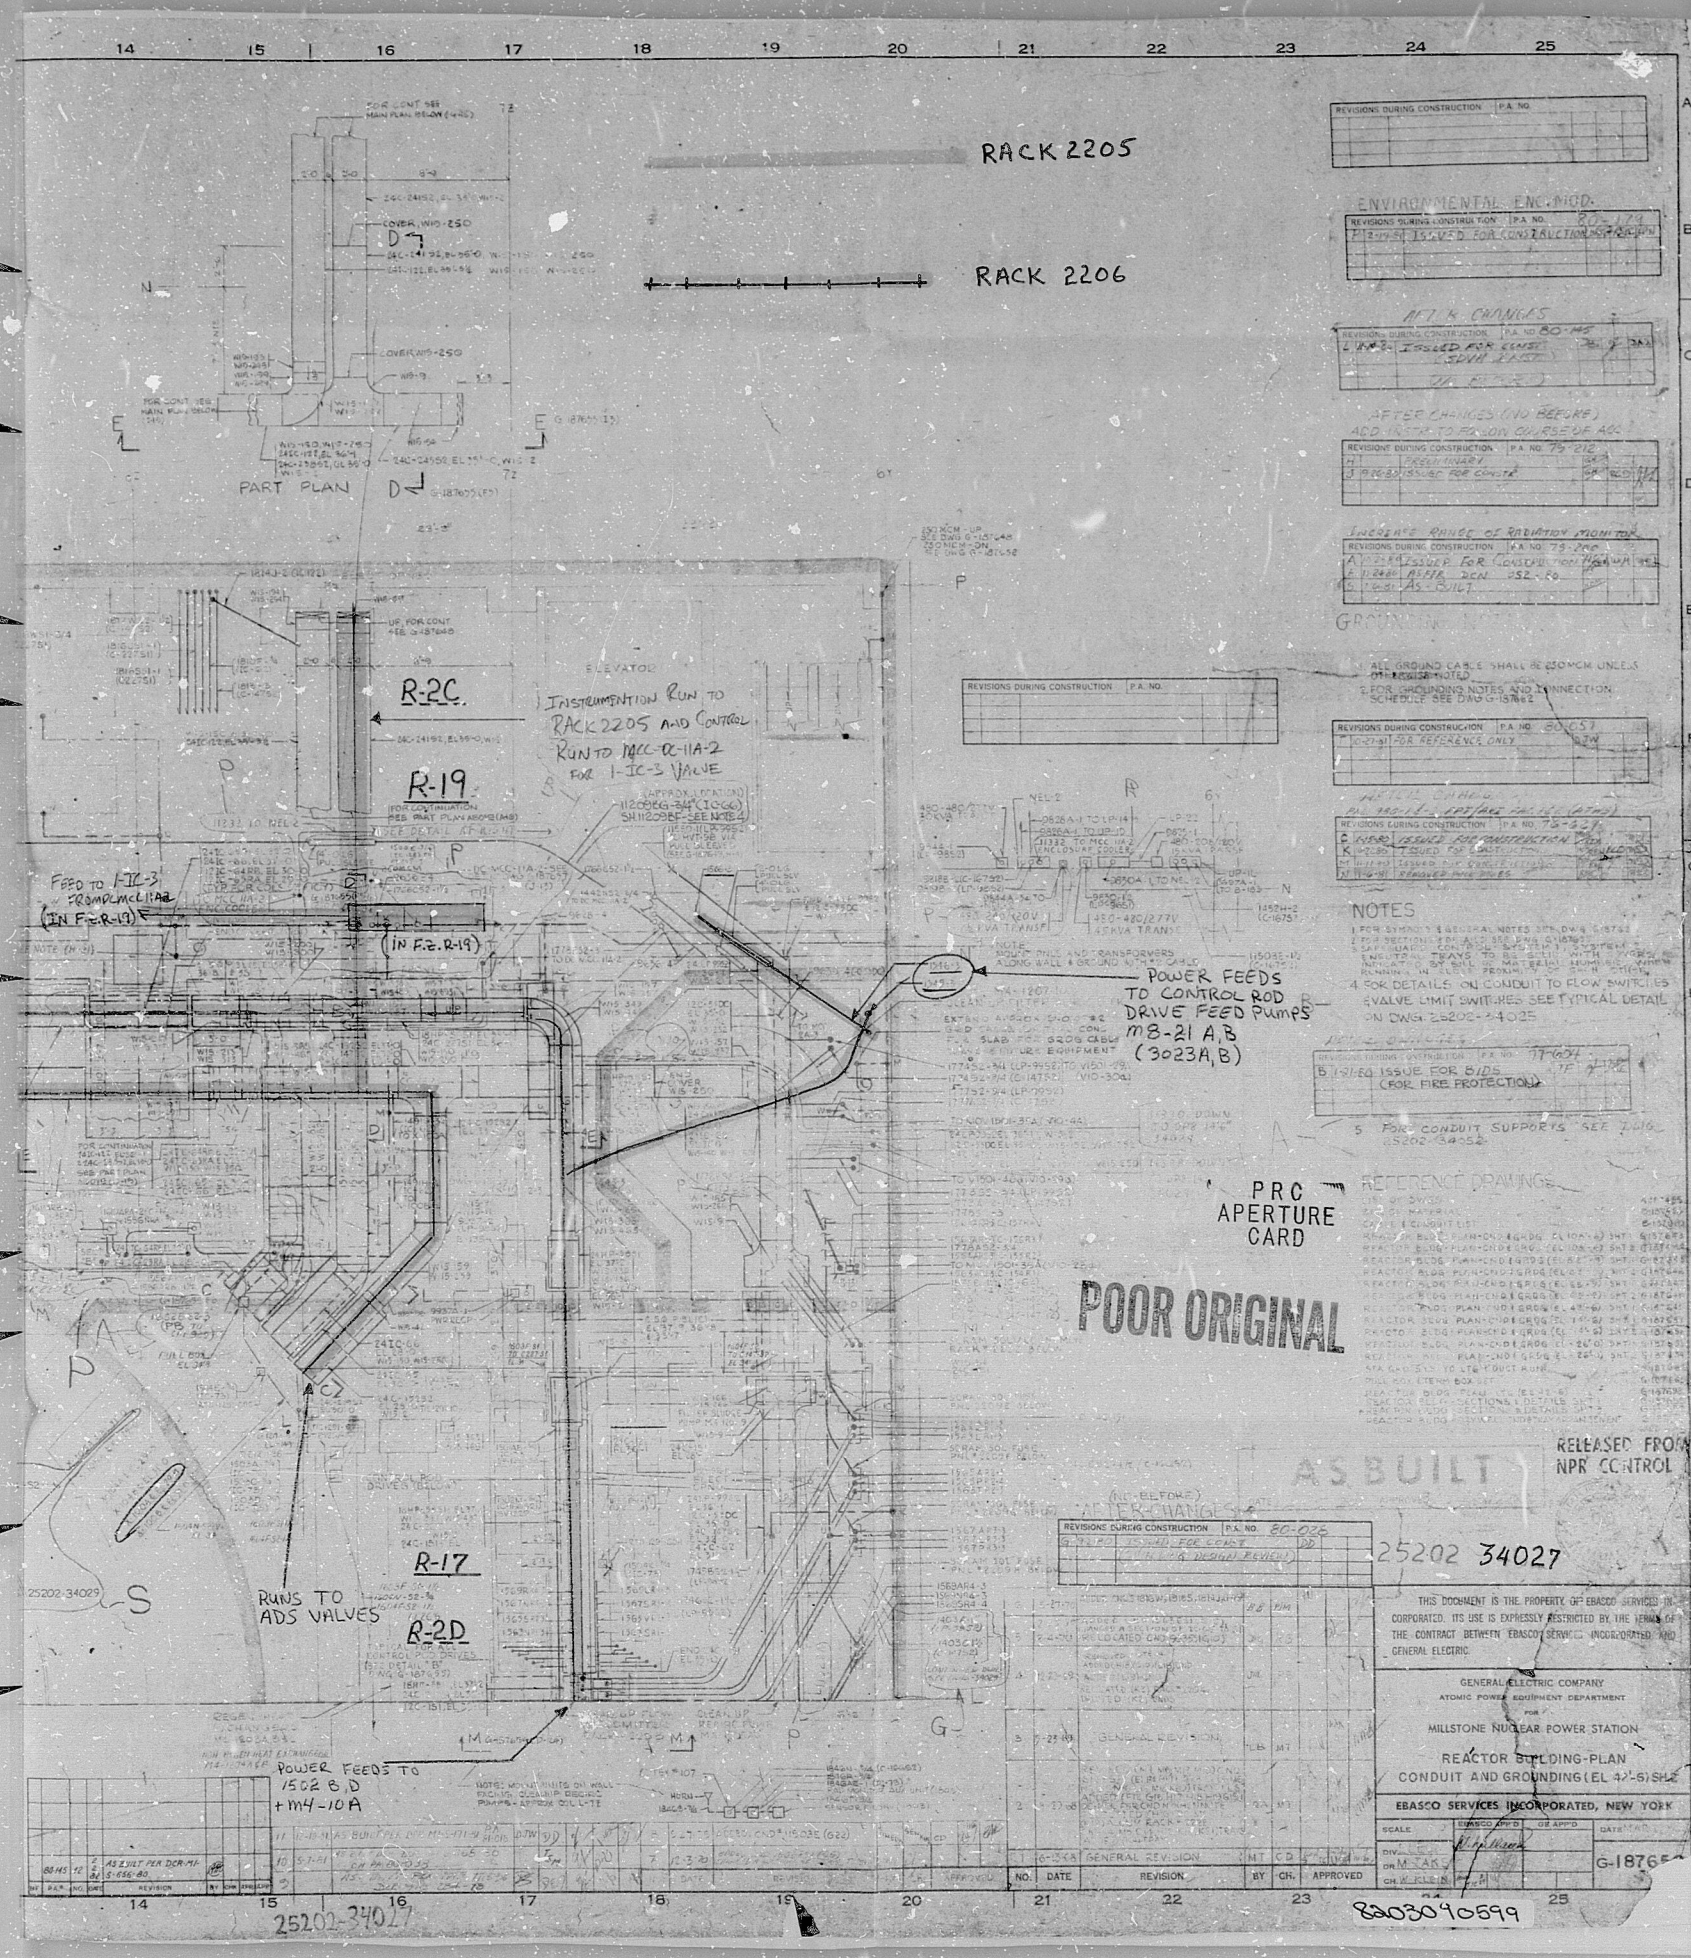

R10S

8203090599

