


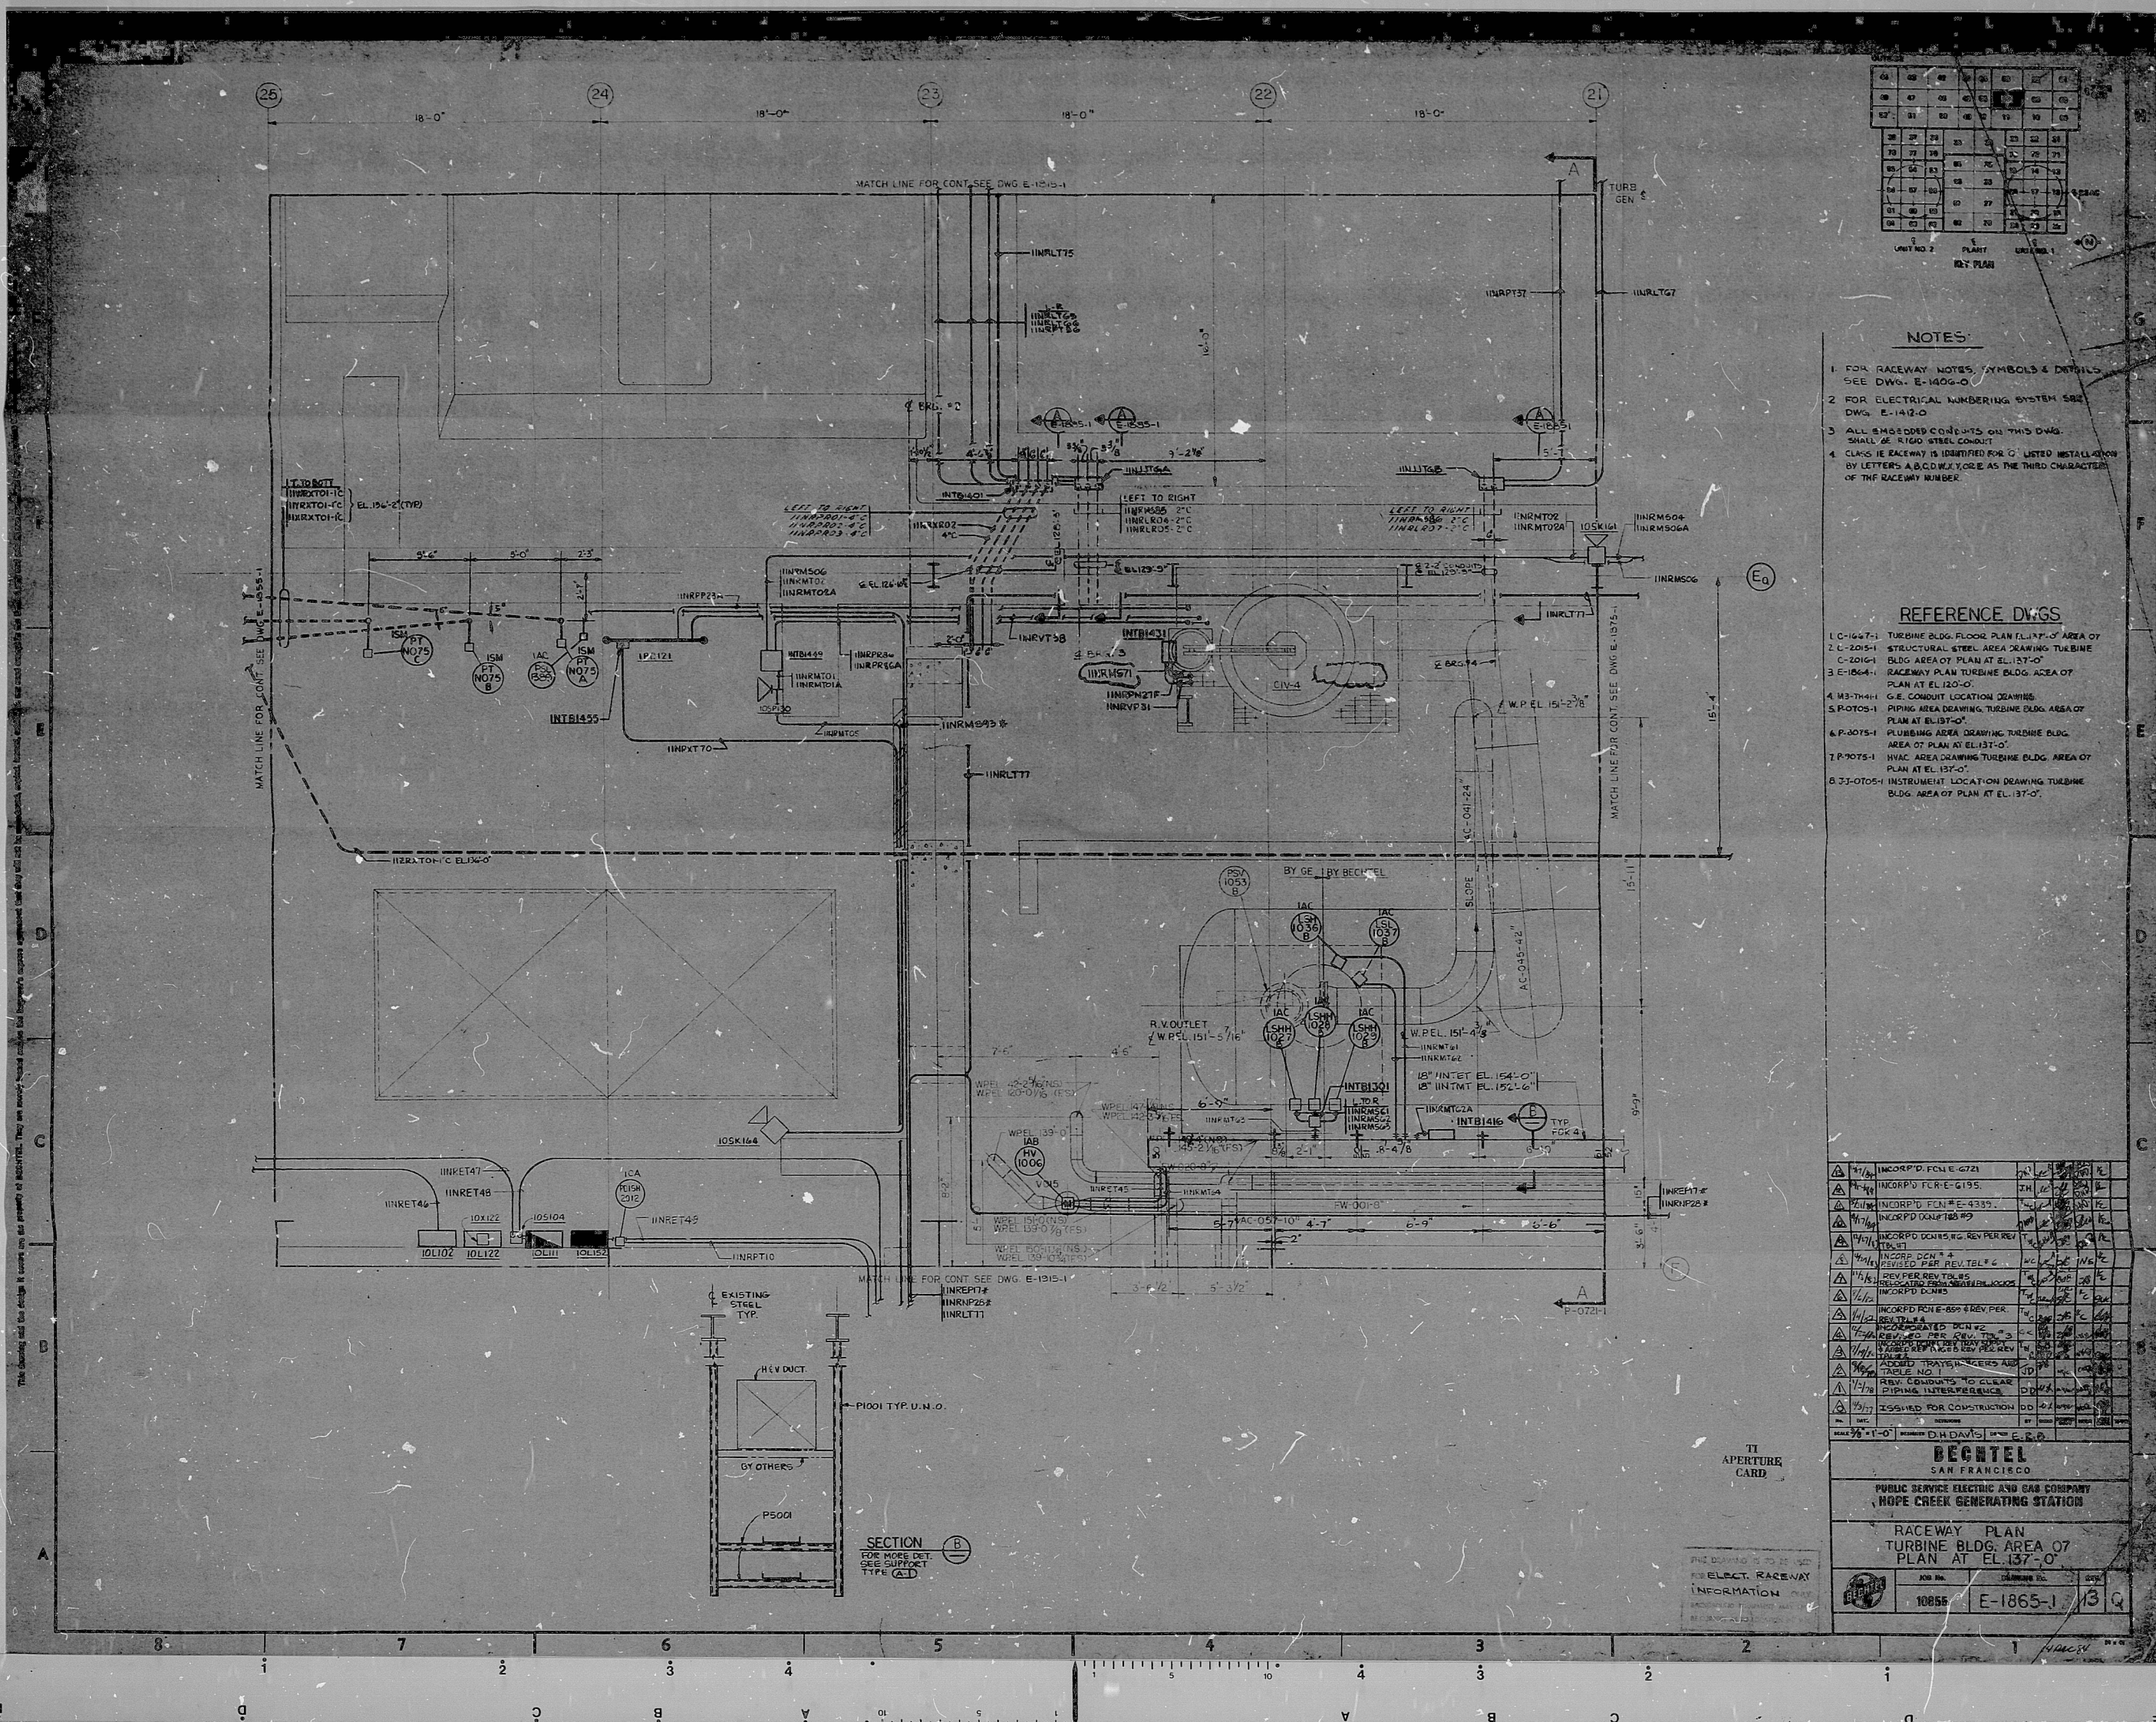

PDR RIDS

8503060015

