


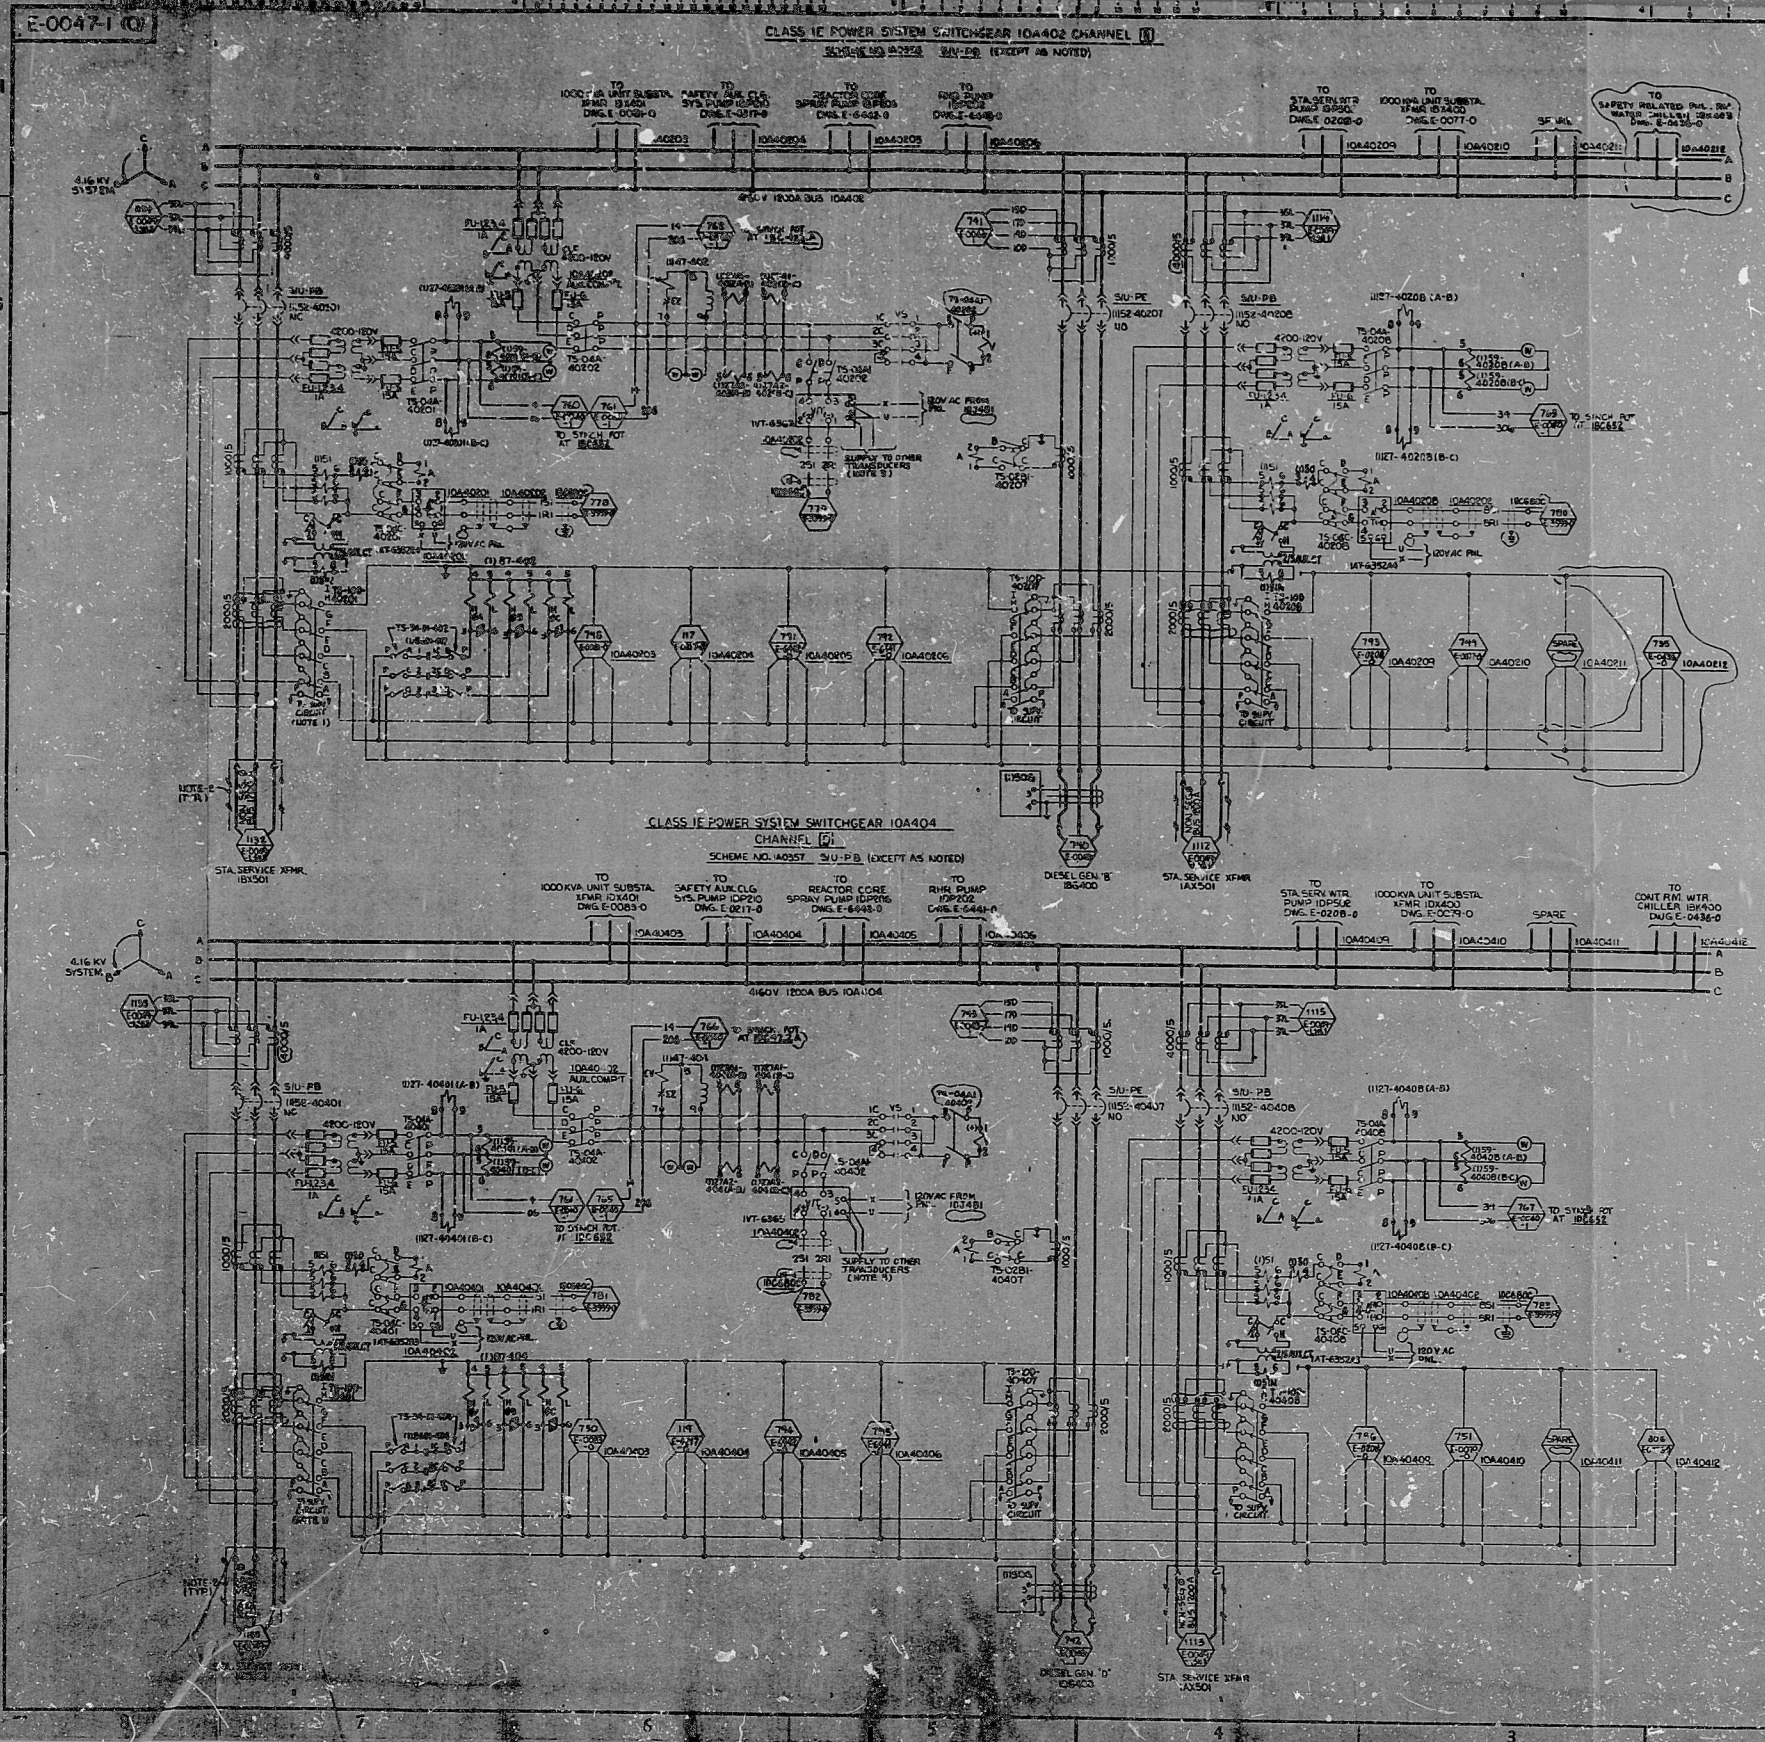

CONTACTS	POSITION
10A402	10A402

NOTES:
1. SEE REF. 1 FOR SUPPLEMENTARY CIRCUIT.
2. ALL EQUIPMENT IN THIS DIAG. IS LISTED EXCEPT THAT WHICH IS IDENTIFIED BY THE FOLLOWING BOUNDARY.
3. ALL CURRENT & VOLTAGE TRANSDUCERS IN THE SWGR. WILL HAVE A 100V/C INPUT ALL TUNED TO EACH OTHER.

REFERENCE DRAWINGS:
1. SINGLE LINE W/R DIAG. 416KV CLASS 1E POWER SYS. DWG. E-0006-100-1-1
2. TEST SW. FUSE & CIR. BREAKER DETAILS DWG. E-414-100
3. CABLE BLOCK DIA. DWG. E-4047-100
4. PENDING DWG. DWG. E-0005-1
5. SYNCHRONIZING DIAG. DWG. E-0007-1
6. ELECT. SCHEM. DIAG. DIFF. & 4V PROTECTION DWG. E-0106-100-1-1

PRO
APERTURE
CARD

REVISION	DATE	BY	CHKD
RIDS

8308090082

