


28
22
11
11
98
8.5
11
17
22
34

28
22
11
11
98
8.5
11
17
22
34

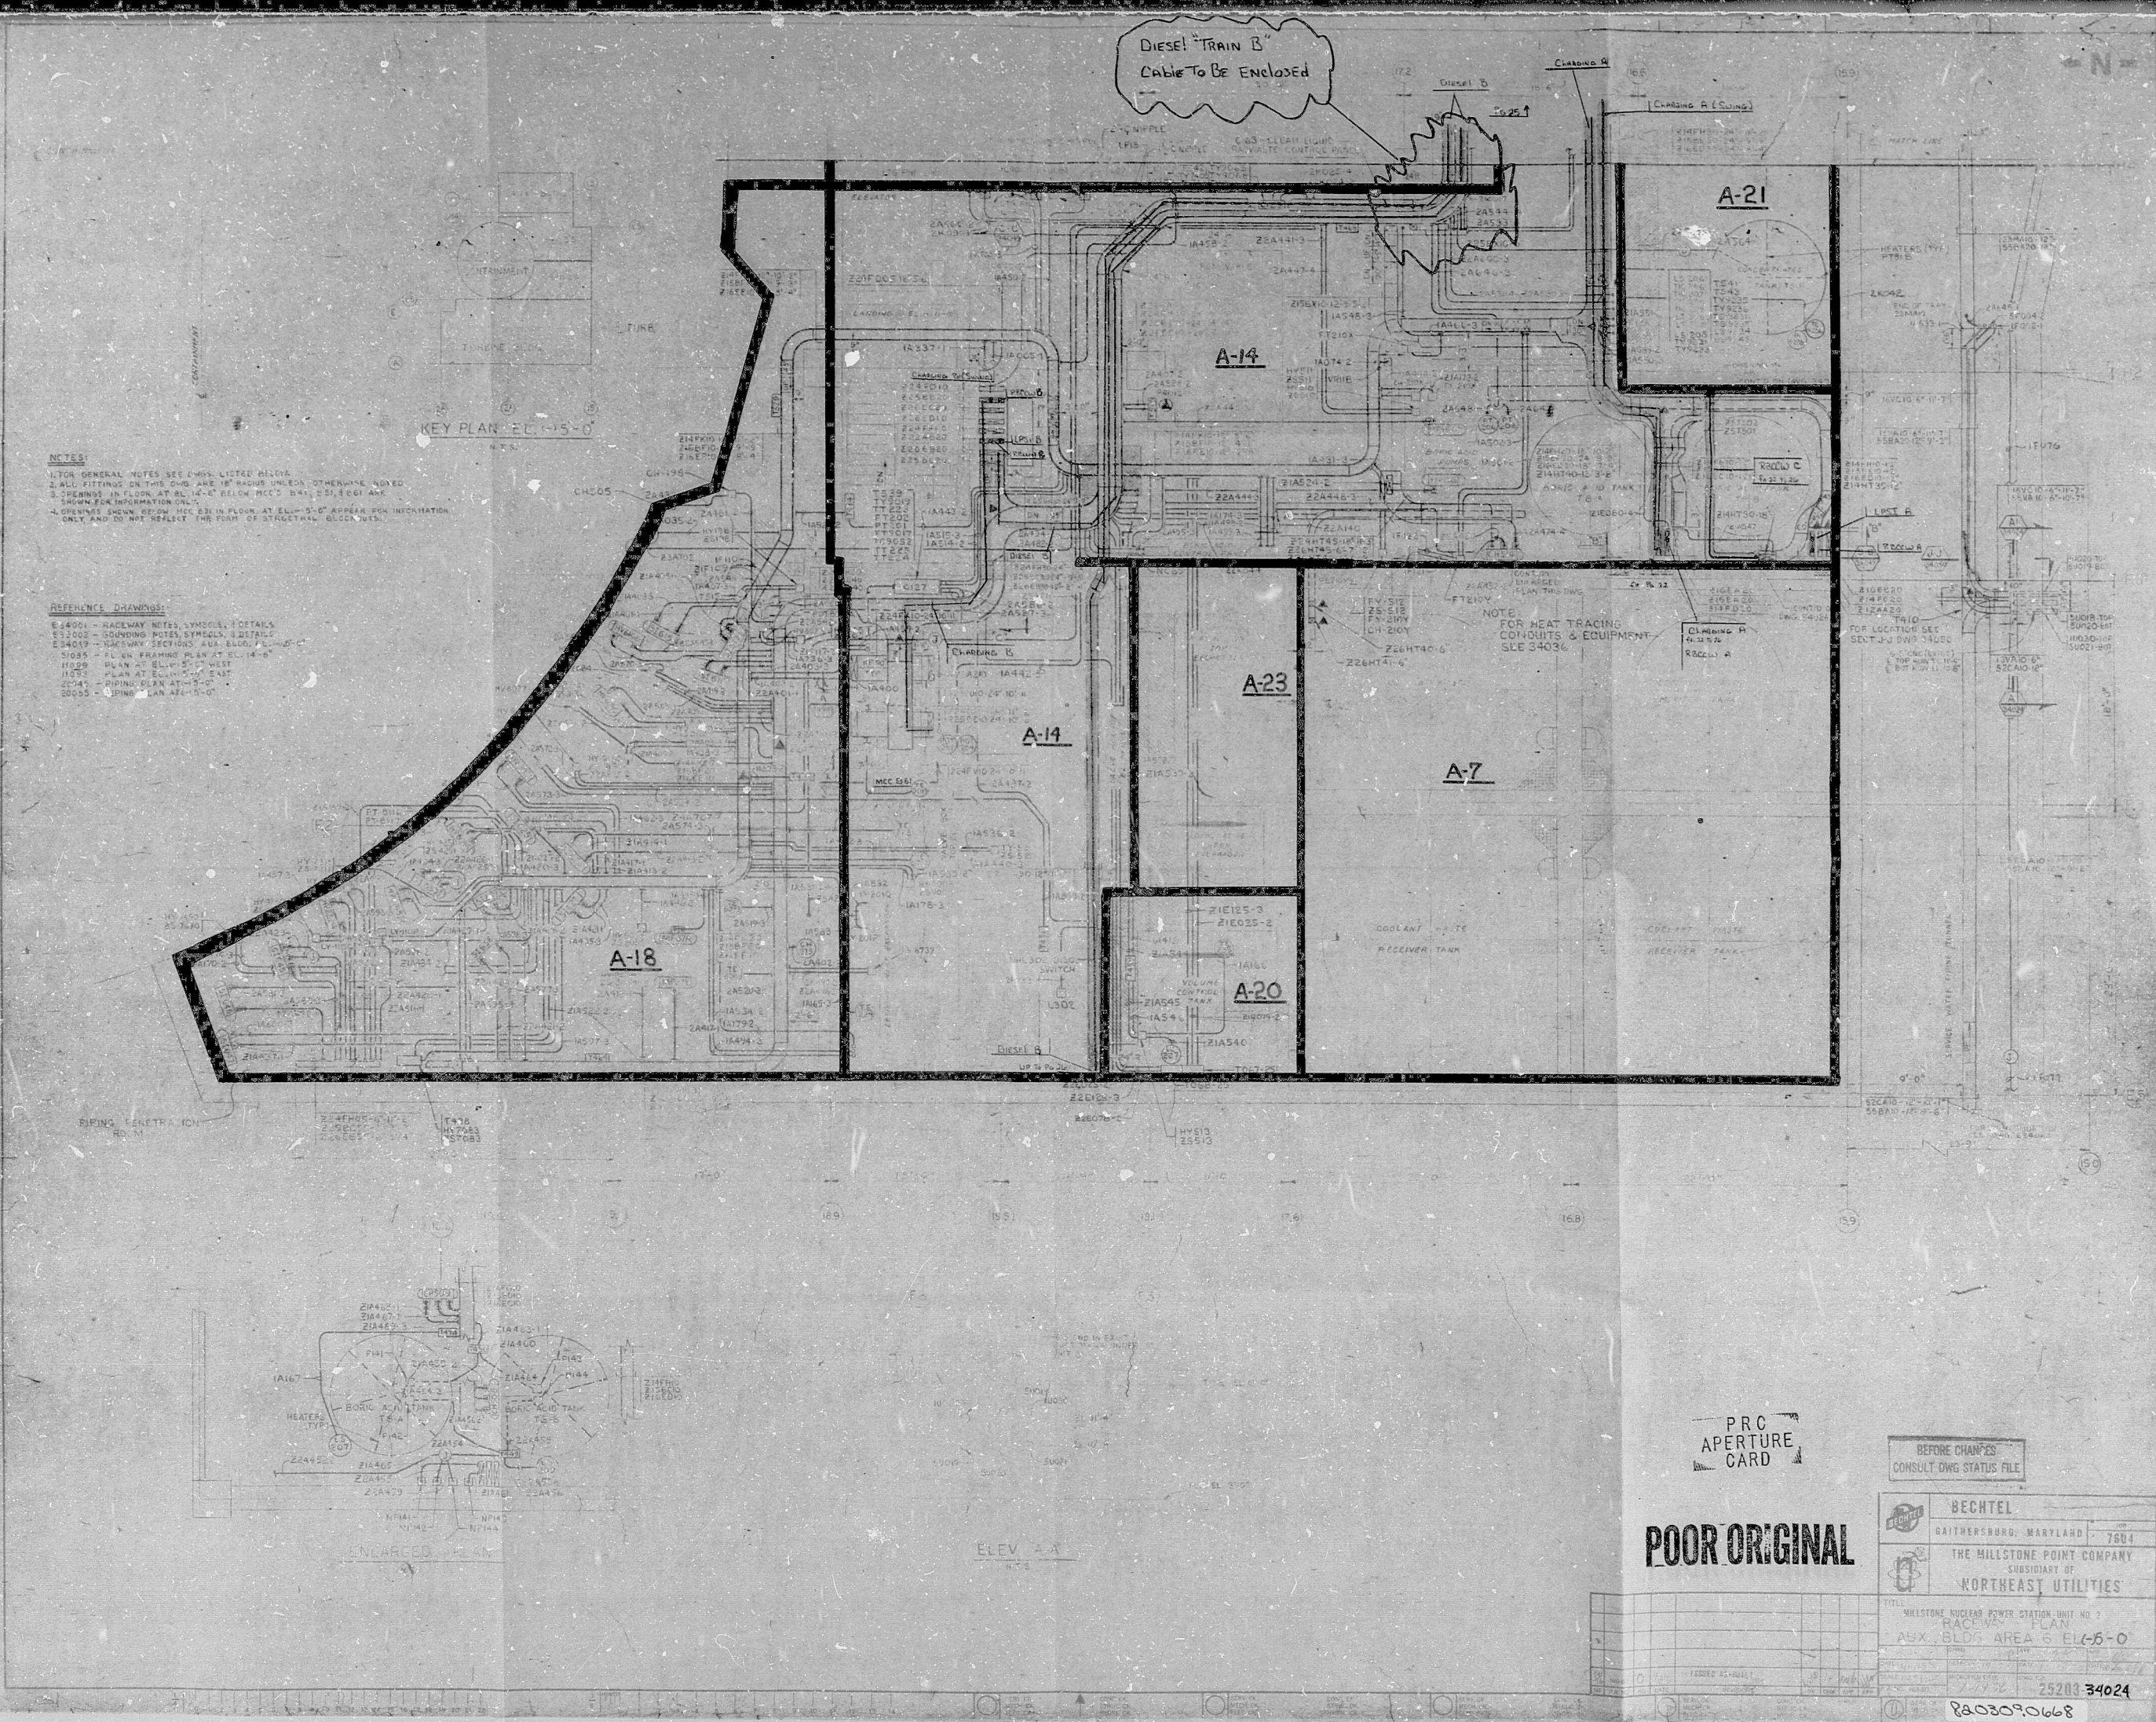

PRC
APERTURE
CARD

BEFORE CHANGES
CONSULT DWG STATUS FILE

BECHTEL
RAITHSBURG, MARYLAND 7604
THE MILLSTONE POINT COMPANY
SUBSIDIARY OF
NORTHEAST UTILITIES

TITLE
MILLSTONE NUCLEAR POWER STATION UNIT NO. 2
RACEWAY PLAN
AUX. BLDG. AREA 6 ELEV. 5'-0"

DATE
1-1-78

25203 34024

880309.0668

POOR ORIGINAL

RIDS

8203090668

