


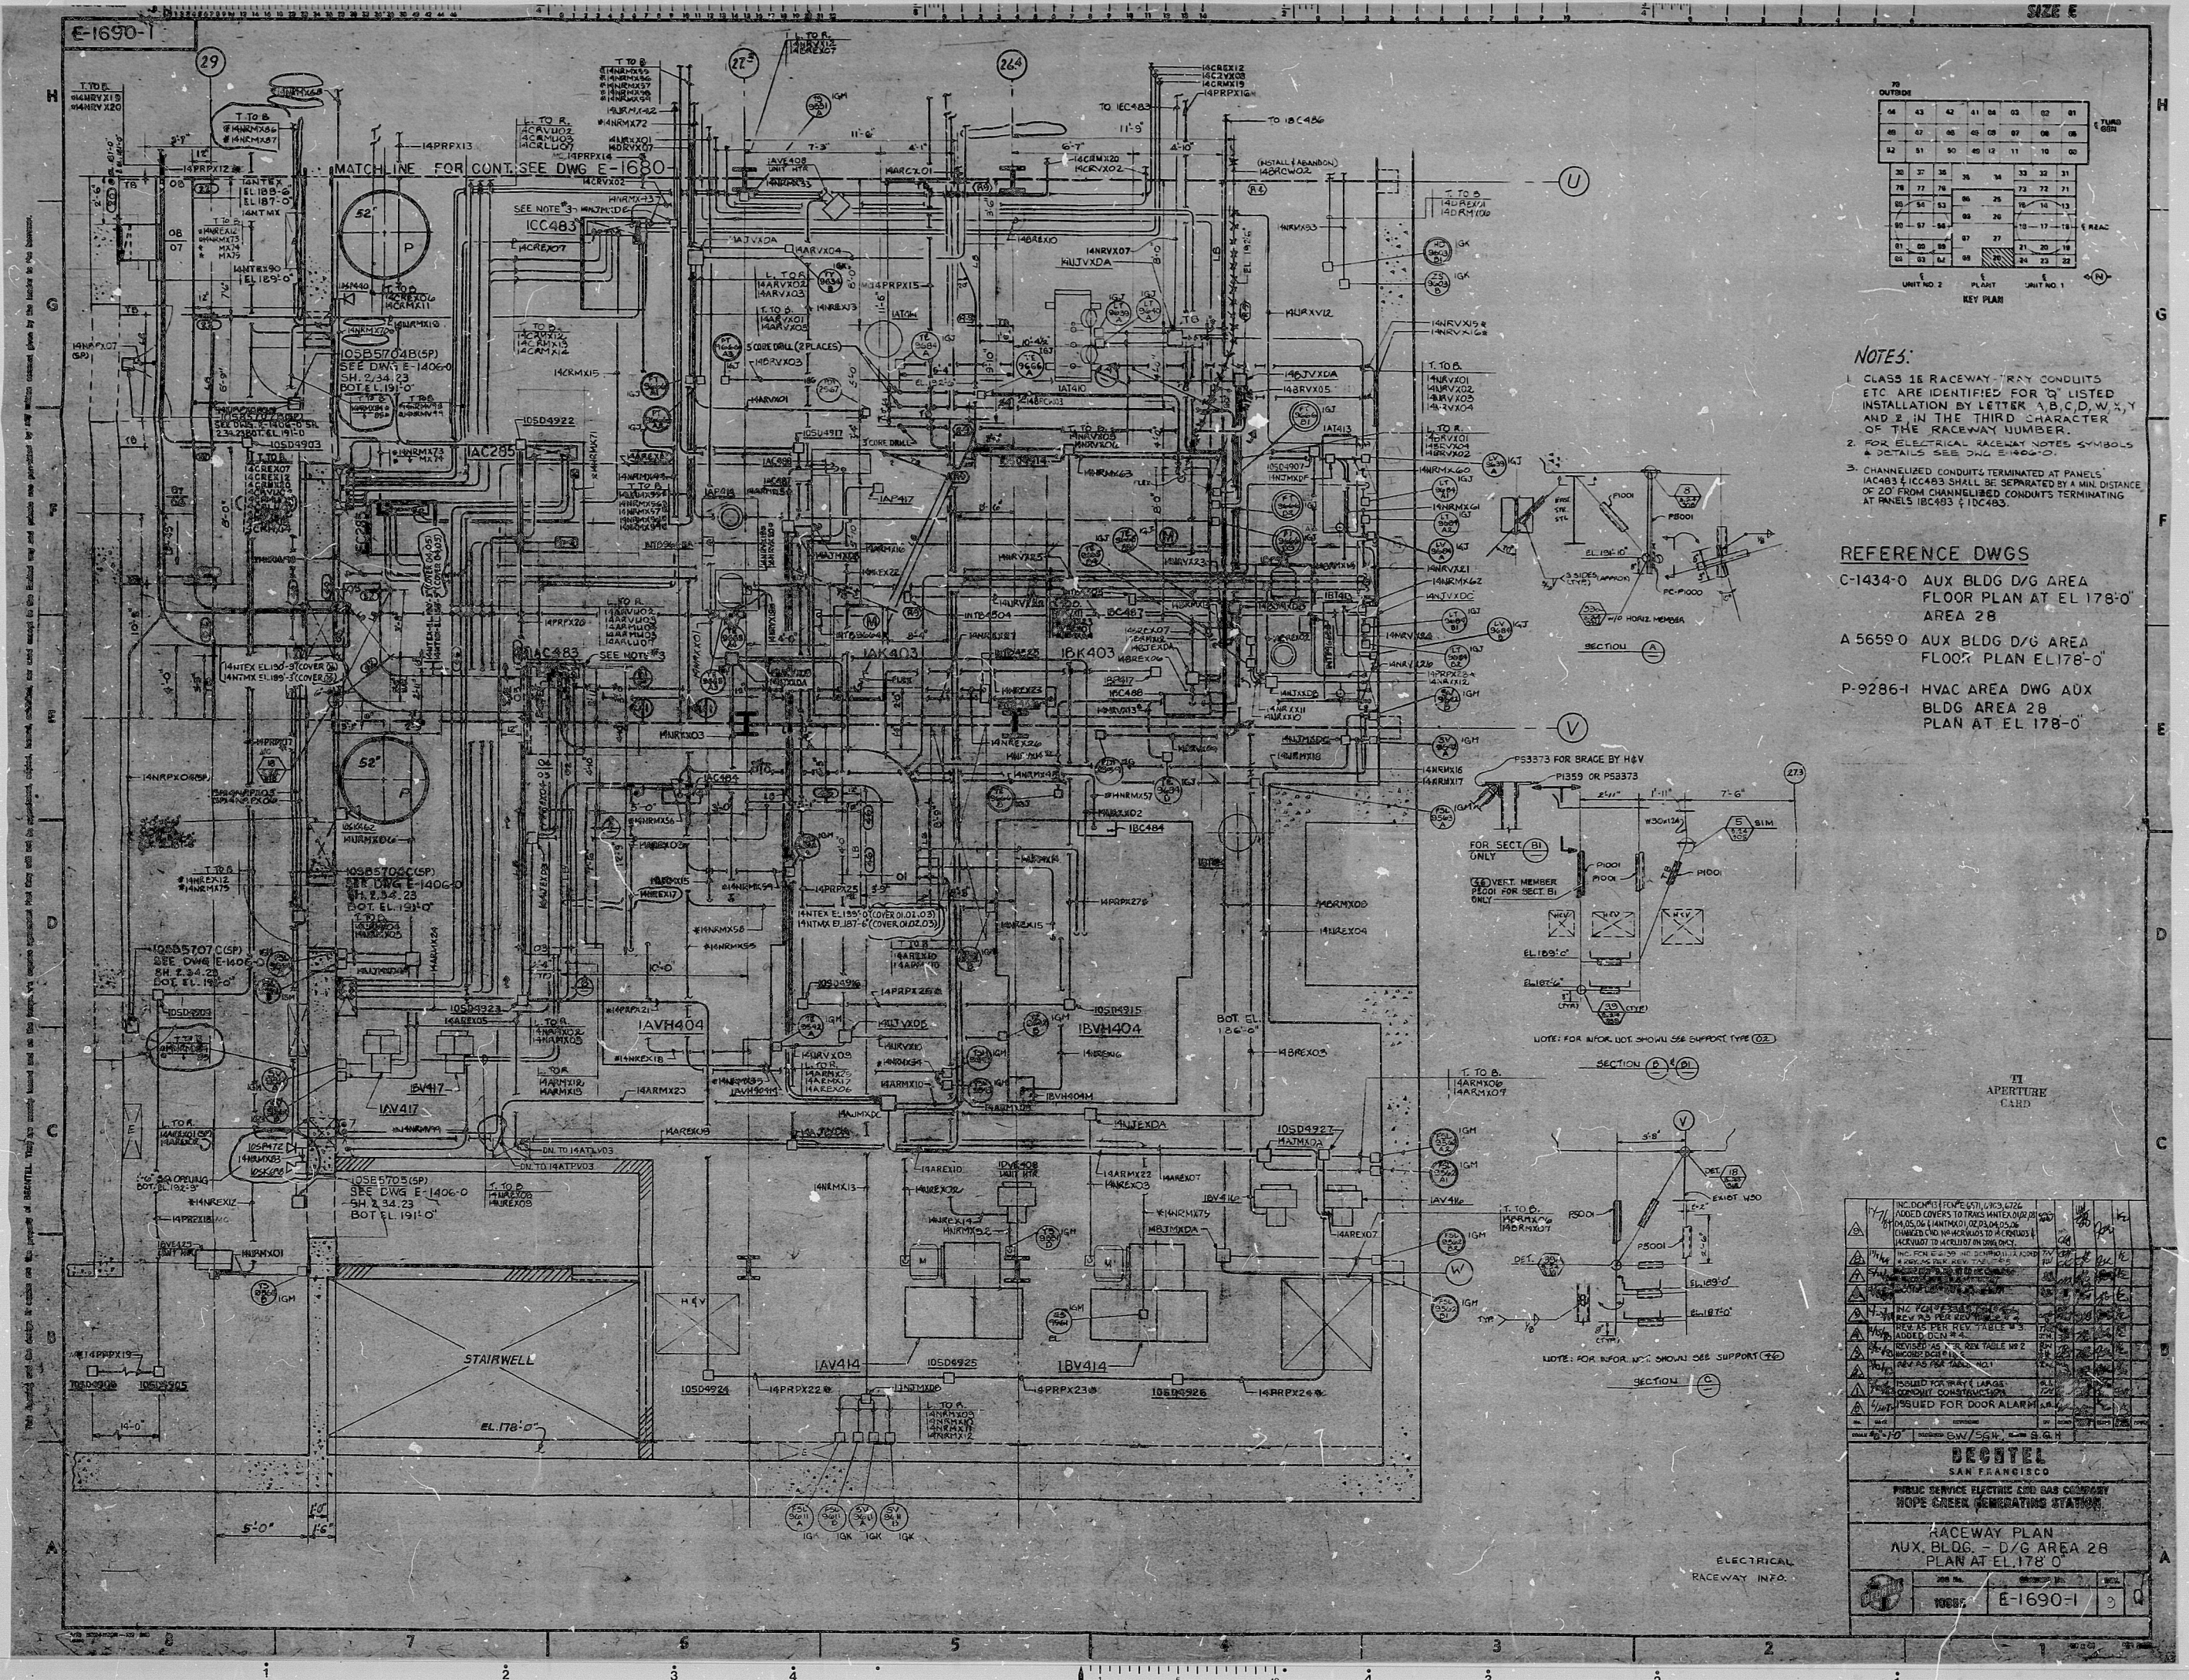

06	43	42	41	04	03	02	01	TUBS							

PDR RIDS

8503060113

