


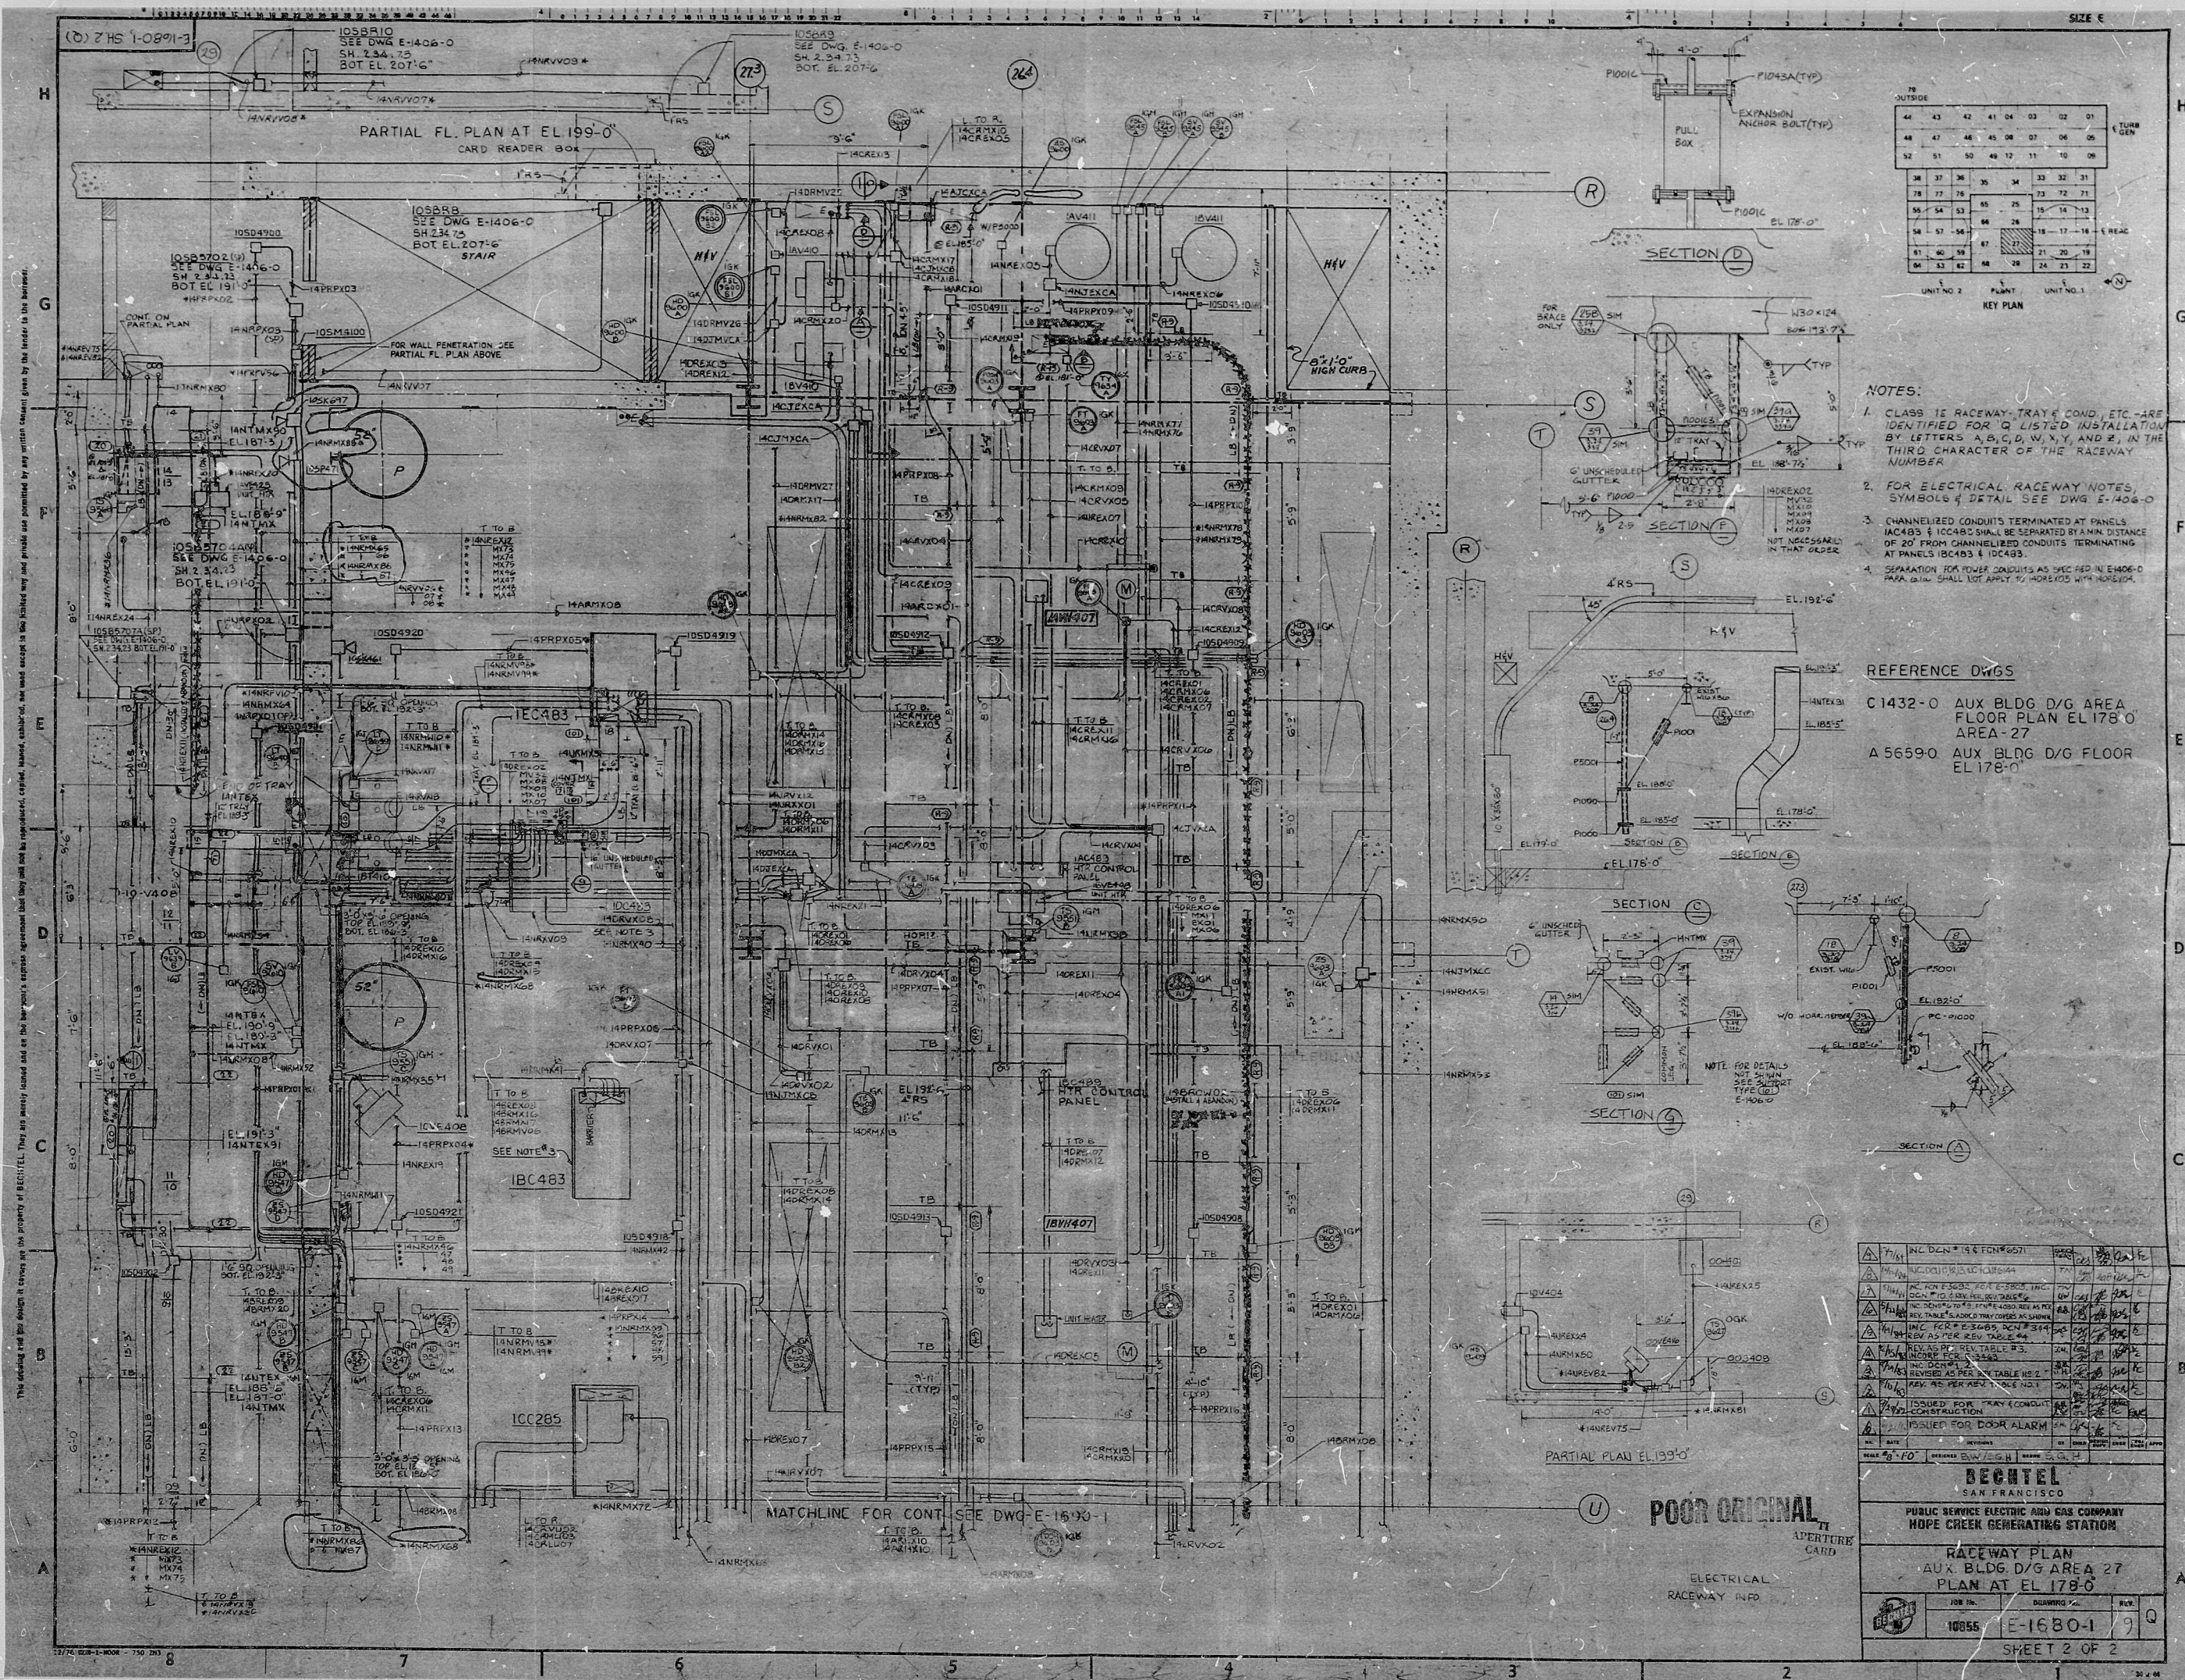



PDR RIDS

85D3060131

