


17"  
11"  
8.5"  
8.5"  
11"  
17"

17"  
11"  
8.5"  
8.5"  
11"  
17"

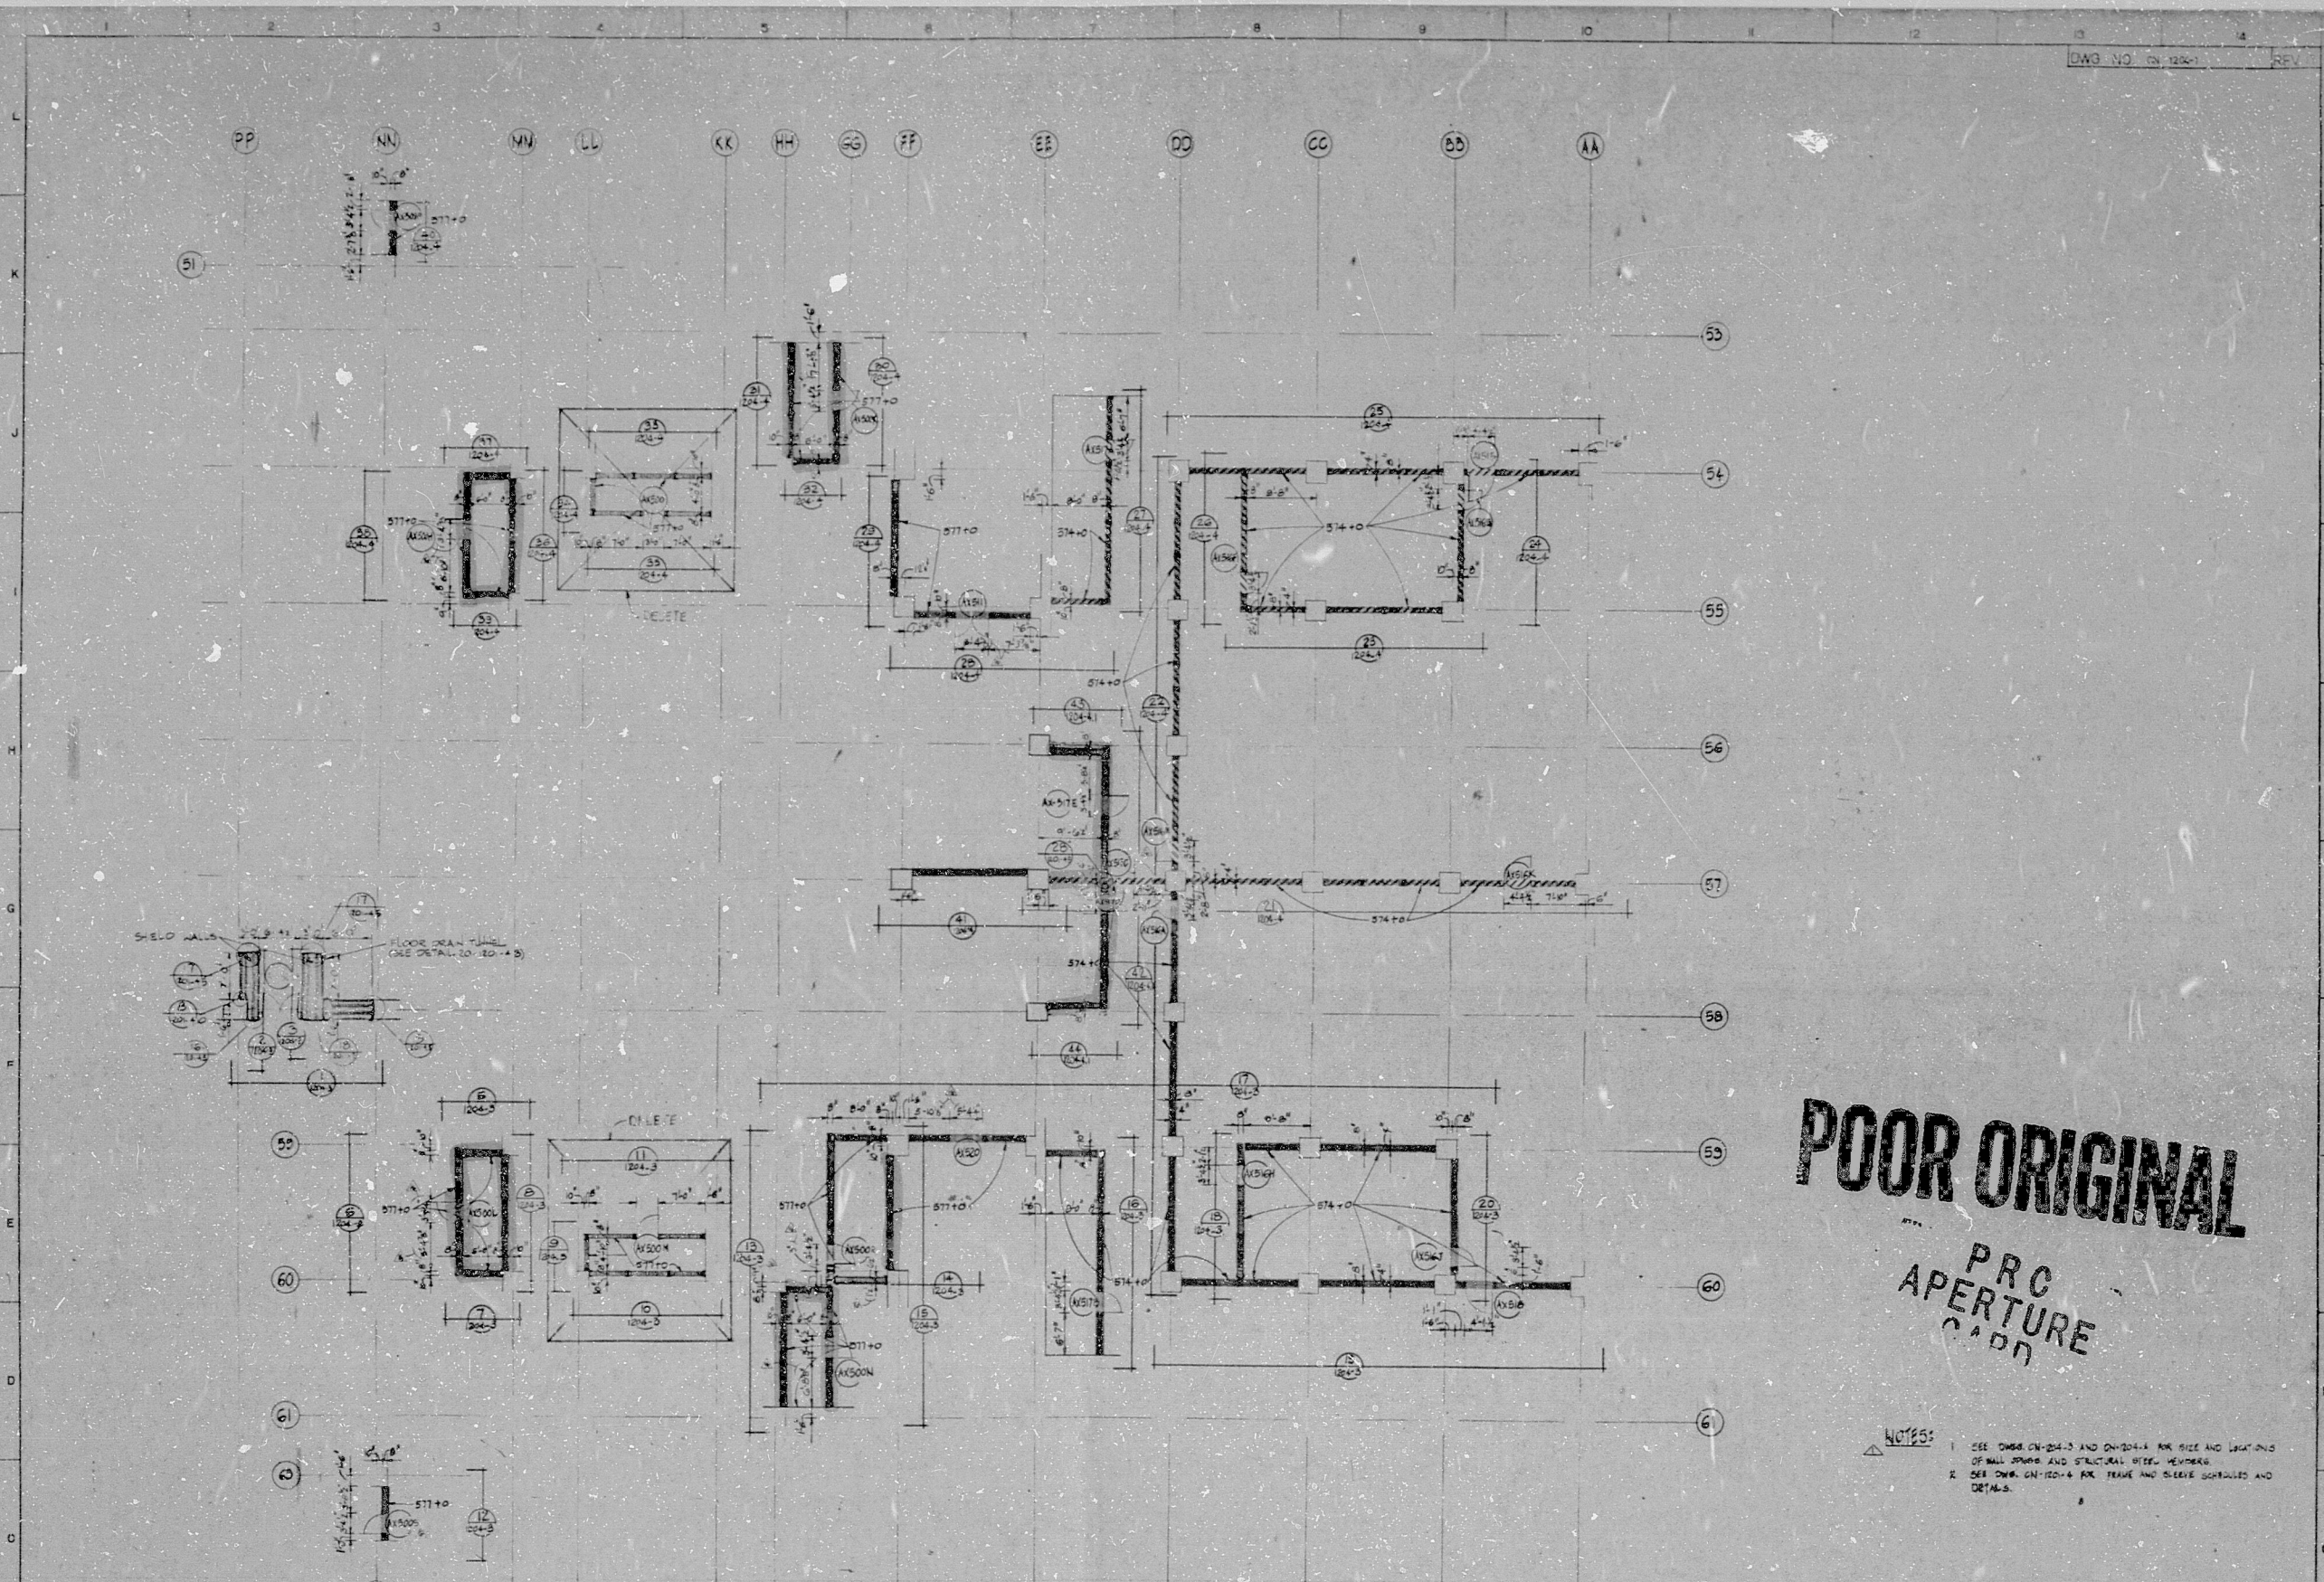

**POOR ORIGINAL**  
P.R.C.  
APERTURE  
CADD

NOTES:  
1. SEE DWGS. CN-204-3 AND CN-204-4 FOR SIZE AND LOCATION OF WALL OPENINGS AND STRUCTURAL STEEL MEMBERS.  
2. SEE DWG. CN-100-4 FOR FRAME AND GROUT SCHEDULES AND DETAILS.

DESIGNATES WALLS NOT CONSTRUCTED

**FLOOR PLAN**  
SCALE: 3/4"=1'-0"  
SEISMIC CONCRETE BLOCK WALLS  
FLOOR ELEVATIONS 574+0 AND 577+0

- LEGEND**
- DESIGNATES NON-FIRE RATED SEISMIC BLOCK WALL BUILT WITH 2-HR OR 3-HR FIRE RATED SEISMIC BLOCK.
  - DESIGNATES 3-HR FIRE RATED SEISMIC BLOCK WALL BUILT WITH 2-HR FIRE RATED SEISMIC BLOCK w/ MORTAR OR GROUT FILLED CELLS.
  - DESIGNATES 3-HR FIRE RATED SEISMIC BLOCK WALL BUILT WITH 3-HR FIRE RATED SEISMIC BLOCK.
  - DESIGNATES 3-HR FIRE RATED SEISMIC SHIELD BLOCK WALL BUILT WITH 2-HR FIRE RATED SEISMIC SHIELD BLOCK w/ GROUT FILLED CELLS.

8203090746

NO.	DESCRIPTION	DATE	BY	CHKD.
1	REVISED WALL DIMENSIONS			
2	REVISED PLAN - WERE VARIOUS REVISIONS			
3	REVISED PLAN - WERE VARIOUS REVISIONS			
4	REVISED WALL DIMENSIONS			
5	REVISED FLOOR DRAIN TUNNEL			
6	REVISED WALL DIMENSIONS			
7	REVISED WALL DIMENSIONS			
"NUCLEAR SAFETY RELATED"  
DUKE POWER COMPANY  
CATAWBA NUCLEAR STATION UNITS 1 & 2  
AUXILIARY BUILDING  
ARCHITECTURAL  
CONCRETE BLOCK WALL DETAILS  
EL 574+0 & EL 577+0



RIDS

8203090746

