


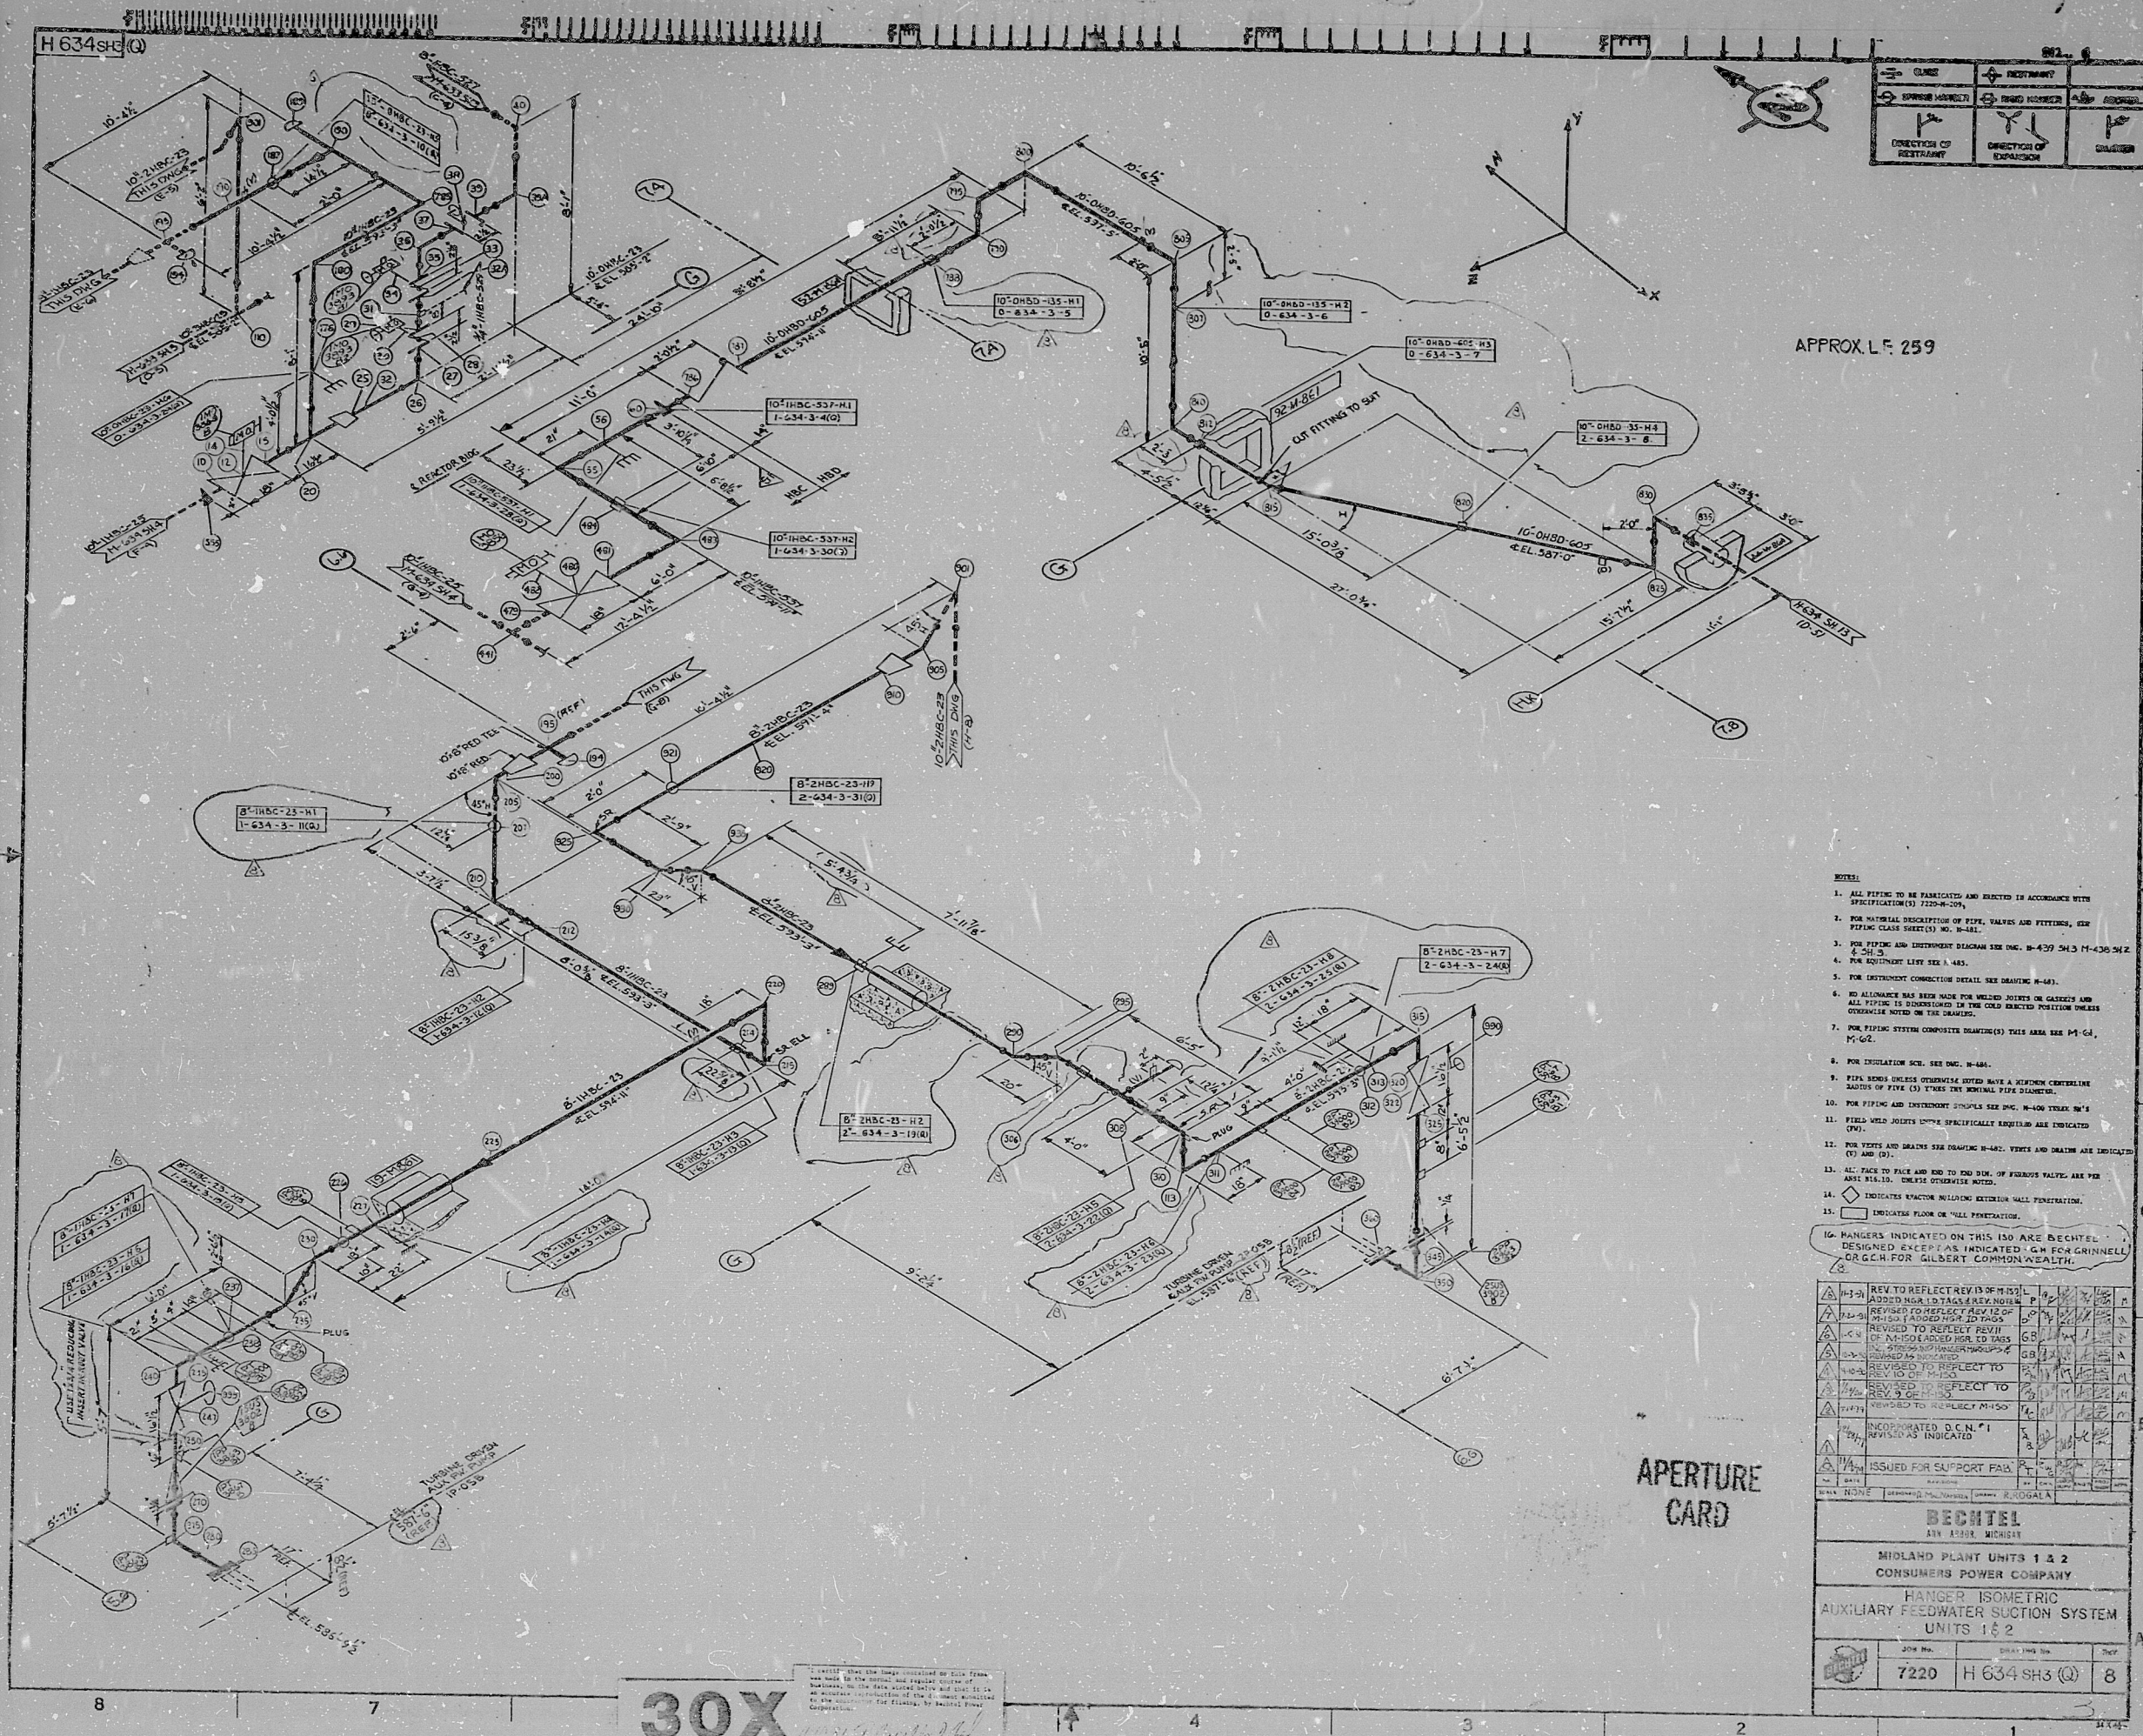

- NOTES:
1. ALL PIPING TO BE FABRICATED AND ERRECTED IN ACCORDANCE WITH SPECIFICATION (S) 7220-H-209.
 2. FOR MATERIAL DESCRIPTION OF PIPE, VALVES AND FITTINGS, SEE FITTING CLASS SPECIFICATION NO. 10-141.
 3. FOR PIPING AND INSTRUMENT SYMBOLS SEE SPEC. 10-439 3413 11-436 3412 2-341 5.
 4. FOR EQUIPMENT LIST SEE 1-445.
 5. FOR INSTRUMENT CONNECTION DETAIL SEE DRAWING 10-441.
 6. NO ALLOWANCE HAS BEEN MADE FOR WELDED JOINTS OR GASKETS AND ALL TYPING IS DISREGARDED IN THE FIELD ERRECTED POSITION UNLESS OTHERWISE NOTED ON THE DRAWING.
 7. FOR PIPING SYSTEM COMPOSITE DRAWING(S) THIS AREA SEE M-1-61, M-1-62.
 8. FOR INSULATION SEE SPEC. 10-441.
 9. PIPE SIZES UNLESS OTHERWISE NOTED HAVE A NOMINAL CENTERLINE RADIUS OF PIPE (S) THREE TIMES THE NOMINAL PIPE DIAMETER.
 11. FIELD WELD JOINTS UNLESS SPECIFICALLY INDICATED ARE INDICATED (FW).
 12. FOR VENTS AND DRAINS SEE DRAWING 10-441. VENTS AND DRAINS ARE INDICATED (V) AND (D).
 13. ALL PIPES TO PUMP AND TO THE DOWNSIDE OF PUMPS VALVES ARE PER ANSI B16.10. UNLESS OTHERWISE NOTED.
 15. INDICATES FLOOR OR WALL PENETRATION.
 16. HANGERS INDICATED ON THIS ISD ARE BECHTEL DESIGNED EXCEPT AS INDICATED. G.M. FOR GRINNELL OR GCH FOR GILBERT COMMONWEALTH.


BECHTEL			
MIDLAND PLANT UNITS 1 & 2			
CONSUMERS POWER COMPANY			
HANGER ISOMETRIC			
AUXILIARY FEEDWATER SUCTION SYSTEM			
UNITS 1 & 2			
7220	H 634 SH3 (Q)	8	

RIDS

8203100112

