


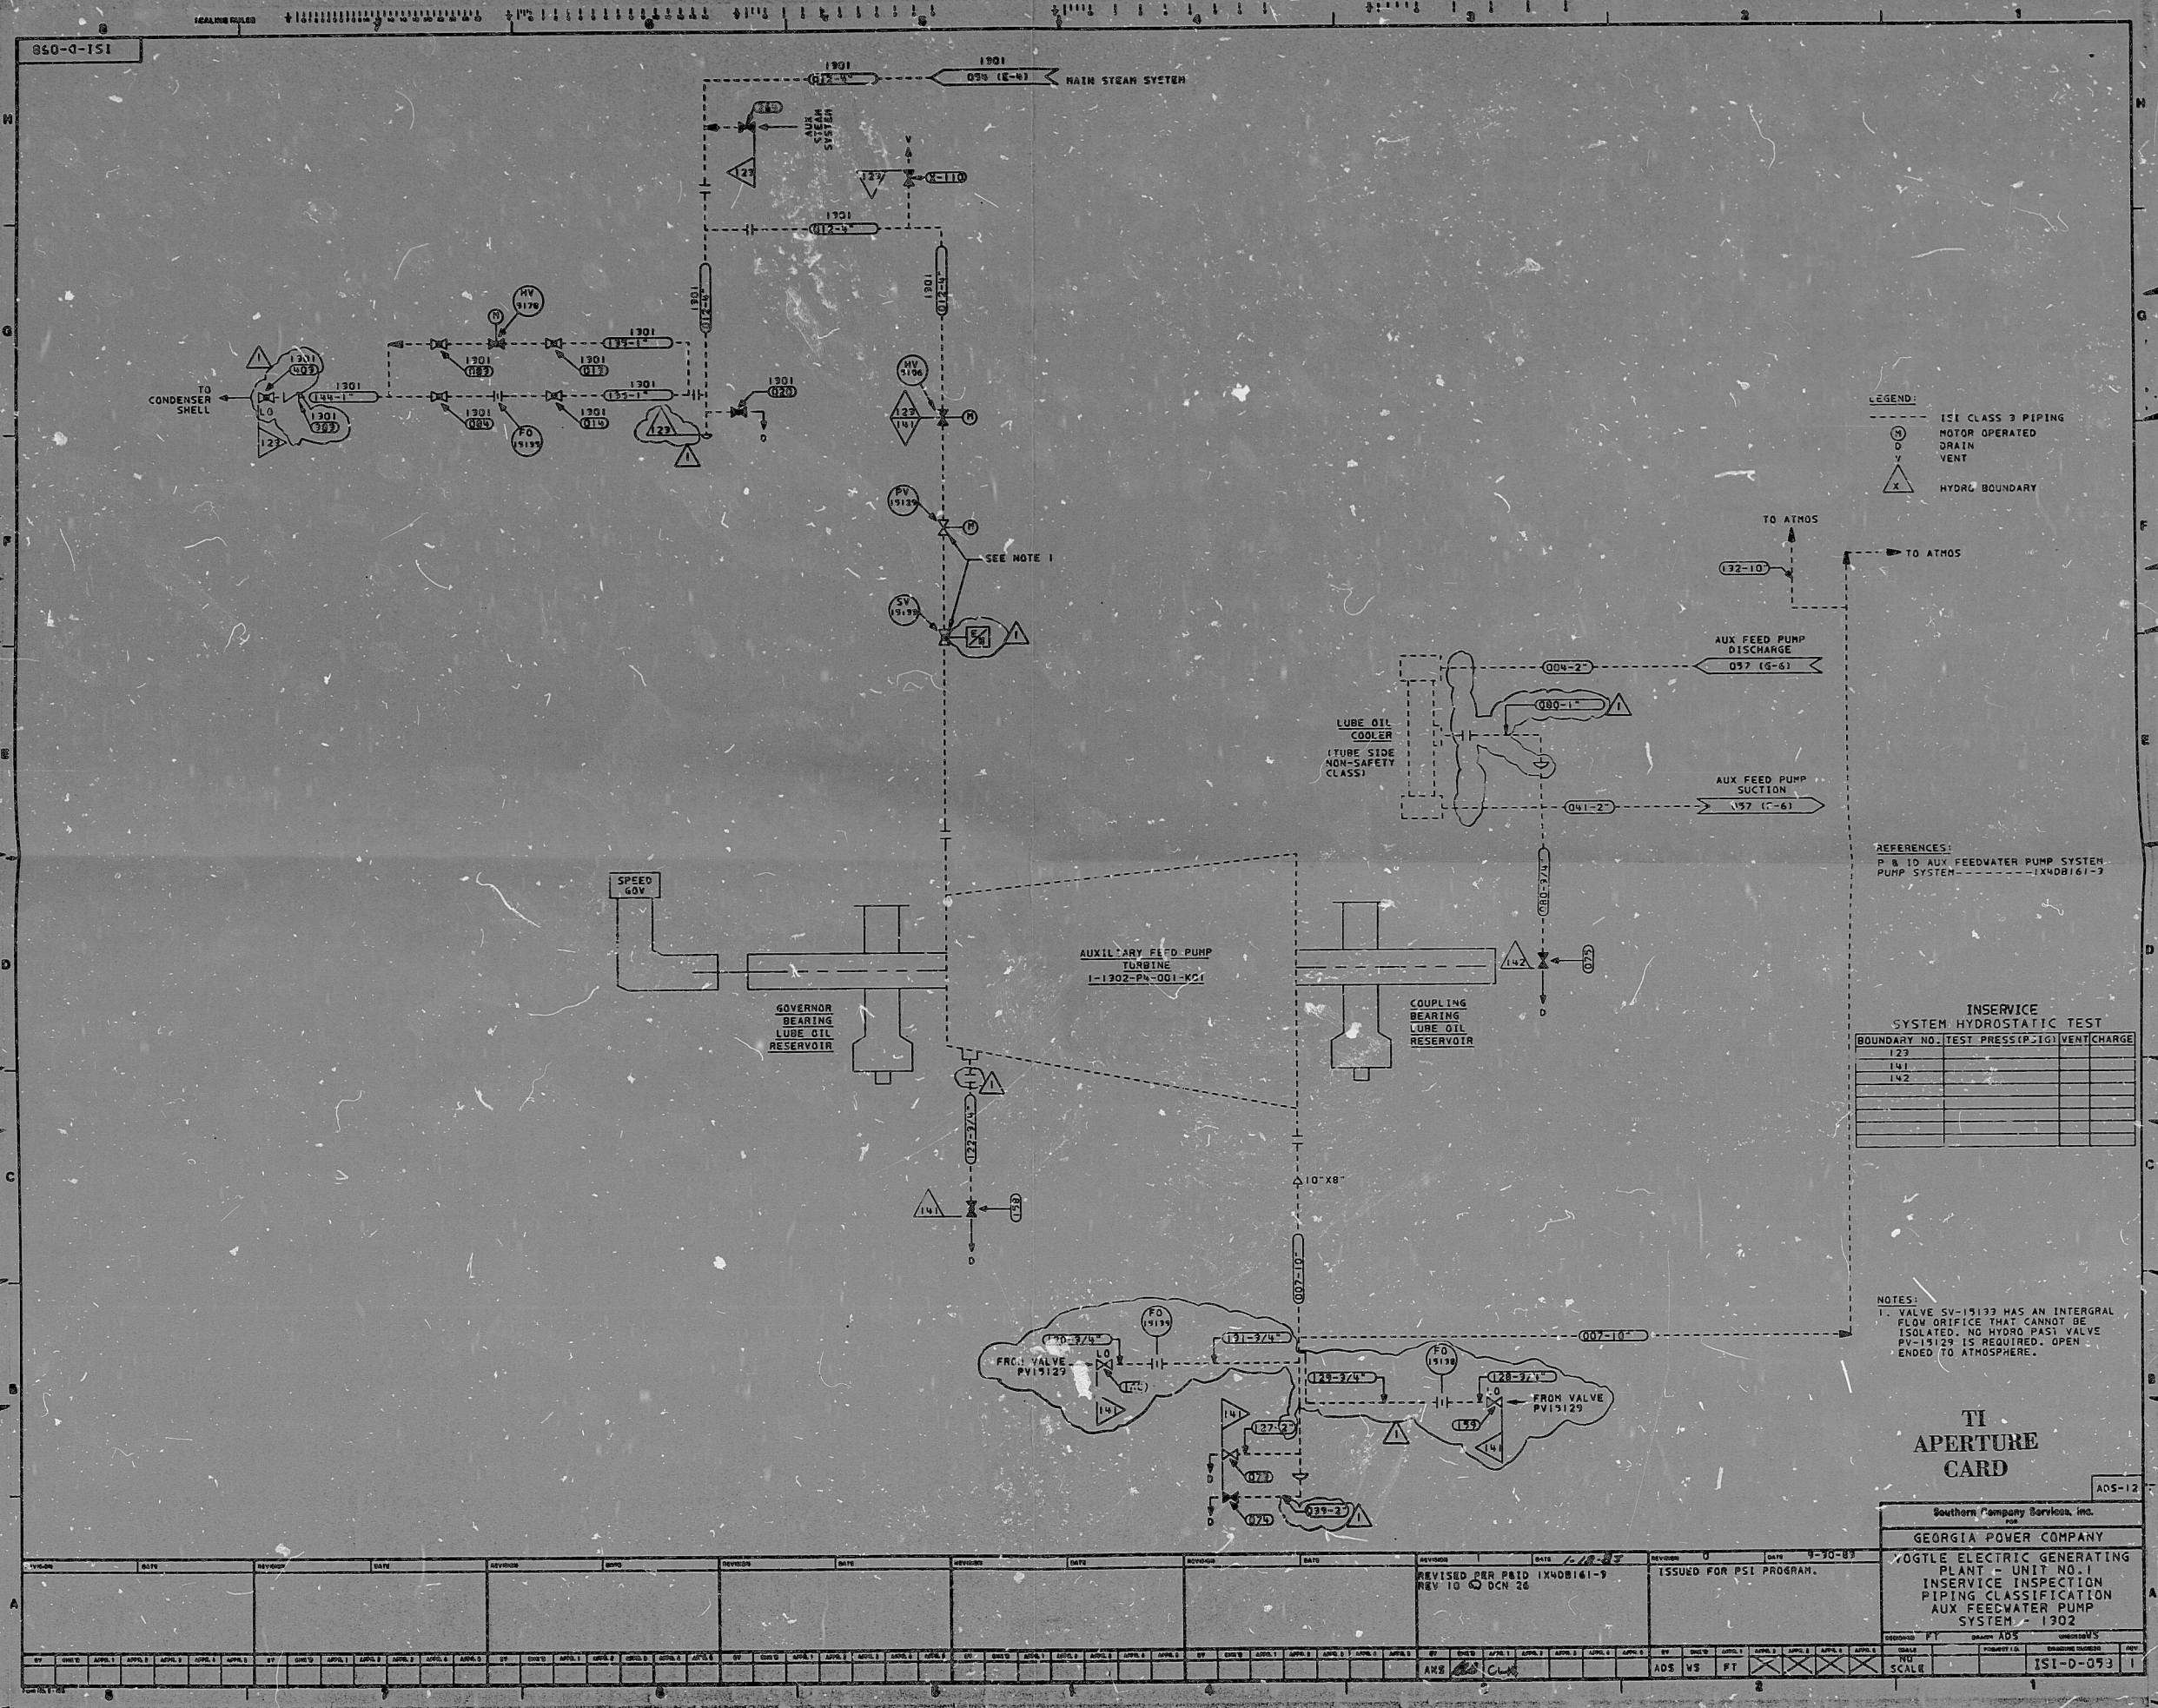

PDR RIDS

85Q3Q6Q466

