


This drawing and the design it contains are the property of BECHTEL. They are hereby loaned and all the necessary approvals and clearances must be obtained by the recipient before any reproduction, copying, alteration, or use in any way is made. The recipient shall be responsible for the return of this drawing to the lender.

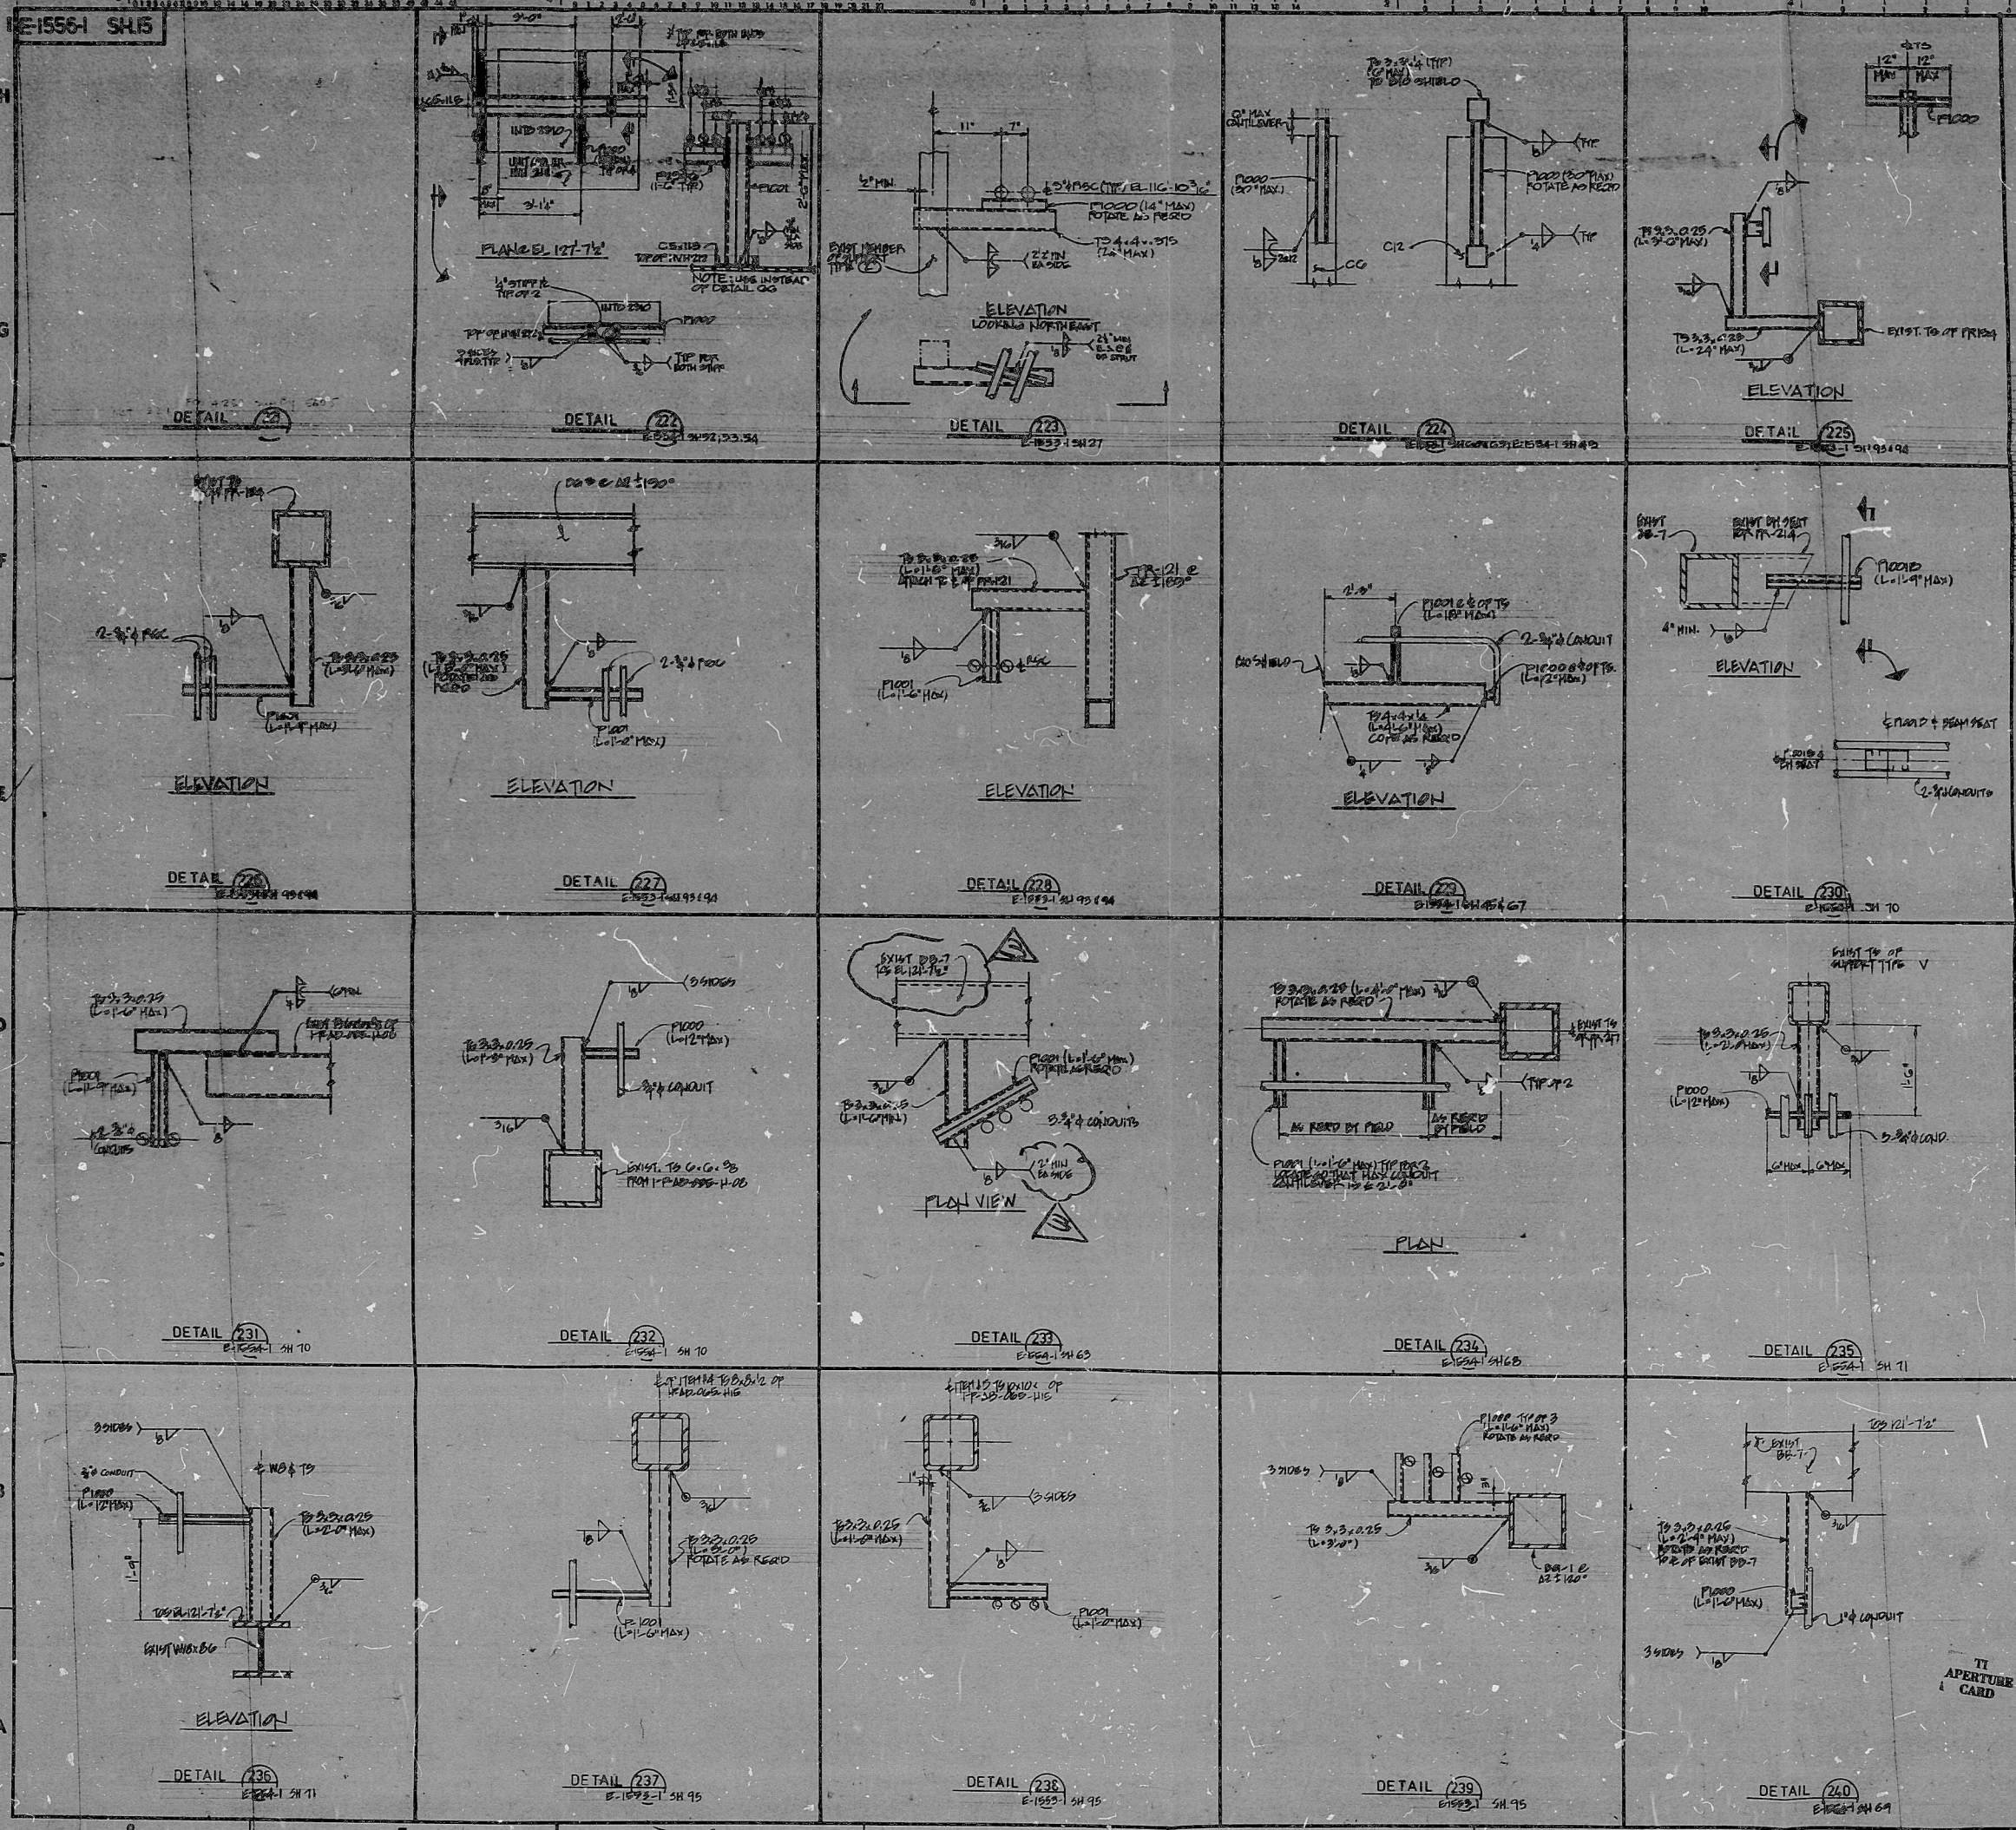

NOTES




BECHTEL
SAN FRANCISCO

PUBLIC SERVICE ELECTRIC AND GAS COMPANY
HOPE CREEK GENERATING STATION

RACEWAY SECTIONS & DETAILS
REACTOR BLDG AREA 17


SHEET 15

PDR RIDS

8503060471

