


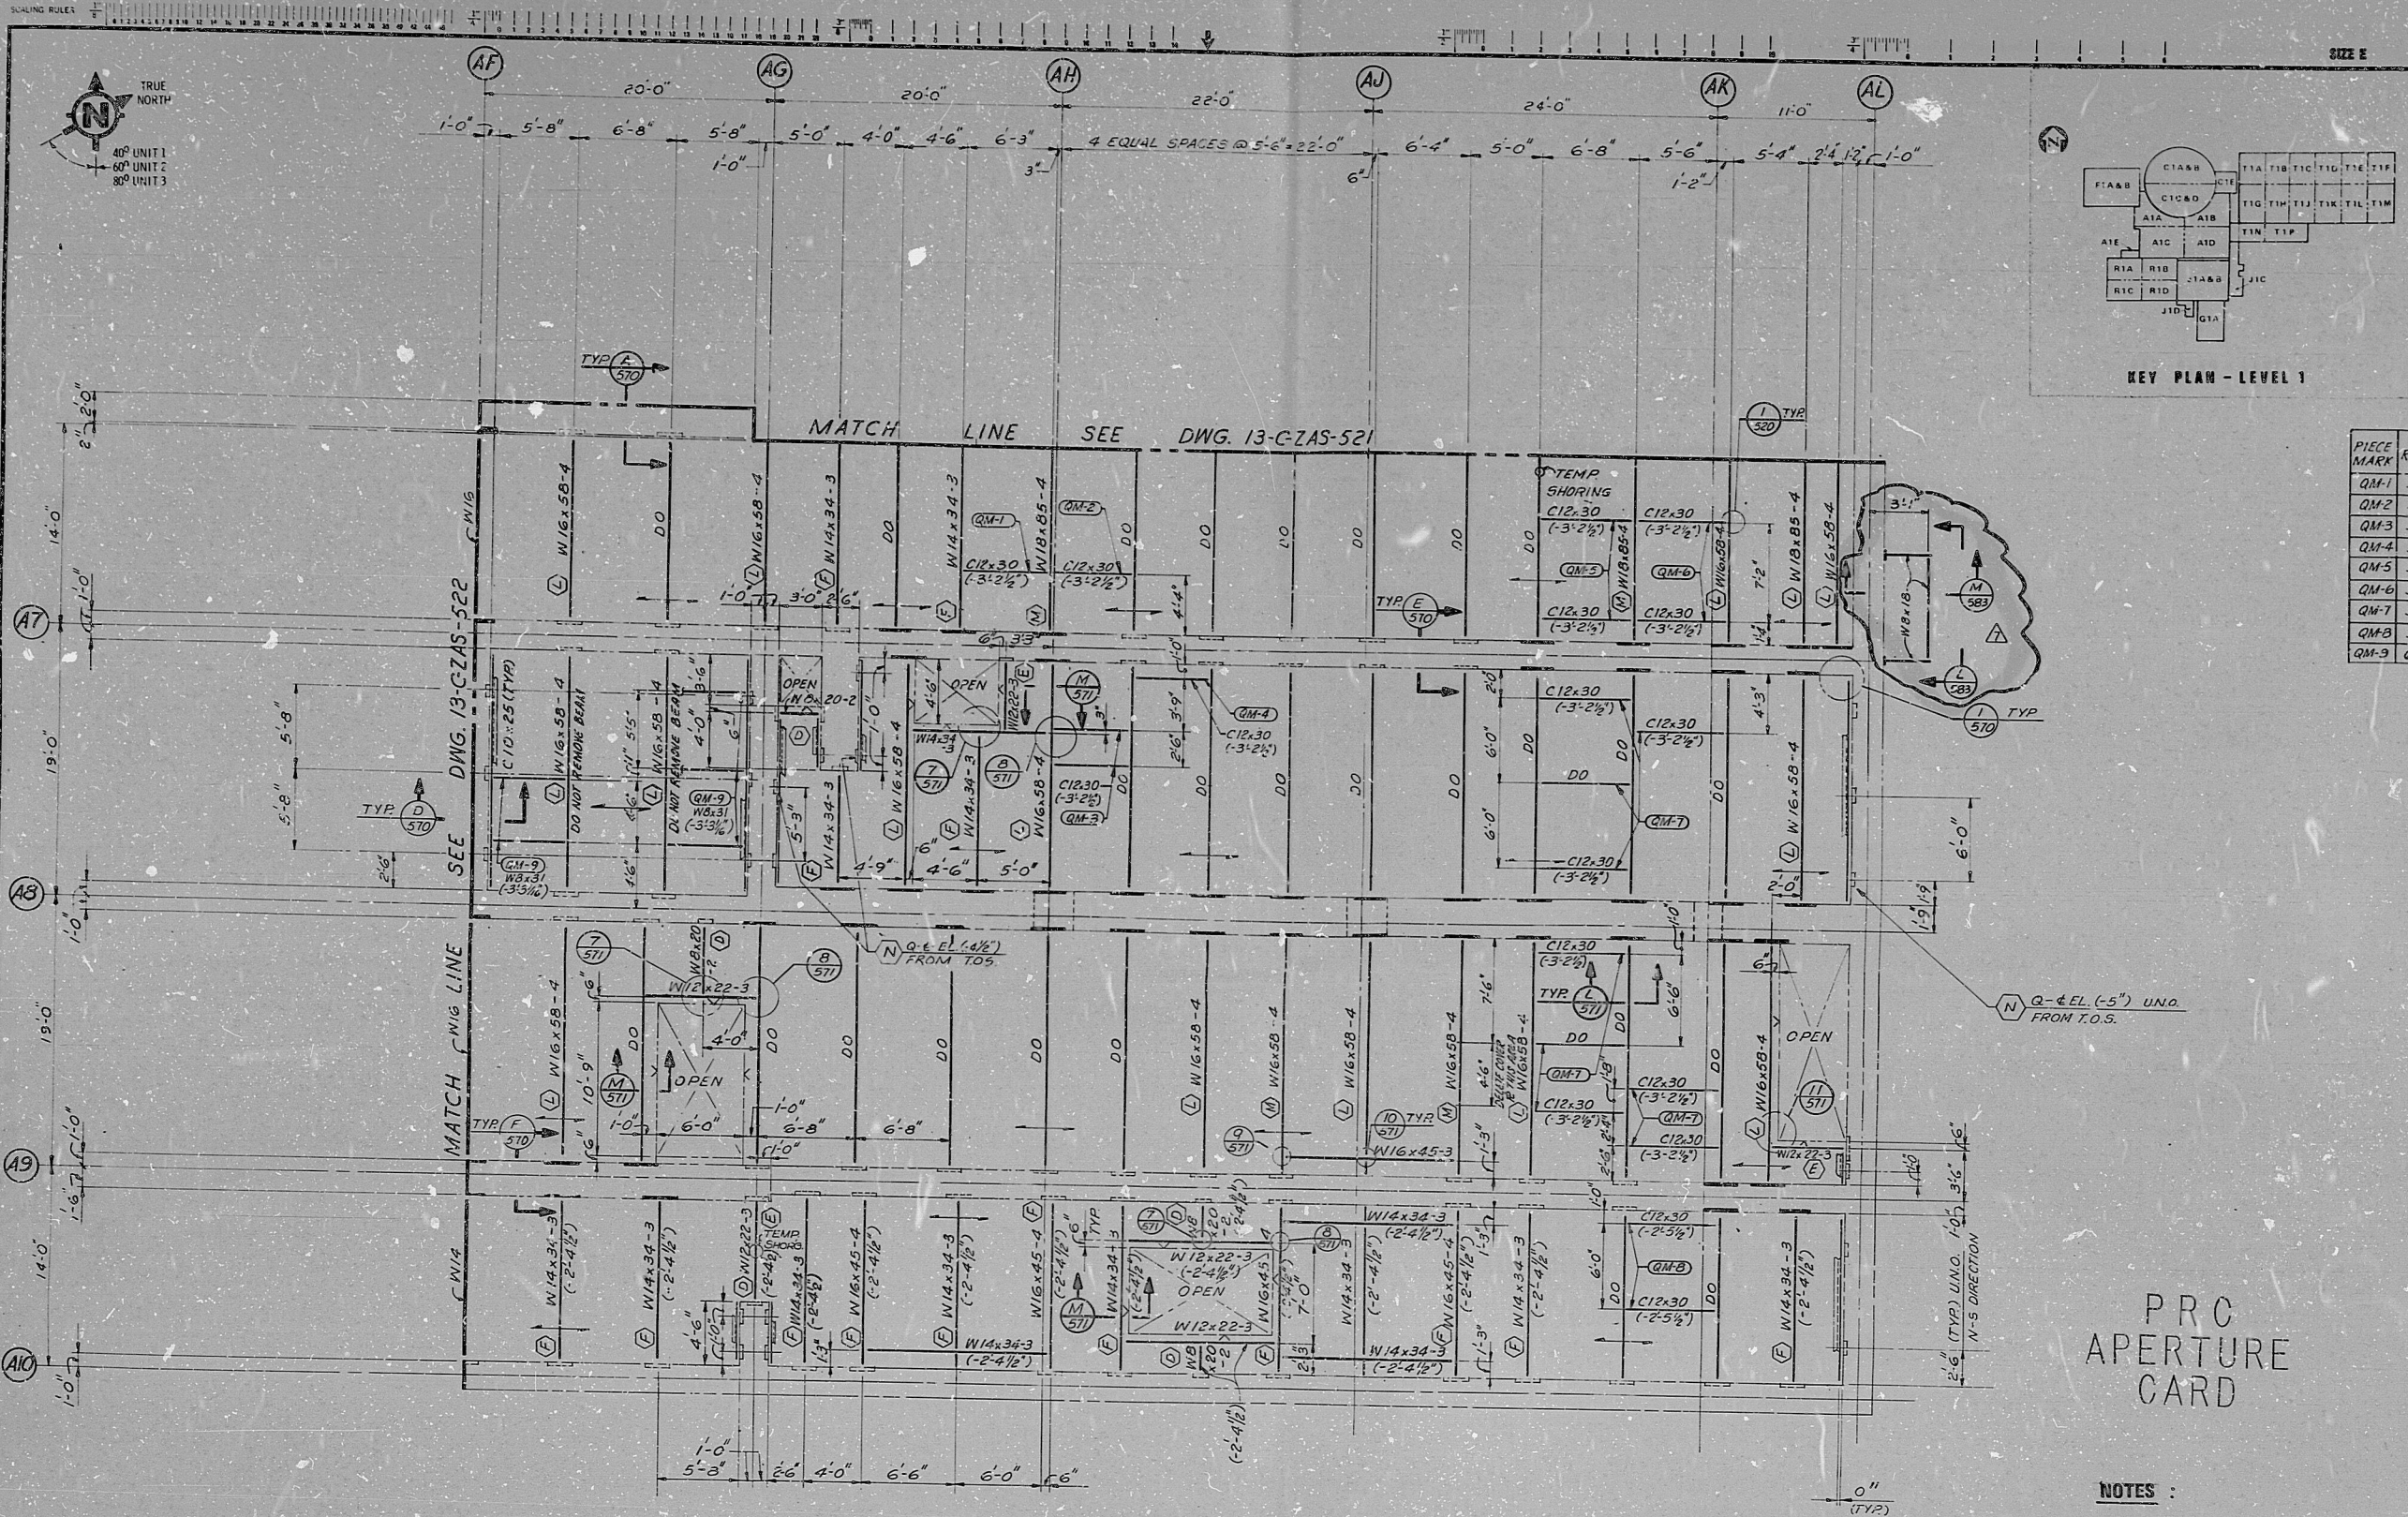

PRC
APERTURE
CARD

NOTES :

1. FOR NOTES AND LEGEND SEE DRAWING 13-C-ZAS-500.
2. T.O.S. FOR BEAMS WITH COVER PLATES SHALL BE TOP OF COVER PLATE.
3. ALL BEAMS BETWEEN COLUMN LINES AS 1' TO 10' SHALL BE REMOVED AFTER THE SLAB AT EL. 100'-0" HAS BEEN CAST. THESE BEAMS ARE FOR TEMPORARY SHORING PURPOSES ONLY. QUALITY CLASS "S".
4. ALL CHANNELS SUPPORTING DECKING SHALL HAVE 1/2" X 8" X 16" WELDED STUDS, SPACED AT 12" O.C. ON USUAL CASE. SHIP LOOSE FOR FIELD INSTALLATION.

STEEL FRAMING PLAN FOR EL. 100'-0"
T.O.S. EL. (-3'-1 1/2") UNLESS NOTED

CERTIFIED DRAWING

REV. 74 SUBSEQUENT REV. 51 12/74 REV. 4 THRU 6 BY 11951				INCORP. DCN. #13 INCORP. DCN. #12 INCORP. DCN. #10, 11		INCORP. DCN. #7, 8, 9 INCORP. DCN. #4, 5, 6, 10, 11 INCORP. DCN. #3 INCORP. DCN. #1, 2, 12, 13, 14,100		ARIZONA NUCLEAR POWER PROJECT PALO VERDE NUCLEAR GENERATING STATION		AUXILIARY BUILDING AREA AND STRUCTURAL STEEL FRAMING PLAN FOR EL. 100'-0"		SCALE 1/8" = 1'-0" 13497 13-C-ZAS-523 7	
--	--	--	--	--	--	--	--	---	--	---	--	--	--

RIDS

8203240382

