
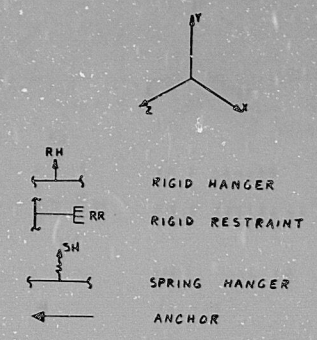


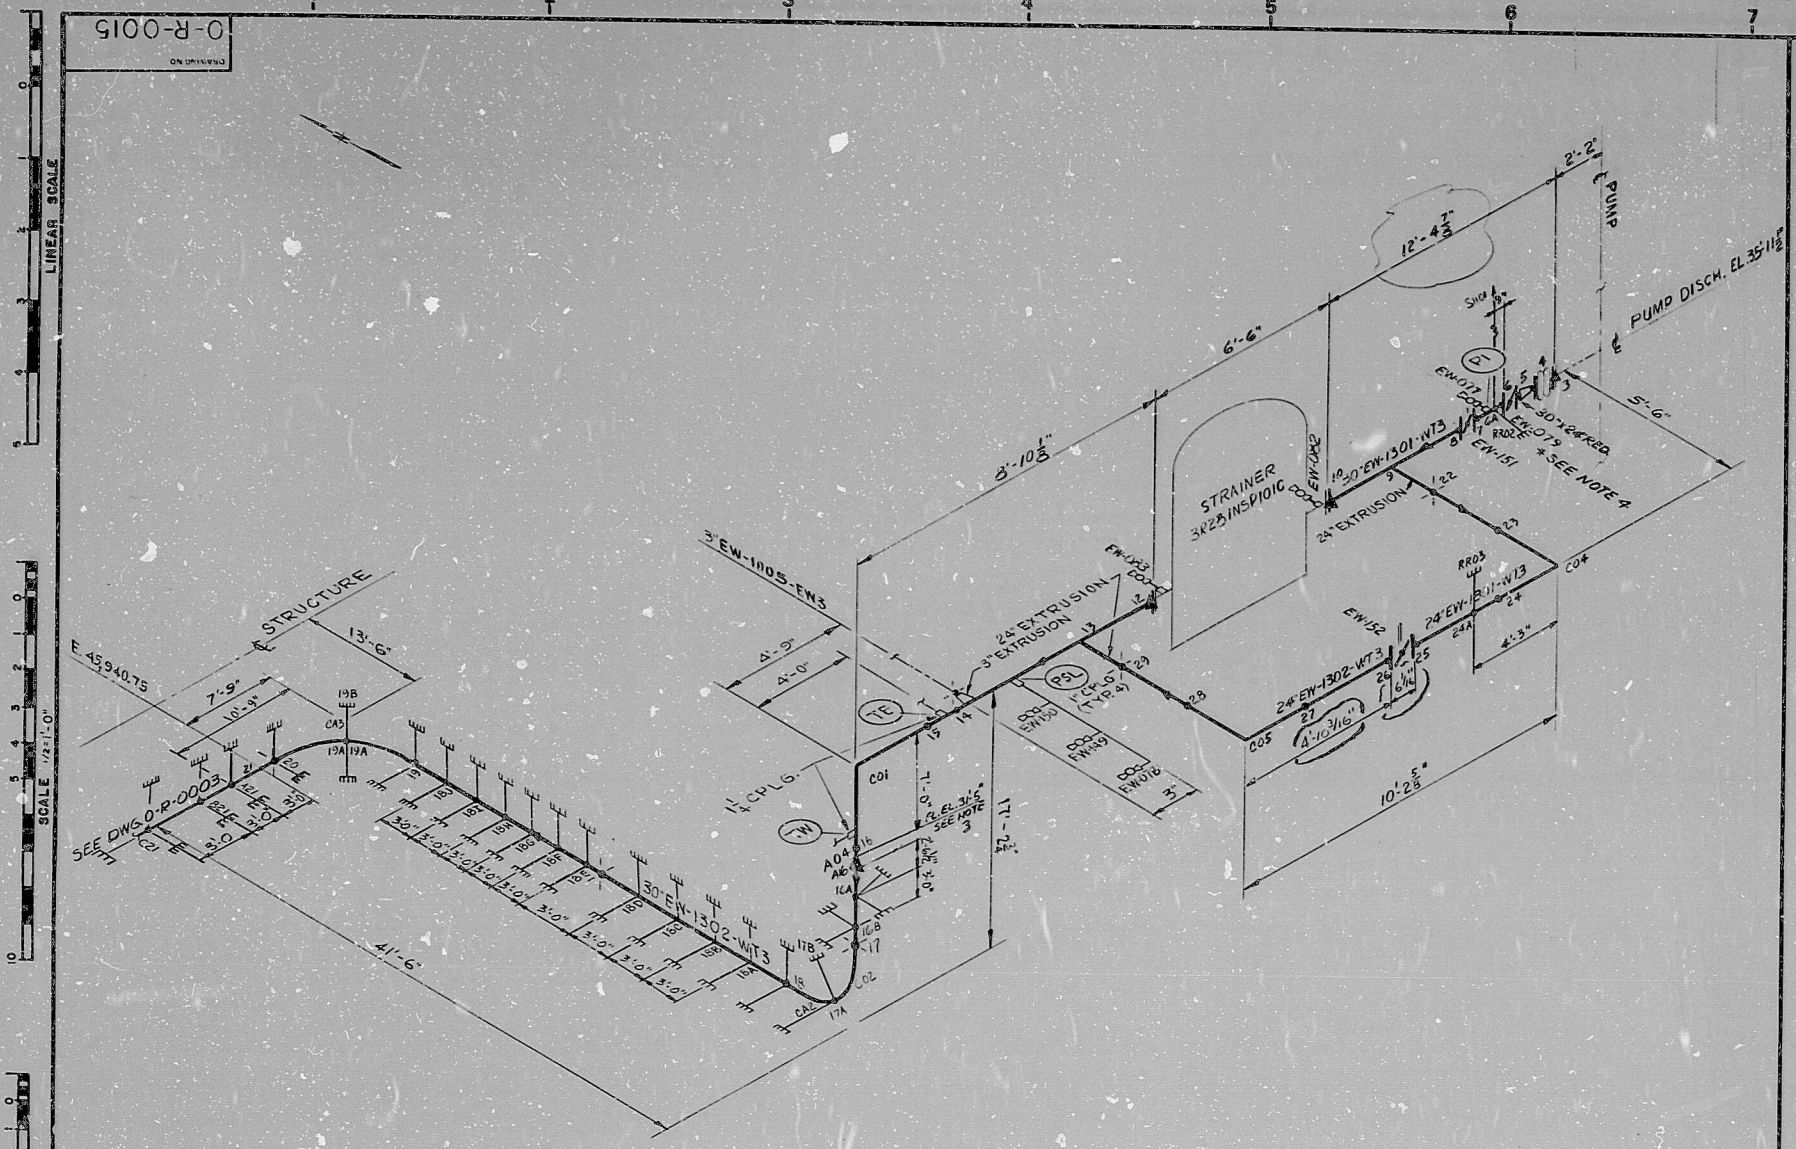

1. CALCULATION NO. IS 3R289RC045
2. 30\"/>


REFERENCE:
COMPOSITE PIPING DWG O-P-0078

PRC
APERTURE
CARD

INFORMATION
THIS DOCUMENT IS
SUBJECT TO REVISION
WITHOUT NOTIFICATION
TO THE USER OR THIS
COPY

NO.	DATE	DESCRIPTION	BY	CHKD.	DATE
1	7-28-78	ADDED NOTES & HANGERS & CHANGED DIMS. AS NOTED	YJB	HJ	JES
2	12-6-78	INITIAL ISSUE FOR STRESS ANALYSIS	YJB	HJ	JES

BROWN & ROOT INC.
MICROFILM SERVICES
MONDAY, AUG. 7 1978

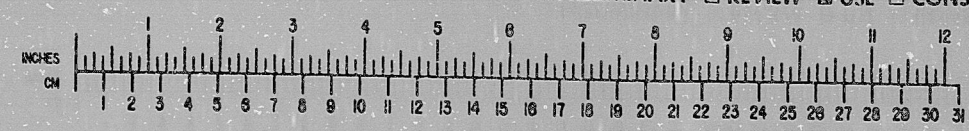

Brown & Root, Inc.
Engineers - Constructors
HOUSTON, TEXAS

SOUTH TEXAS PROJECT
STRESS ISOMETRIC
ESSENTIAL COOLING WATER
SUPPLY SYSTEM 1C
UNIT 1

PKG. NO. 185	SUFF. 052
CR-0241	NONE
3-R 28	
O-R-0015-B	

☐ PRELIMINARY ☐ REVIEW ☒ USE ☐ CONSTRUCTION

RIDS

6203260044

