
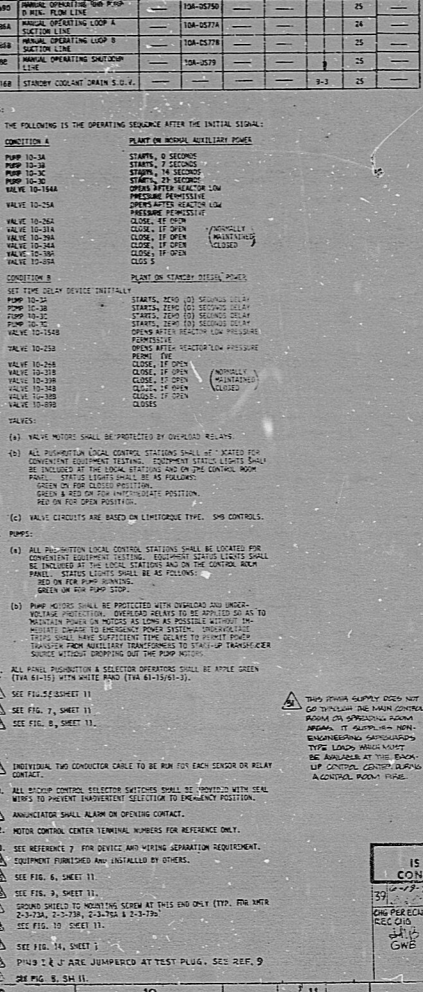
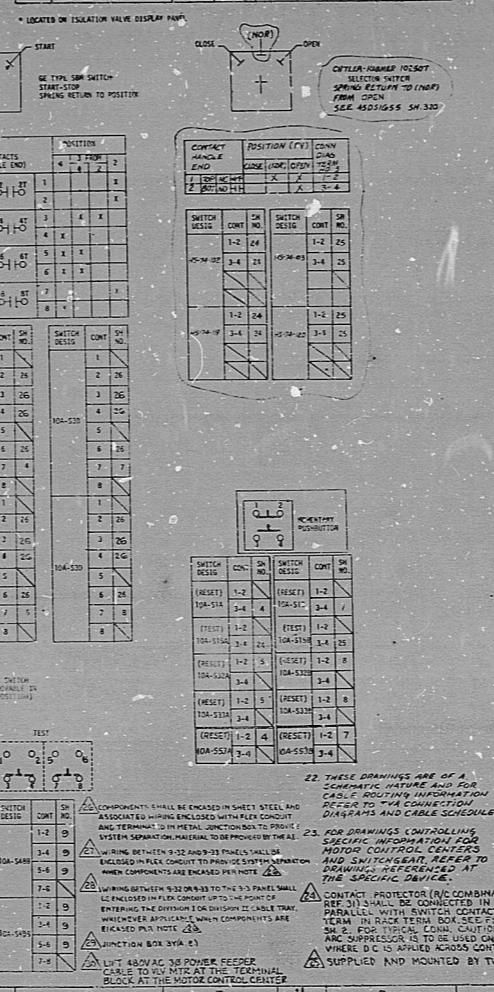





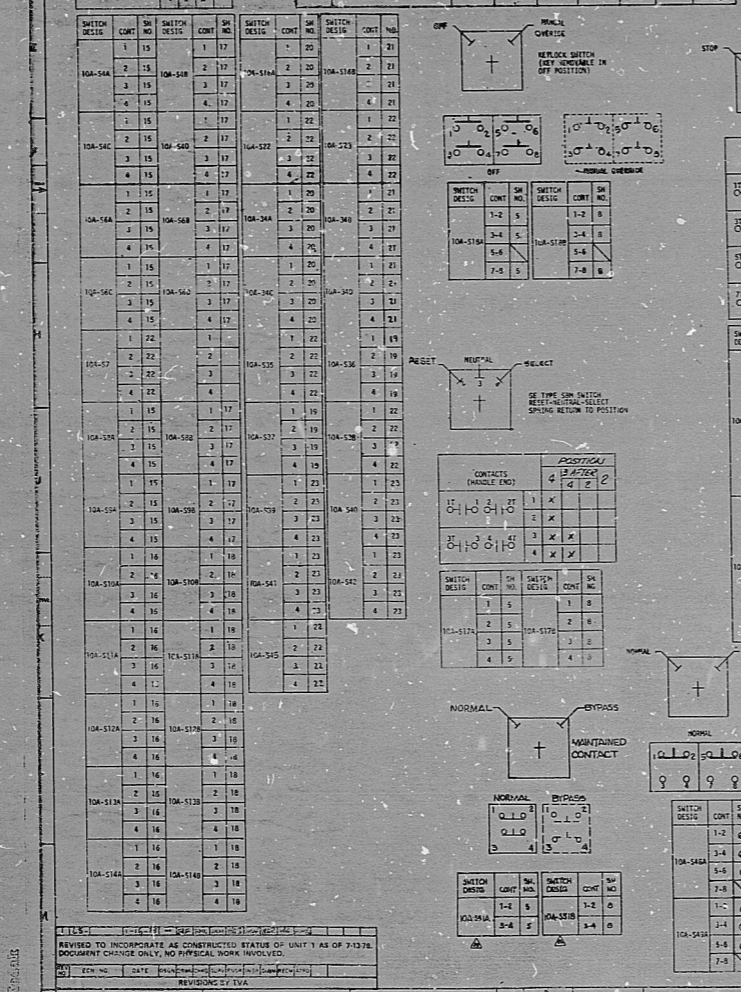

TERA APERTURE CARD

8011250437

17

SPEC. HAND.

F

8011250437-

TO BE TITLED

