



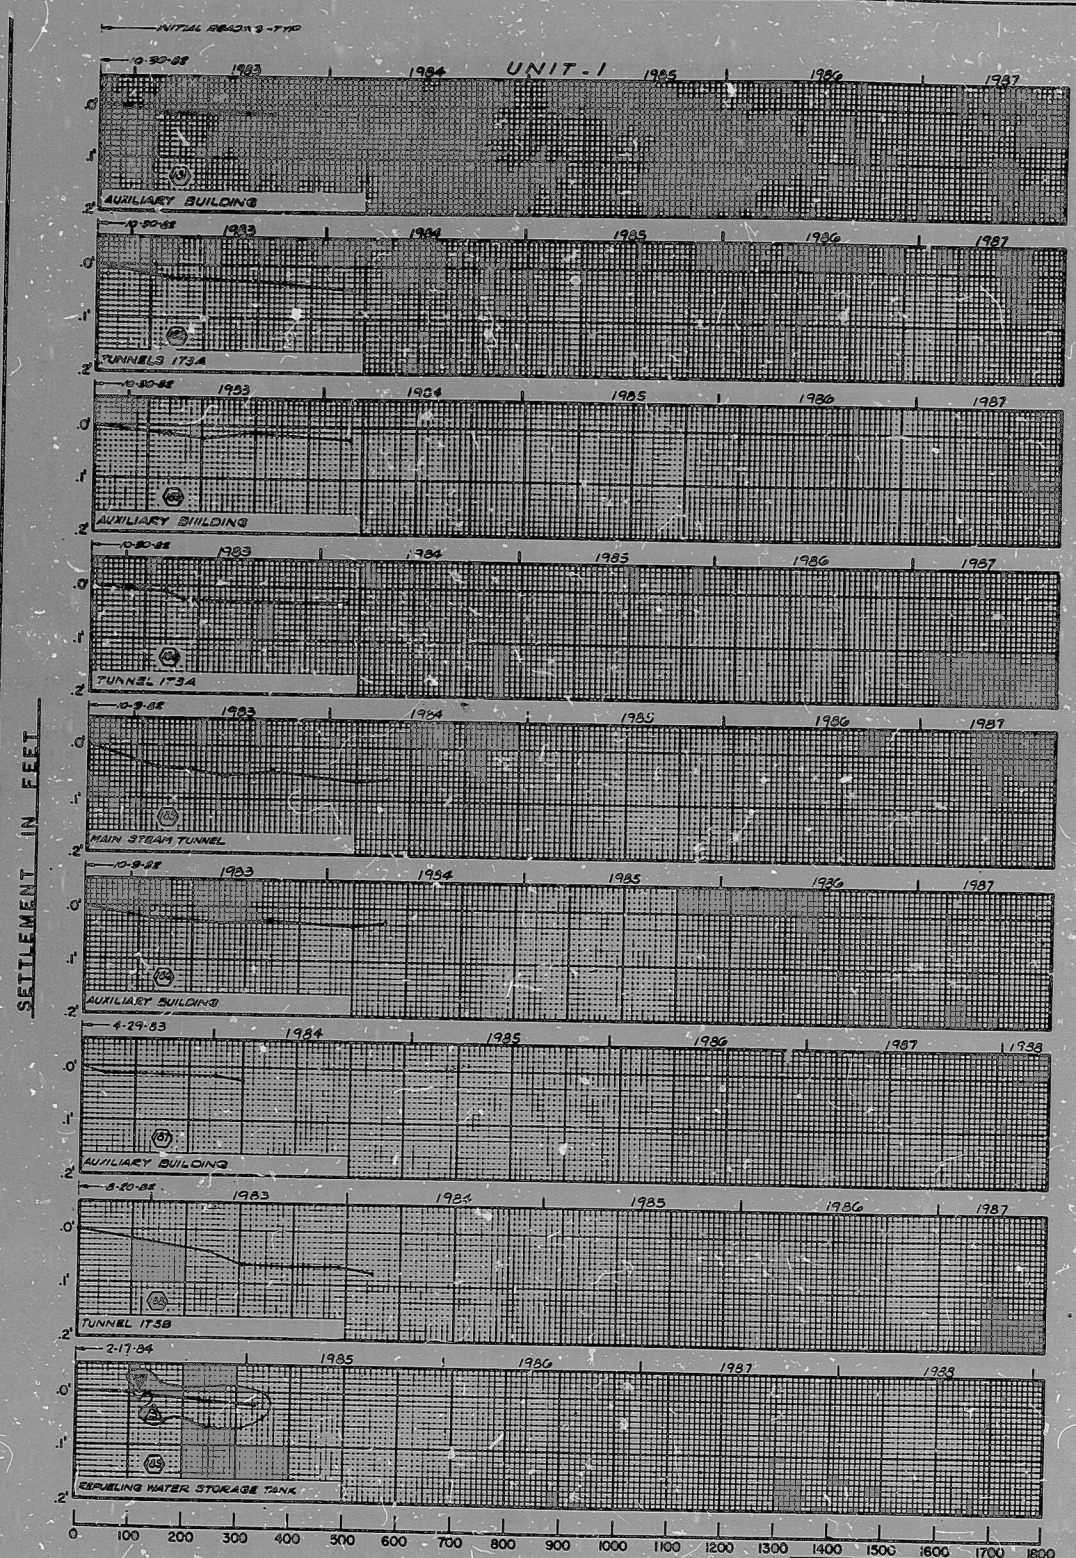

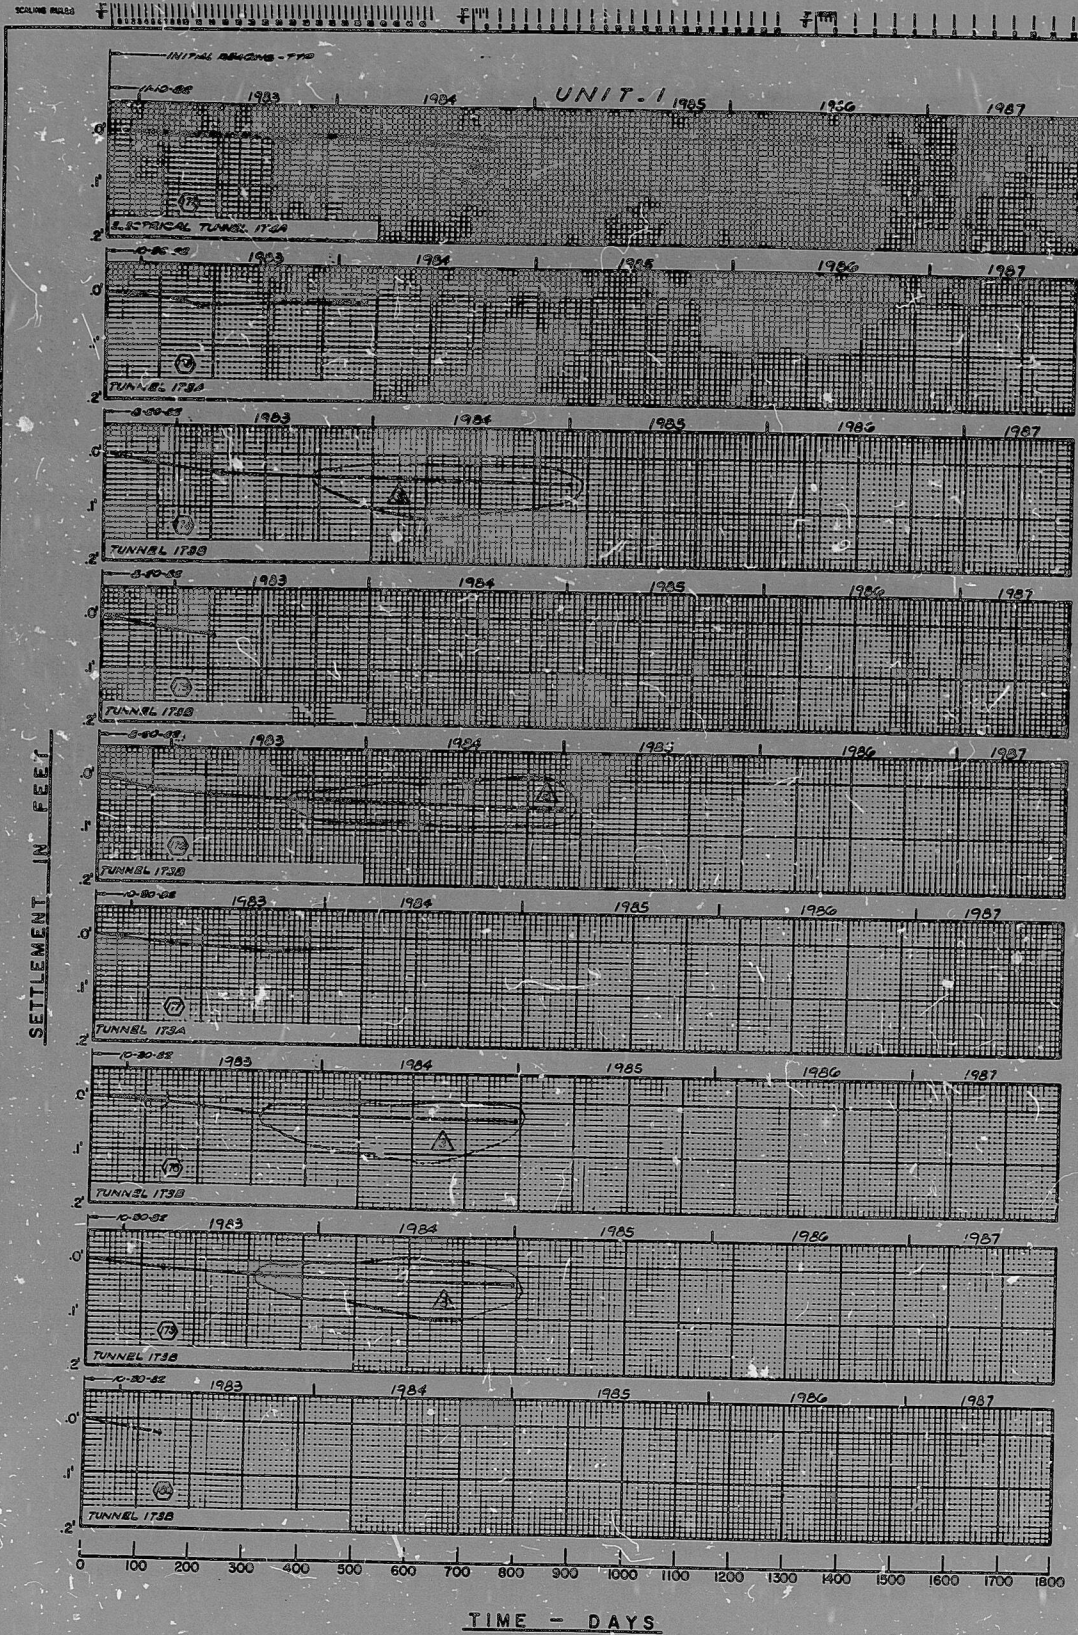

PDR RIDS

85Q321Q48Q

