






RIDS

8308109065

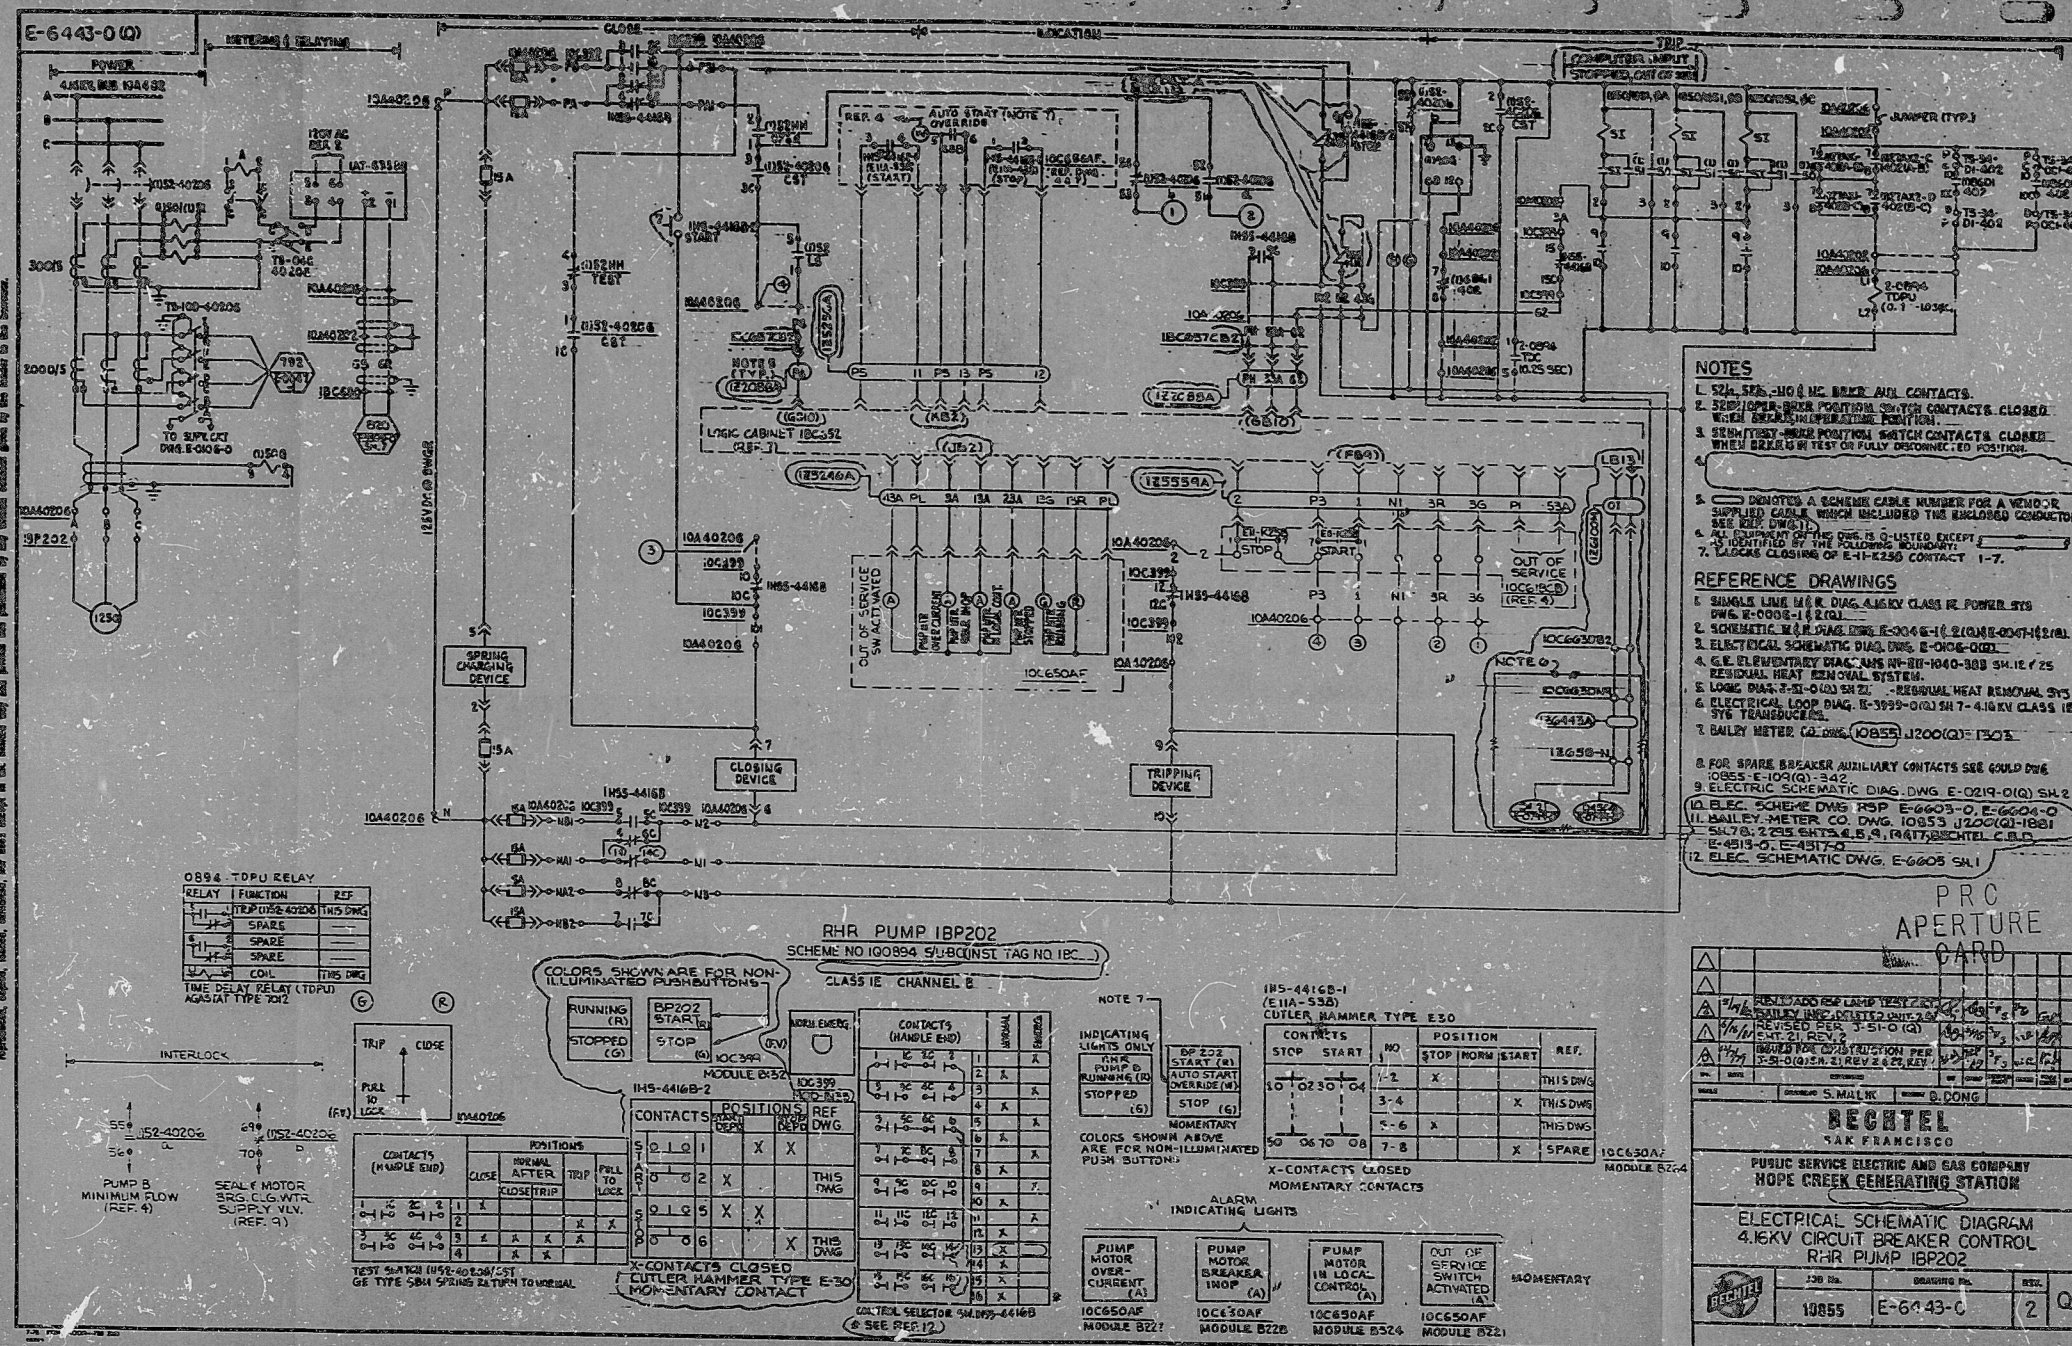