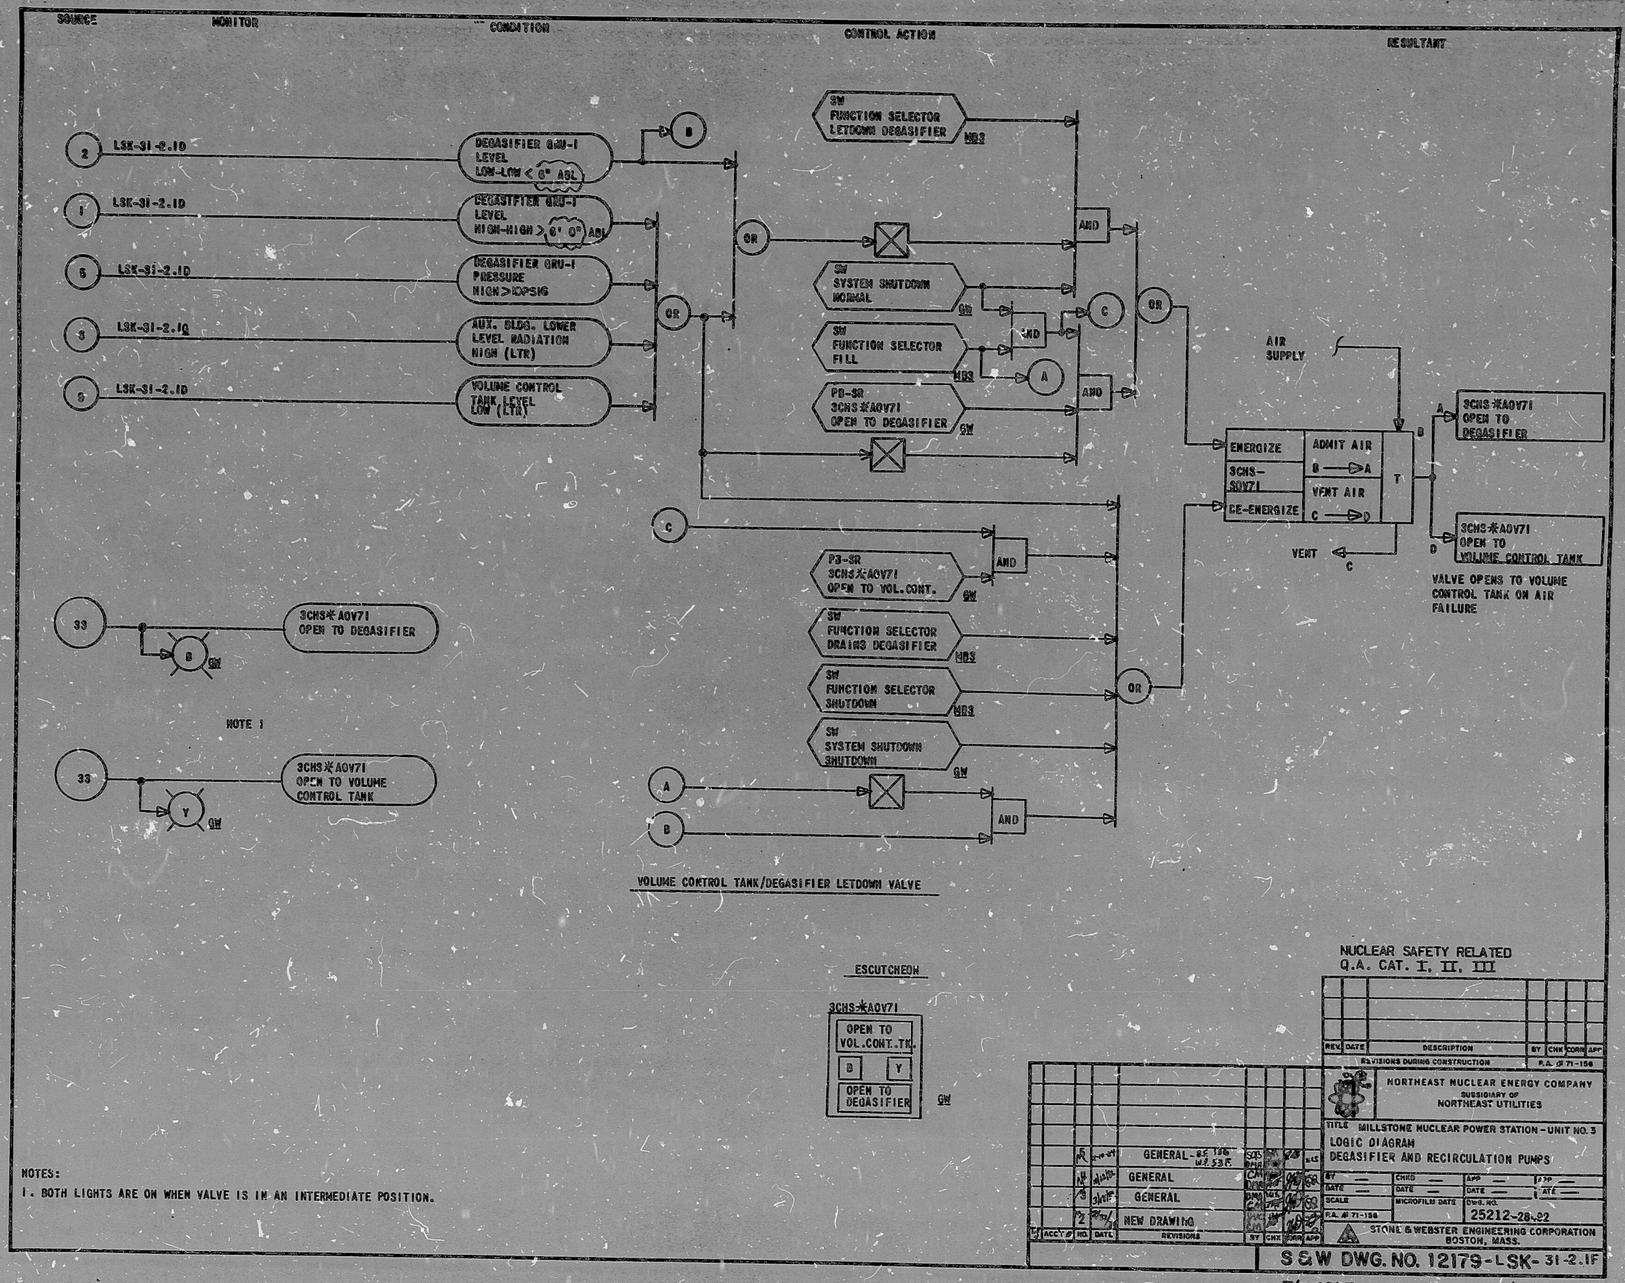

NOTES:
1. BOTH LIGHTS ARE ON WHEN VALVE IS IN AN INTERMEDIATE POSITION.

NUCLEAR SAFETY RELATED
Q.A. CAT. I, II, III

REV.	DATE	DESCRIPTION	BY	CHK	CORR	APP
		REVISIONS DURING CONSTRUCTION				P.A. # 71-156

NORTHEAST NUCLEAR ENERGY COMPANY
SUBSIDIARY OF
NORTHEAST UTILITIES

TITLE: MILLSTONE NUCLEAR POWER STATION - UNIT NO. 3
LOGIC DIAGRAM
DEGASIFIER AND RECIRCULATION PUMPS

BY	CHKD	APP
DATE	DATE	DATE
SCALE	MICROFILM DATE	DWG. NO. 25212-28-02
P.A. # 71-156		

STONE & WEBSTER ENGINEERING CORPORATION
BOSTON, MASS.

ACCT #	NO.	DATE	REVISIONS	BY	CHK	CORR	APP
	4	5/75	GENERAL - 85 TAG W# 53F	SAS	BAG	CAW	MJC
	3	3/75	GENERAL	DMS	DATE	CHK	QA
	2	2/75	GENERAL	DMS	DATE	CHK	QA
	1	8/74	NEW DRAWING	DMS	DATE	CHK	QA

S&W DWG. NO. 12179-LSK-31-2.1F

T/O 3337 T/O 3304A

TI APERTURE CARD

PDR RIDS

8506260623

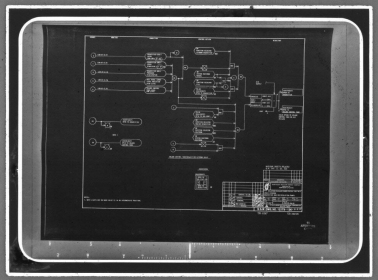

MMM 5824 — FILMSORT* Brand Aperture & Camera Cards and DUPLICARD* Brand Copy Cards — Product of 3M Company, St. Paul, Minn.