


INFORMATION COPY

SIZE E

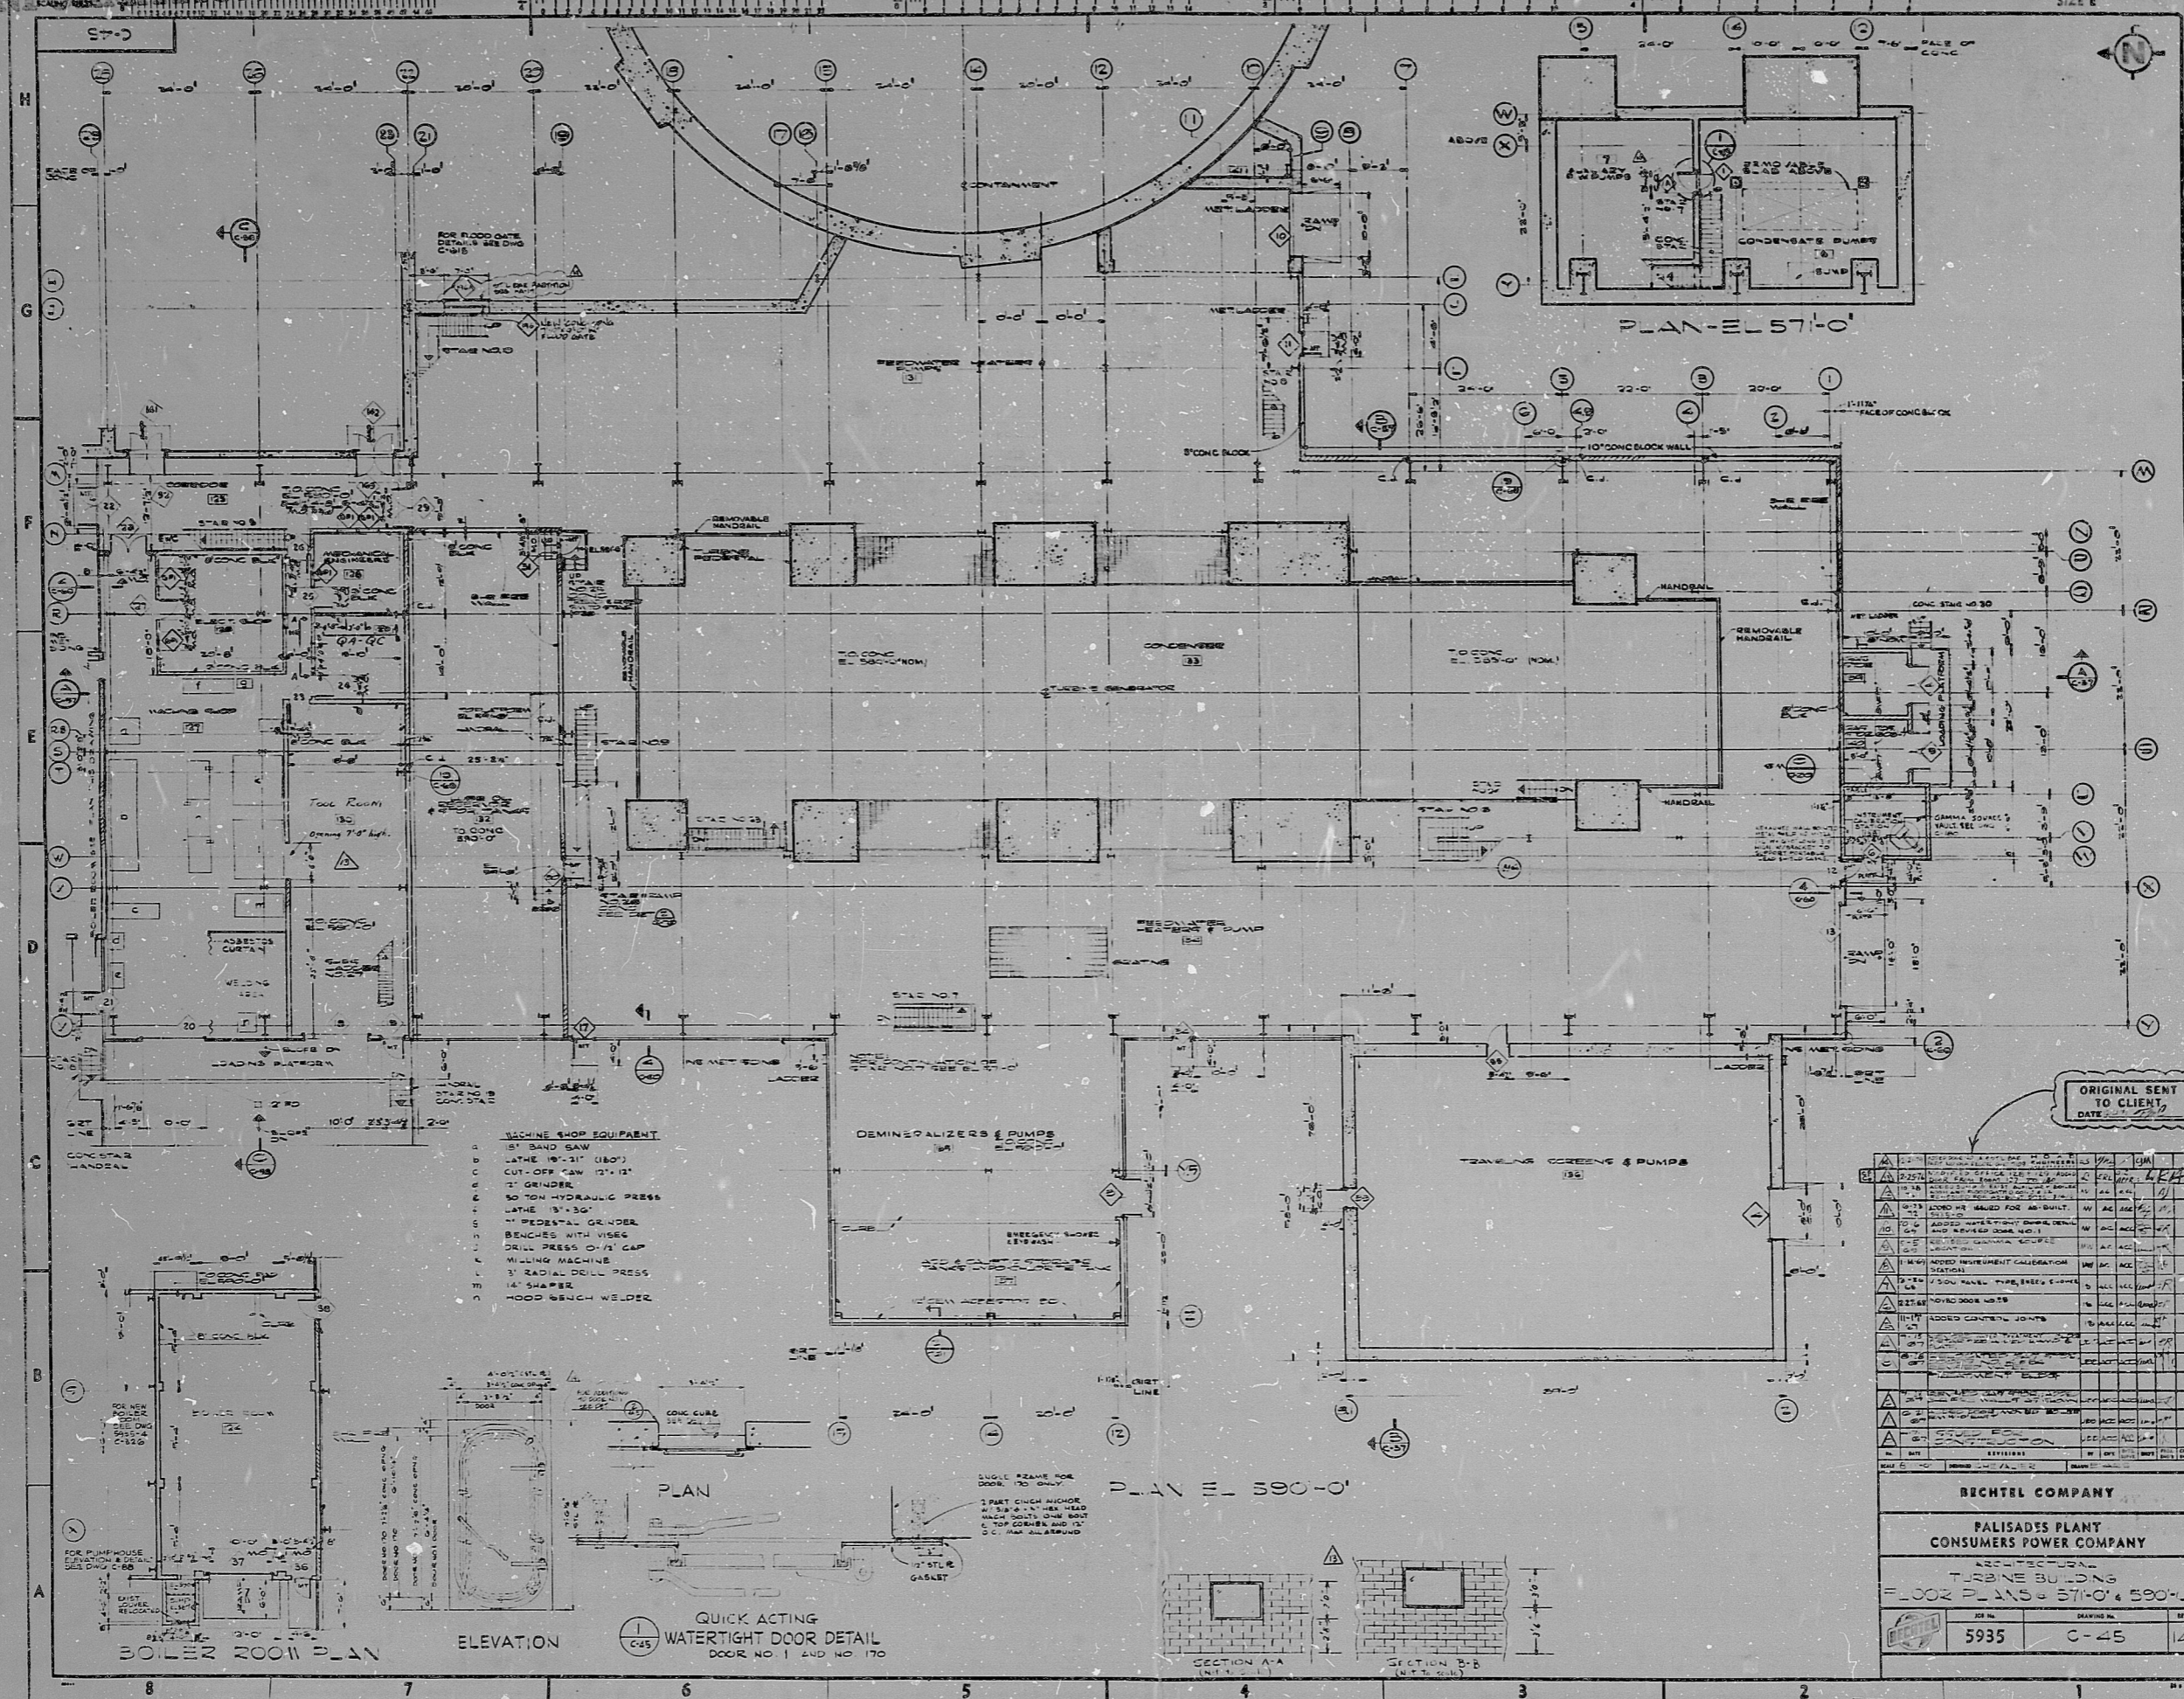

ORIGINAL SENT TO CLIENT DATE 11/2/50

NO.	DESCRIPTION	DATE	BY
1	REVISION		
2	REVISION		
**BECHTEL COMPANY**  
**PALISADES PLANT**  
**CONSUMERS POWER COMPANY**  
 ARCHITECTURAL  
 TURBINE BUILDING  
 FLOOR PLANS - 57'-0" & 59'-0"  
 JOB NO. 5935 DRAWING NO. C-45 BY 14

TERA APERTURE CARD

8012080605

17  
85  
85  
11  
17

17  
85  
85  
11  
17

RIDS PDR

8012080605

