


INFORMATION COPY

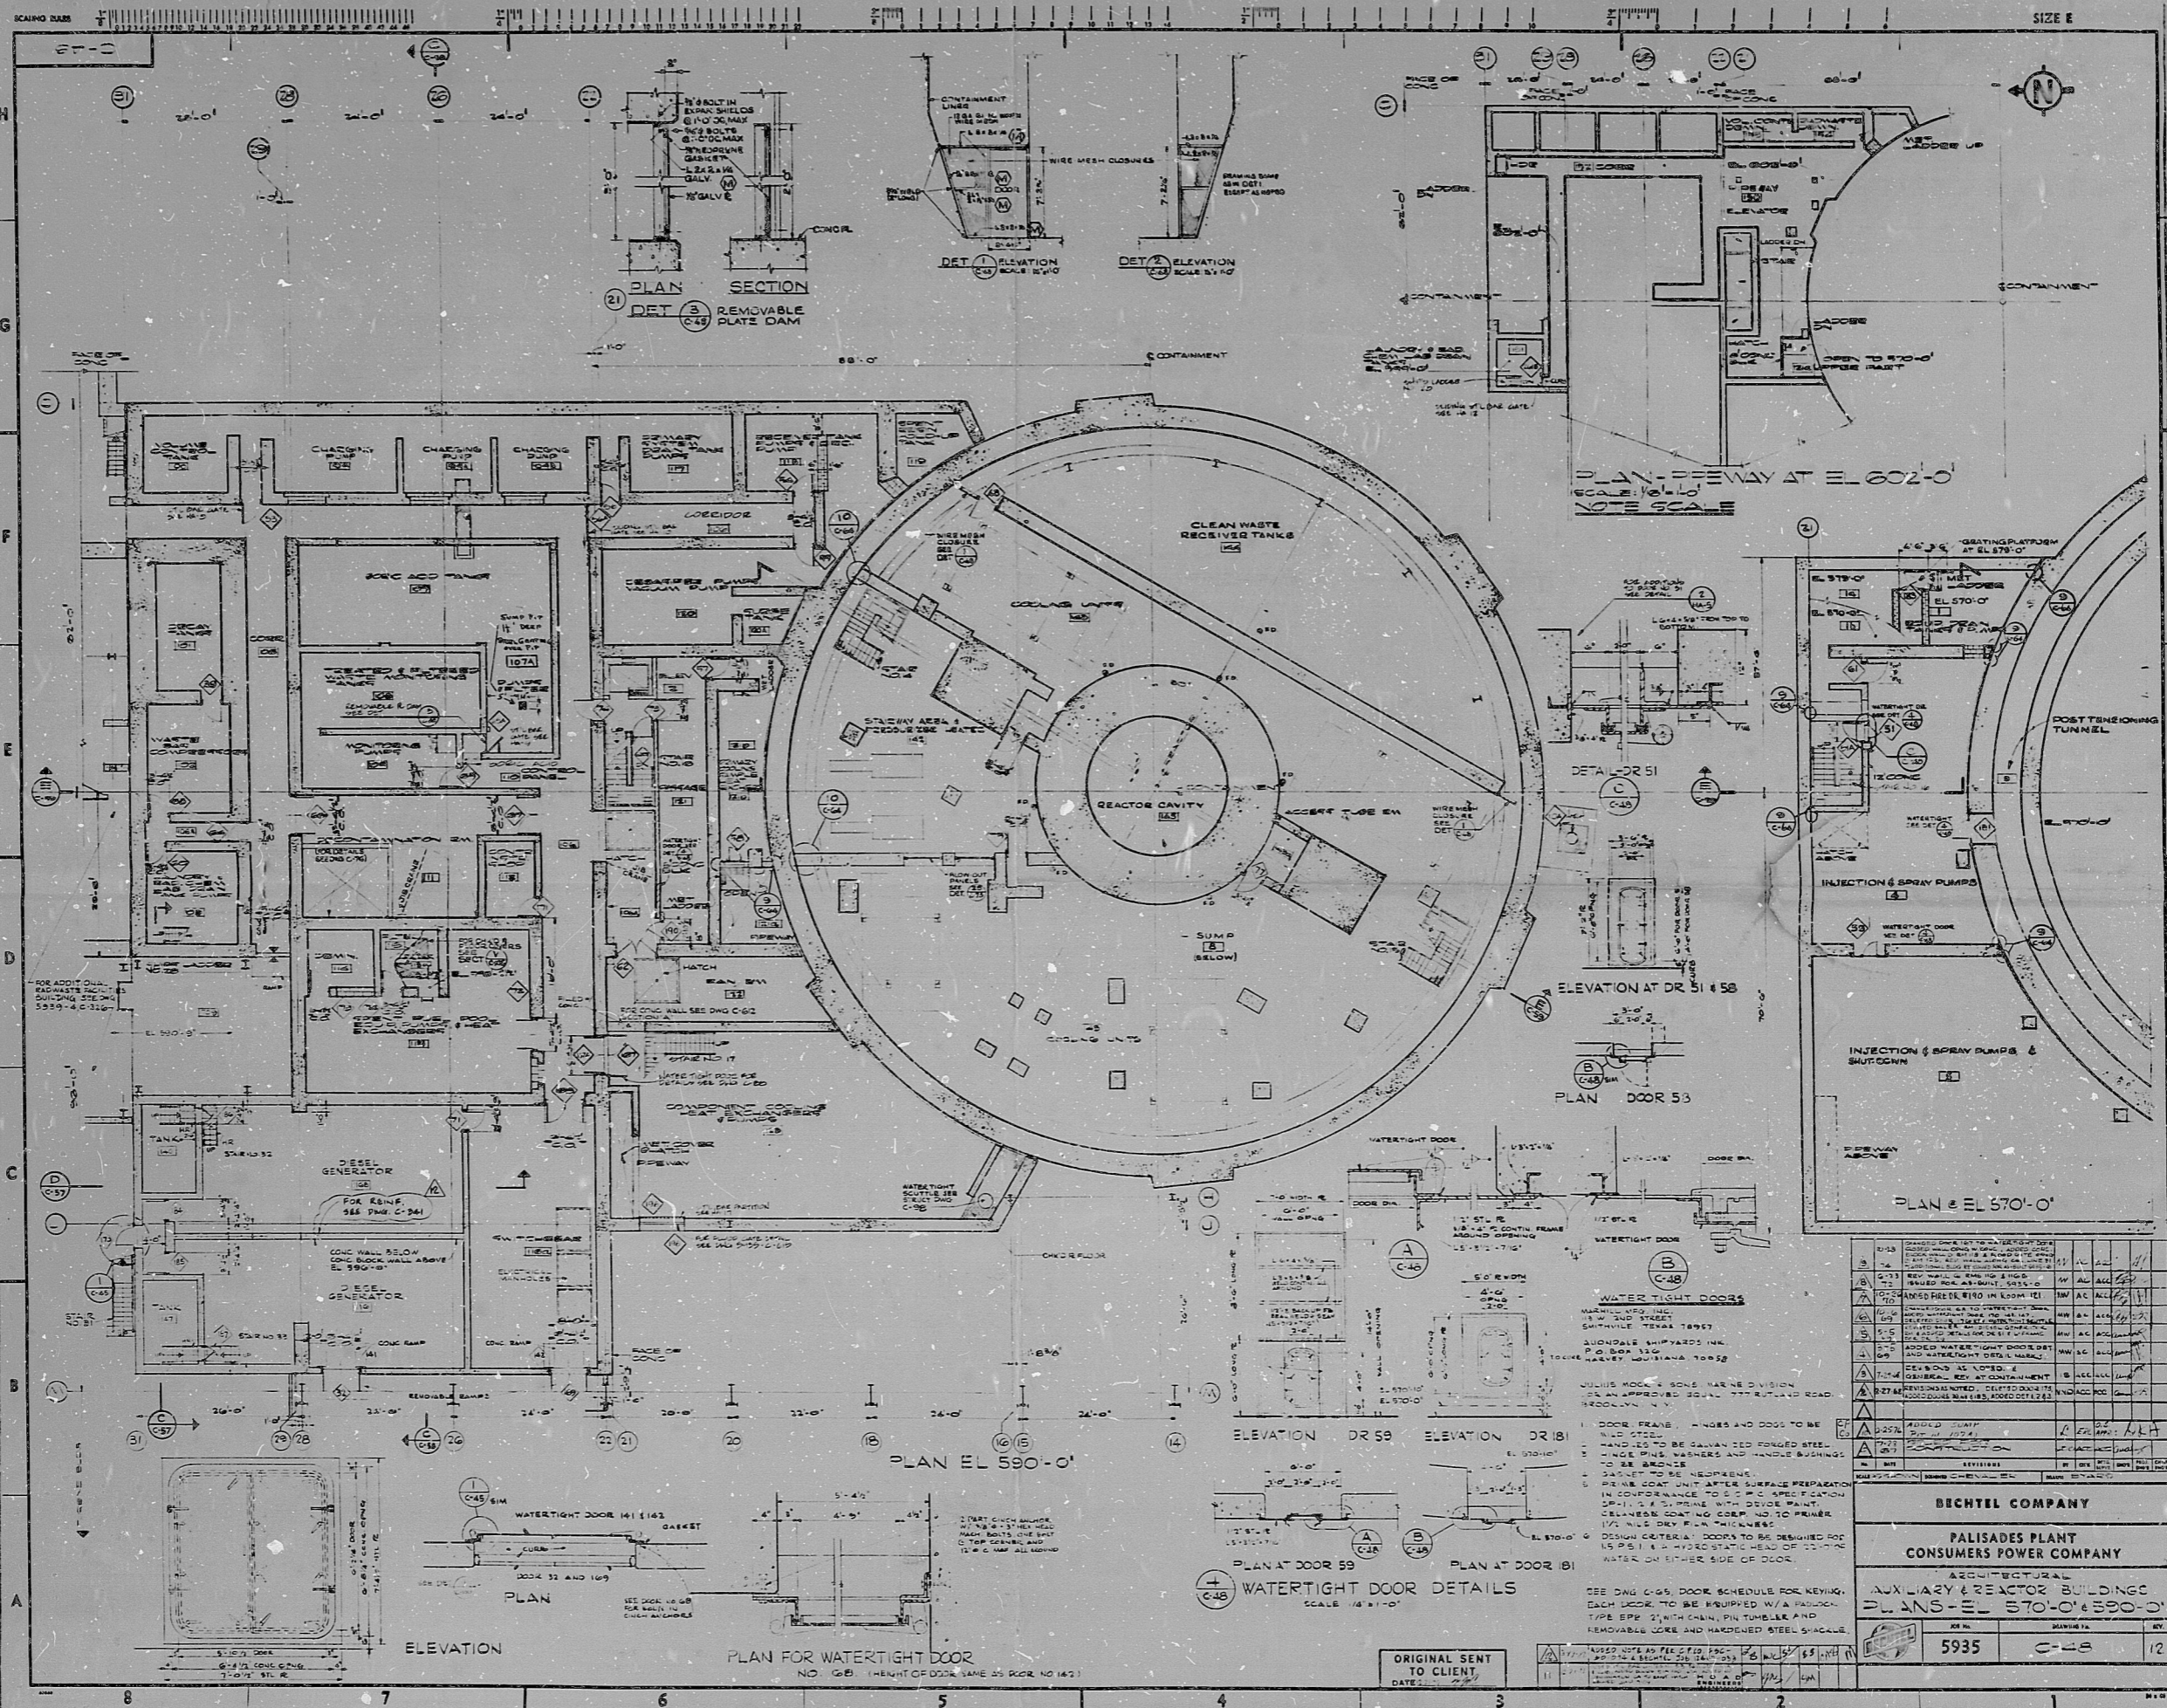

BECHTEL COMPANY
PALISADES PLANT
CONSUMERS POWER COMPANY
 ARCHITECTURAL
AUXILIARY & REACTOR BUILDINGS
PLANS - EL 570'-0" & 590'-0"
 NO. 5935

WATER TIGHT DOORS

ORIGINAL SENT TO CLIENT

TERA APERTURE CARD
 8012080608

RIDS PDR

8012080608

