


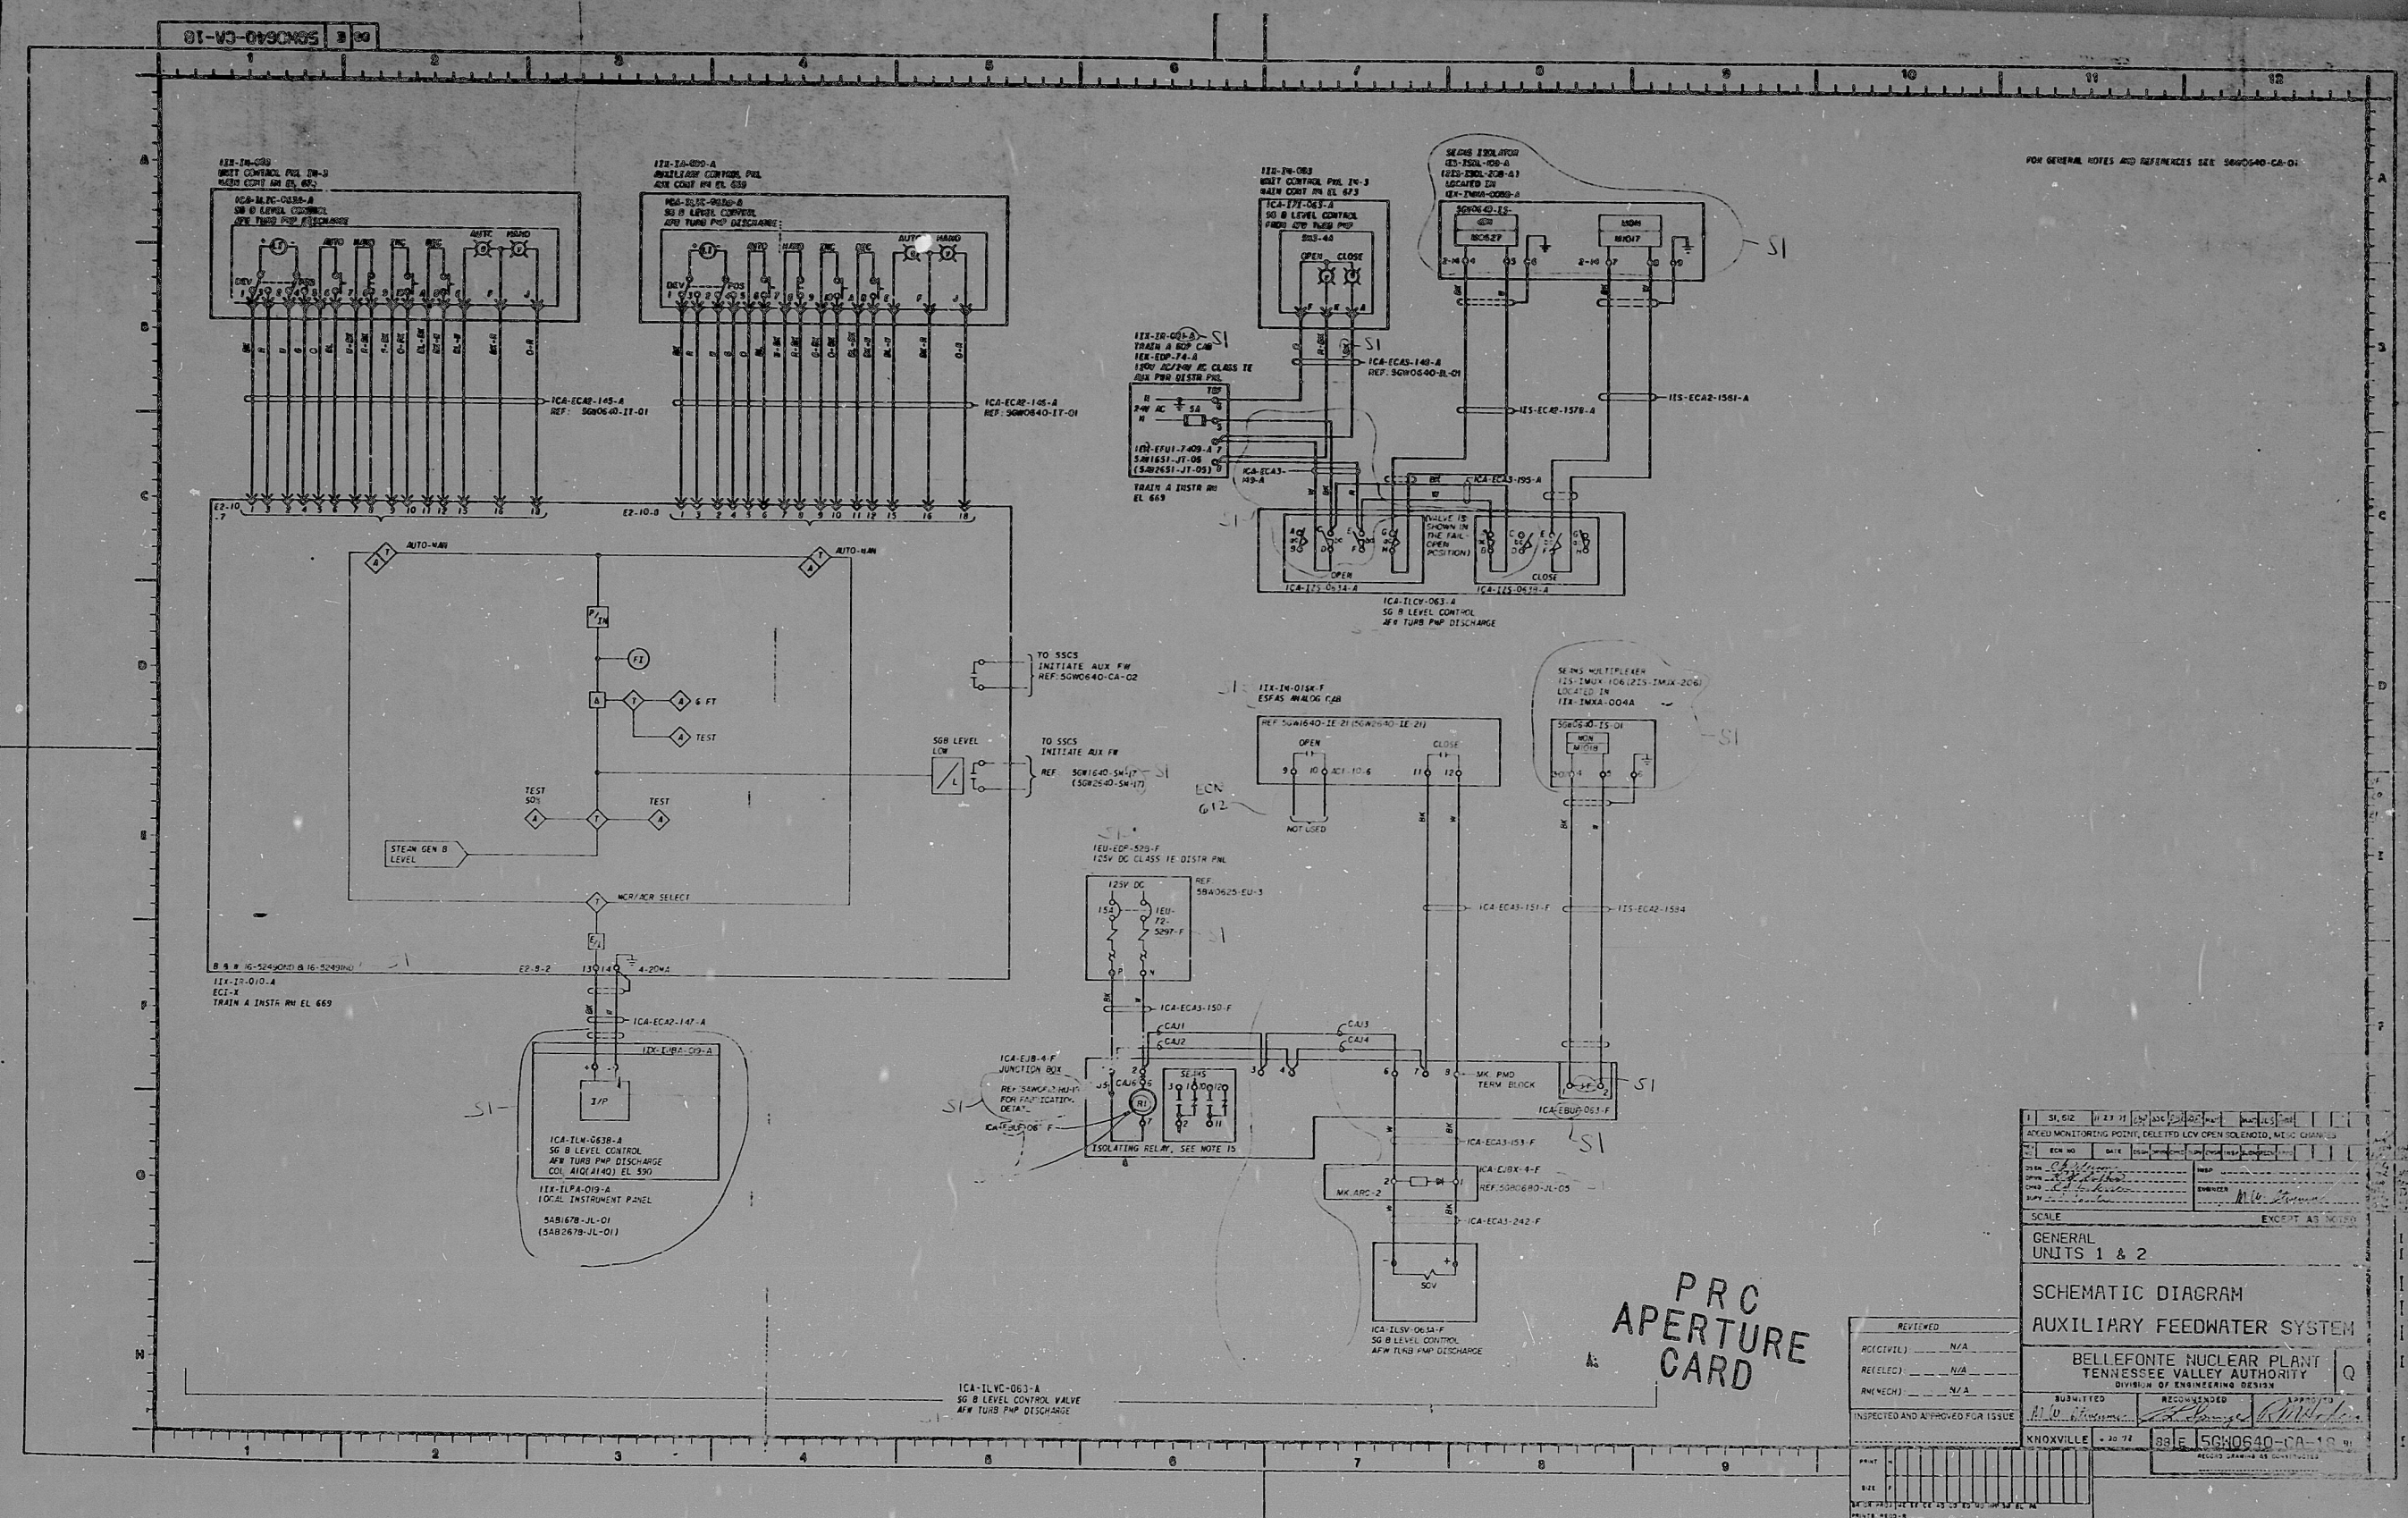



RIDS

8204910121

