
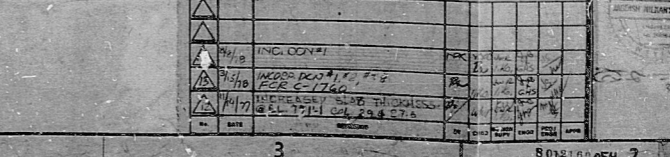


- NOTES:
- FOR NOTES, REFERENCE DRAWINGS AND GENERAL NOTES SEE DRAWINGS C-103, C-801 RESPECTIVELY.
 - REFERENCE DRAWINGS LISTED AND OPENINGS SHOWN HEREON ARE NOT COMPLETE PRIOR TO CONSTRUCTION FIELD SHALL LOCATE OPENINGS, E.C. CUTS AND EMBEDDED PIPING FROM LATEST MECHANICAL DRAWINGS AND EMBEDDED CONDUITS FROM LATEST ELECTRICAL DRAWINGS.
 - CONCRETE SHALL BE 4,000 PSI (F2) U.M.O.
 - FOR FLOOR PLAN @ EL. 749'-1" SEE DWGS. C-139 THRU C-101.
 - FOR FLOOR PLAN @ EL. 762'-10" SEE DWG. C-188.
 - FOR FLOOR PLAN @ EL. 774'-1" SEE DWGS. C-222 THRU C-228.
 - ALL OPENINGS THRU WALL EXCEPT HSEV1 SHALL HAVE KEYS AS PER DET. 20 DWG. C-803.
 - FOR ADDITIONAL PENETRATIONS SEE PLANT DESIGN. X-SERIES DRAWINGS. WHERE CONFLICTS EXIST, X-DRAWINGS SHALL GOVERN.
 - FOR ADD. INSERTS AND EMBEDDED ITEMS SEE DWG. C-144 SH. 2.
 - FOR PIPE SUPPORT INSERT RE. MARKED THUS REFER TO DRAWINGS C-1091, C-1092, C-1093 FOR ADDITIONAL DATA.
 - FIELD MAY BE REINFORCED WITH ANCHOR PLATES SIM TO DET. 6 WITH A MAXIMUM 3% COVER. IF NOT POSSIBLE TO MAINTAIN THIS MAY BE INCREASED TO 4% (C-1076).

REF. DWG. NO.	PL. NO.	REF. DWG. NO.	PL. NO.
C-103	E-10523-4	C-103	E-10523-4
C-140	E-105212 SH1	C-222	E-10524-9
C-801	E-10559 SH1	C-223	E-10525-0
C-739	E-105237	C-224	E-105337
C-200	E-105234	C-225	E-105135
C-201	E-105233	C-121	E-105212-2
C-202	E-105240	C-144 SH2	E-105213 SH7
C-803	E-10559 SH1	C-1091	E-10584-7
C-1092	E-10584-9	C-1076	E-10593-8
C-1097	E-10584-4	C-1097	E-10584-4
C-1083	E-10584-6	C-263	E-10585-6
C-1782	E-105531-3	C-850	E-105245
C-788	E-105531-9	C-1093-1	E-105350-1

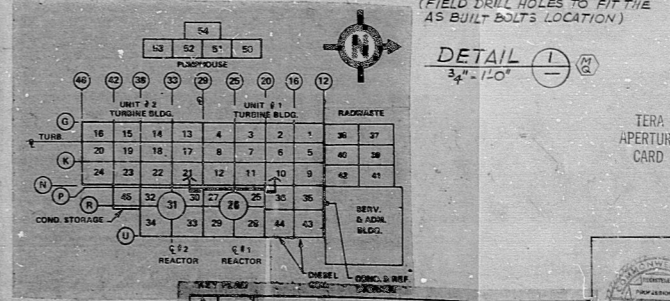

NO.	DESCRIPTION	DATE	BY	CHKD.

PENNSYLVANIA POWER & LIGHT COMPANY
 ALLENTOWN, PENNSYLVANIA
 BUTQUHANNA STEAM ELECTRIC STATION - UNIT 1 UNIT 2
 BECHTEL - SAN FRANCISCO

**REACTOR BUILDING UNIT-1
 EXTERIOR WALL AREAS 25&27
 EL 749'-1 TO EL 826'-6**

JOB No. **8856** DRAWING No. **C-144 SH-1** REV. **14**

E-105213-SH-1

RIDS-PDR

8012160054

