
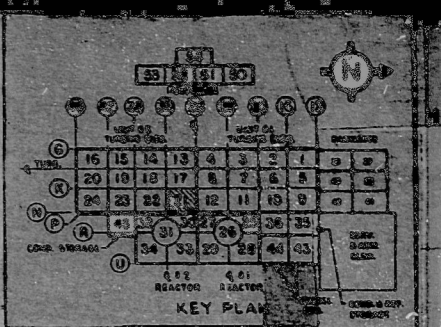


22"  
11"  
11"  
8.5"  
11"  
17"  
22"  
34"

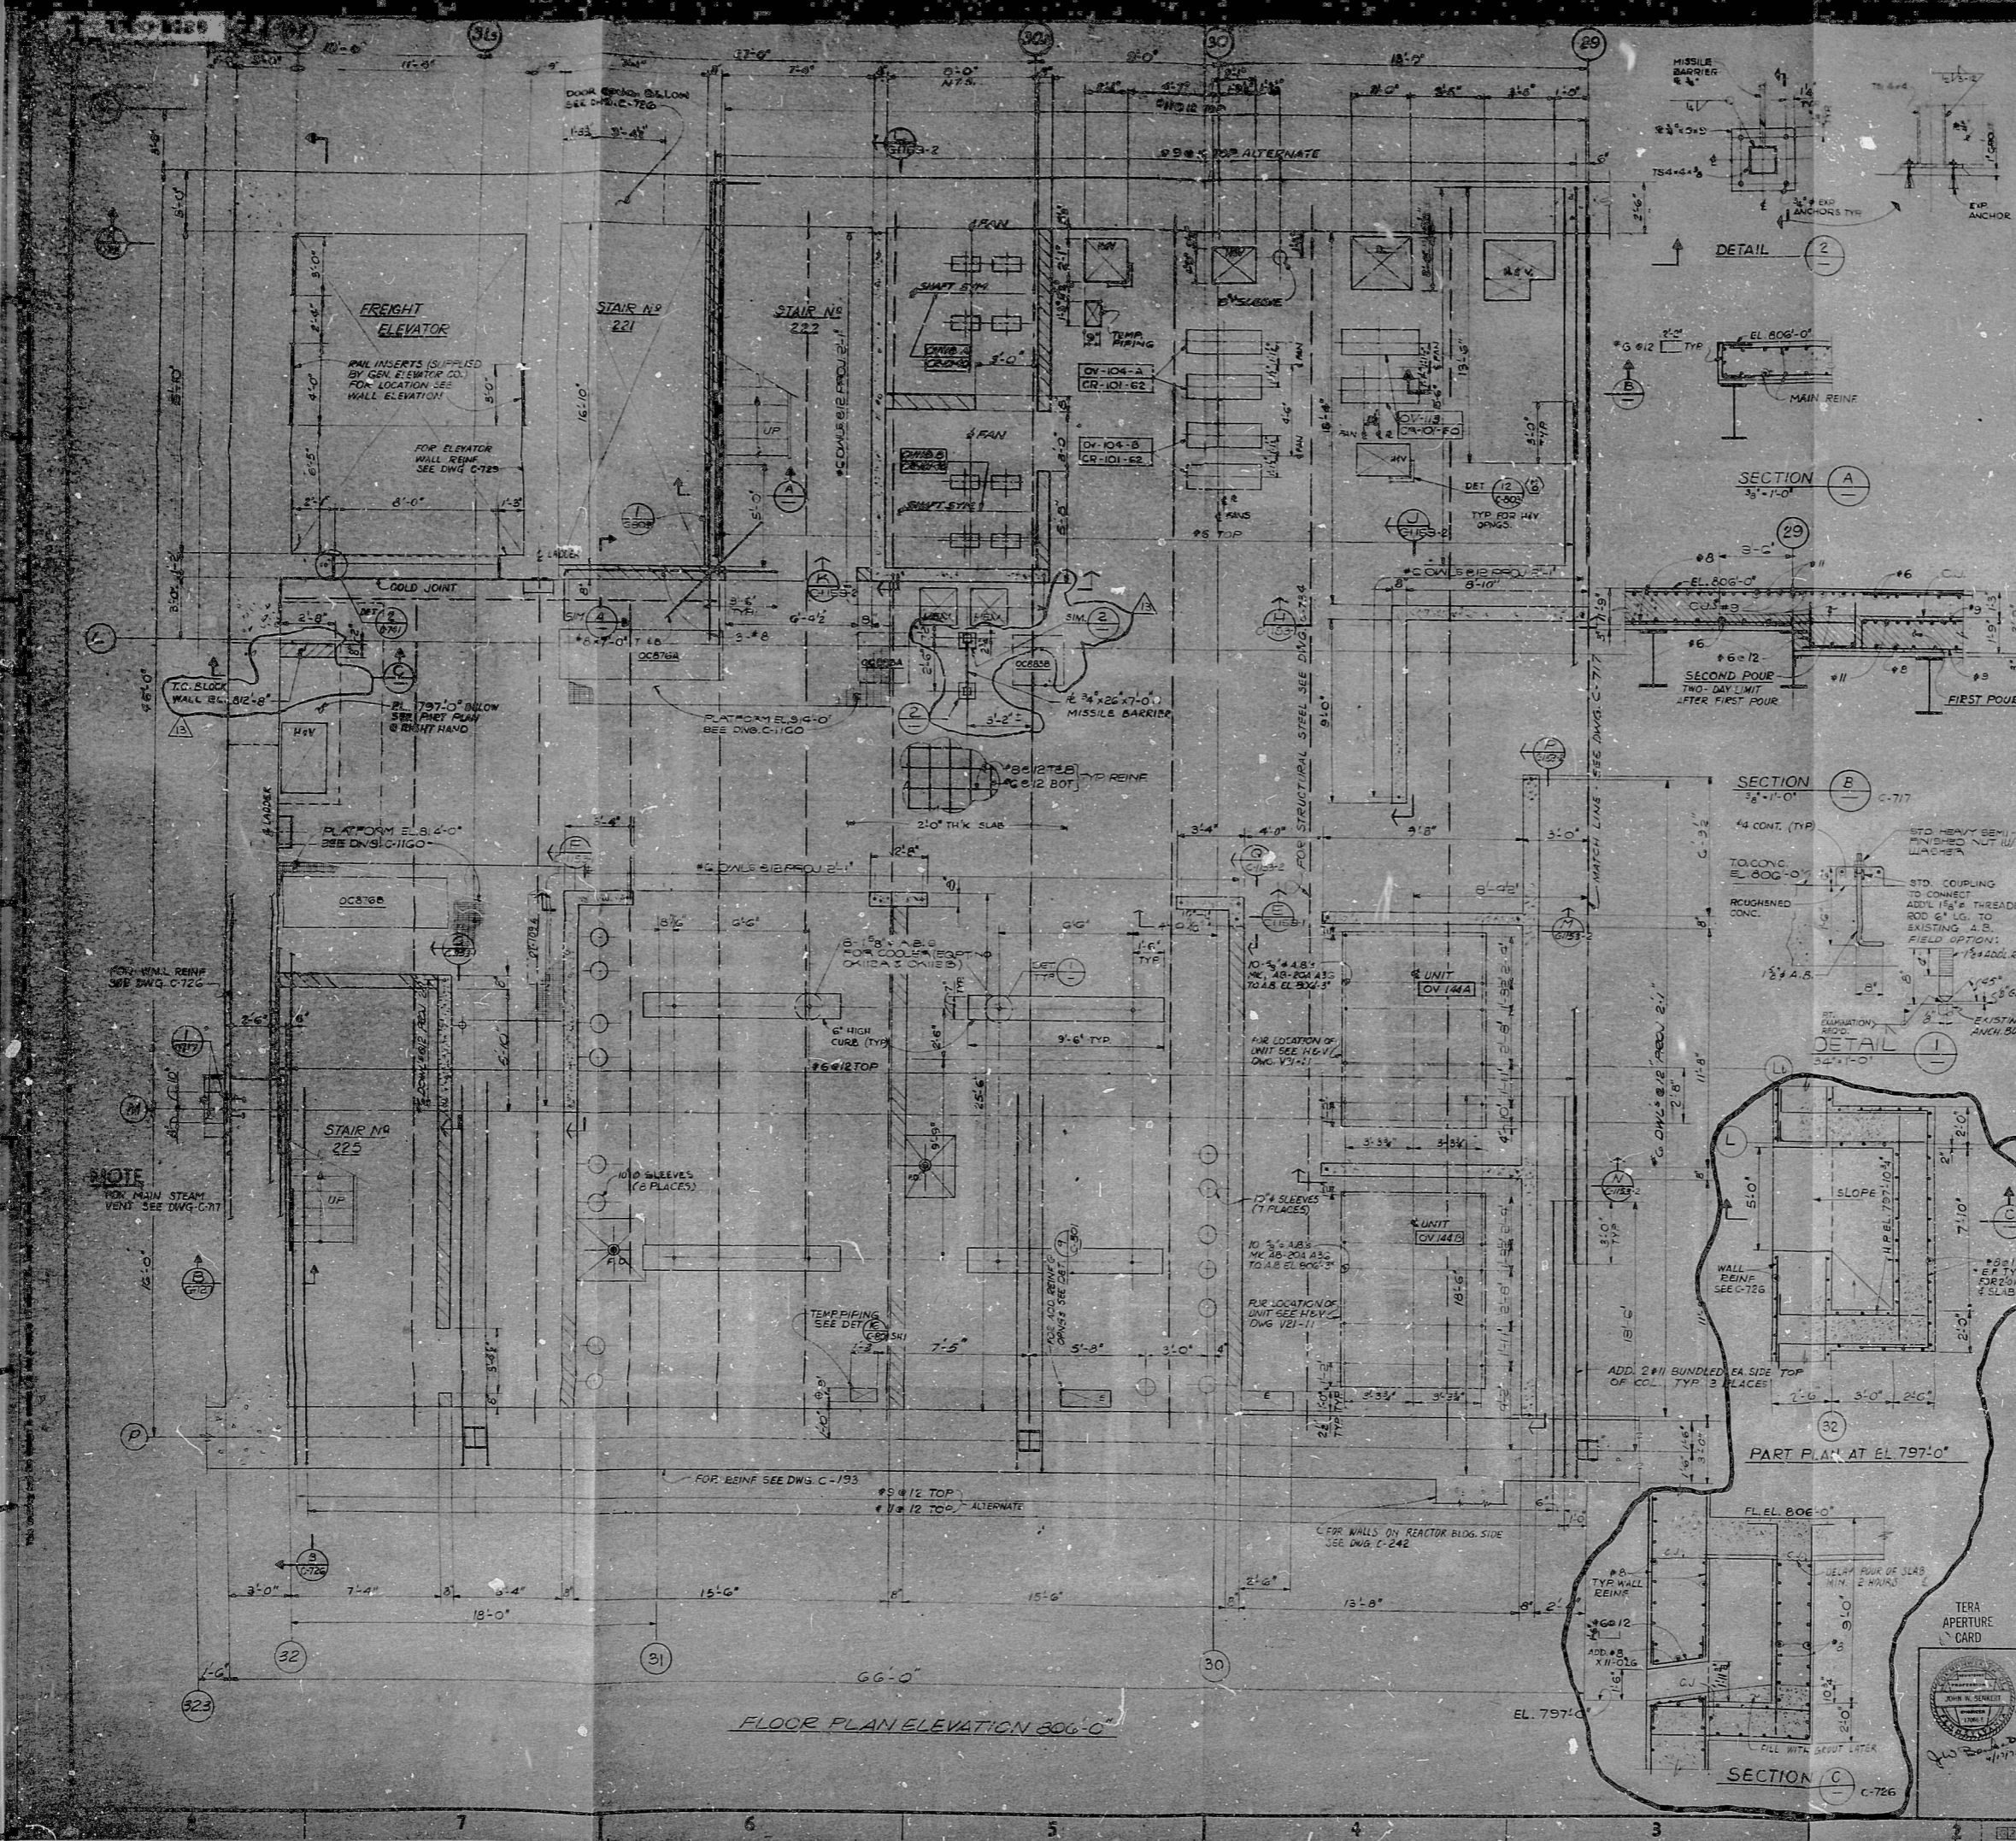

**NOTES:**

1. FOR NOTES & REFERENCE DRAWINGS SEE DRAWING C-717.
2. CONCRETE SHALL BE 4,000 PSI (18) U.N.G.
3. ALLOWABLE FLOOR LIVE LOAD - 250 psf.
4. CONT. STEEL FRAME AS PER DETAIL (12) FOR ELECT. & TEMP. PENNS. THRU THIS FLOOR.
5. FOR ADDITIONAL PENETRATIONS SEE PLANT DESIGN Y-SERIES DRAWINGS. WHERE CONFLICTS EXIST, X-DRAWINGS SHALL GOVERN.
6. FOR CONC. BLOCK WALL ANCHORAGE PLATES SEE DWG. C-805 SH 2 DET. 4.

REFERENCE DWG'S.		REFERENCE DWG'S.	
BECKETL NO.	PL. NO.	BECKETL NO.	PL. NO.
C-220	E-105526 SH 1	C-1153-2	E-105534 SH 4
C-717	E-105526 SH 1	C-242	E-105254
C-725	E-105530 SH 2	C-1160	E-105534
C-741	E-105533		
C-734	E-105531 SH 5		
C-726	E-105528 SH 8		
C-803	E-105533 SH 1		
C-801	E-105533 SH 1		
C-133	E-105533 SH 1		
C-804	E-105533 SH 2		
C-103	E-105533 SH 1		

**BARRIER WALLS FOR THE CONTROL ROOM AIR INTAKE**

NO.	DESCRIPTION	DATE	BY	CHKD.
**PENNSYLVANIA POWER & LIGHT COMPANY**  
 ALLENTOWN, PENNSYLVANIA  
 SUDBURGH STEAM ELECTRIC STATION - UNIT 1, UNIT 2  
 BECKETL - SAN FRANCISCO

**CENTRAL CONTROL BUILDING FLOOR PLAN ELEVATION 806'-0" AREA 21**

JOB NO.	DRAWING NO.	REV.
8856	C-718	13

E-105526 SH 2

RIDS - PDR

8012160352

