


9-E-HM01-01

THIS DRAWING AND THE DESIGN IT COVERS ARE THE PROPERTY OF BECHTEL. THEY ARE LOANED TO YOU BY BECHTEL'S EXPRESS AGREEMENT THAT THEY WILL NOT BE REPRODUCED, COPIED, OR IN ANY MANNER USED EXCEPT IN THE LIMITED WAY AND PRIVATE USE PERMITTED BY ANY WRITTEN CONSENT GIVEN BY THE LENDER TO THE BORROWER.

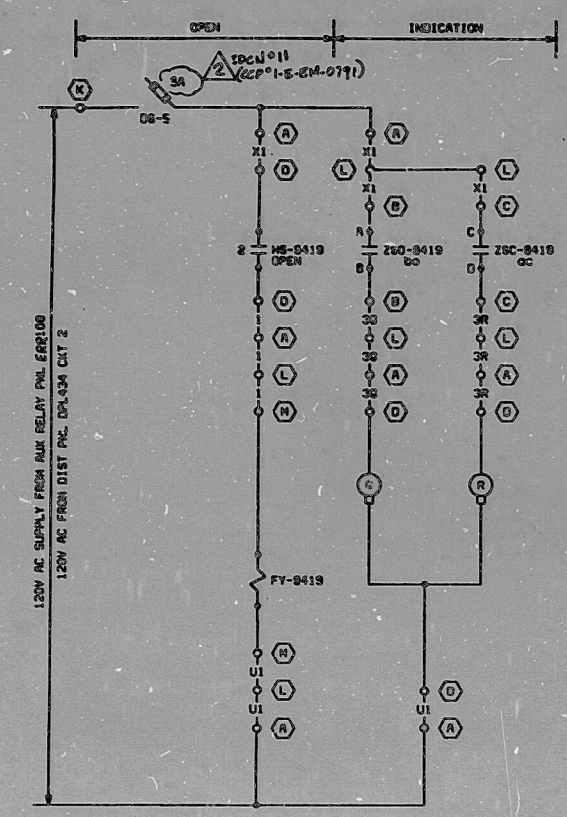

HS-9419

BLOCK	CONTACT	NO	POSITION	
			CLOSE	OPEN
A	1  1C 2  2C	1	X	
		2		X
B	3  3C 4  4C	3	X	
		4		X

MAINTAINED CONTACTS
 X-DENOTES CLOSED CONTACT
 G.E. CAT NO CR2940UB203A

PDR RIDS

8908090403

