
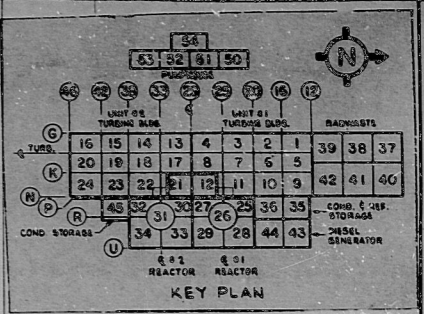
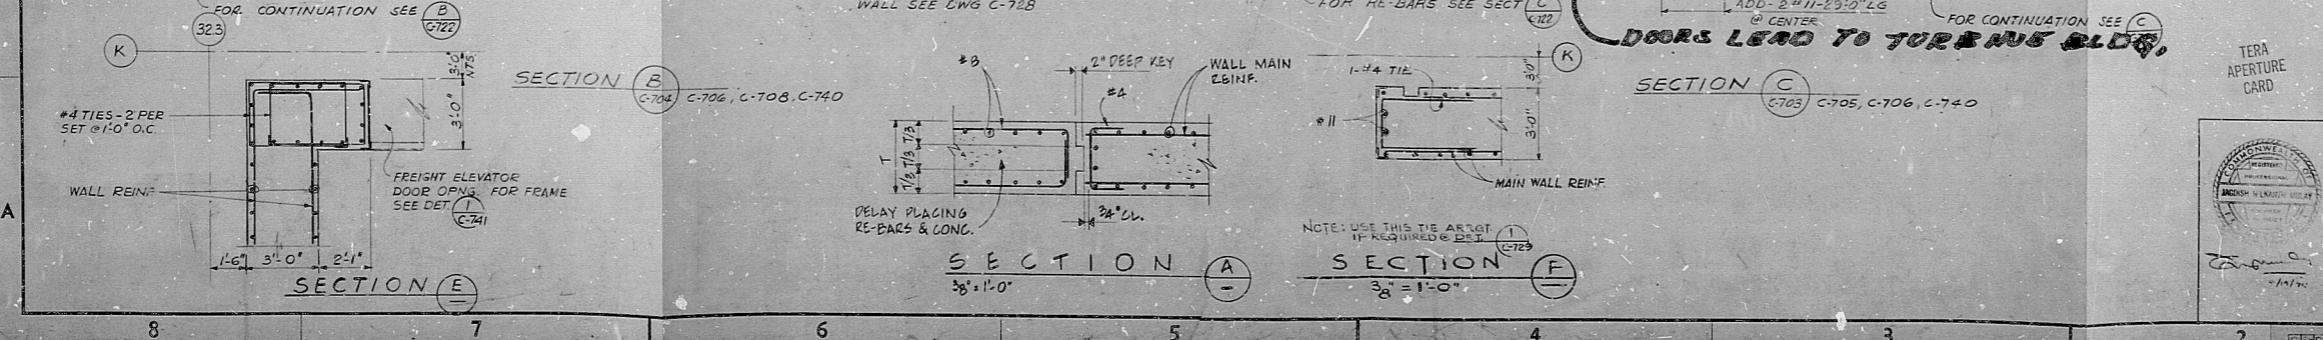


**DOORS LEAD TO TURBINE BLDG.**

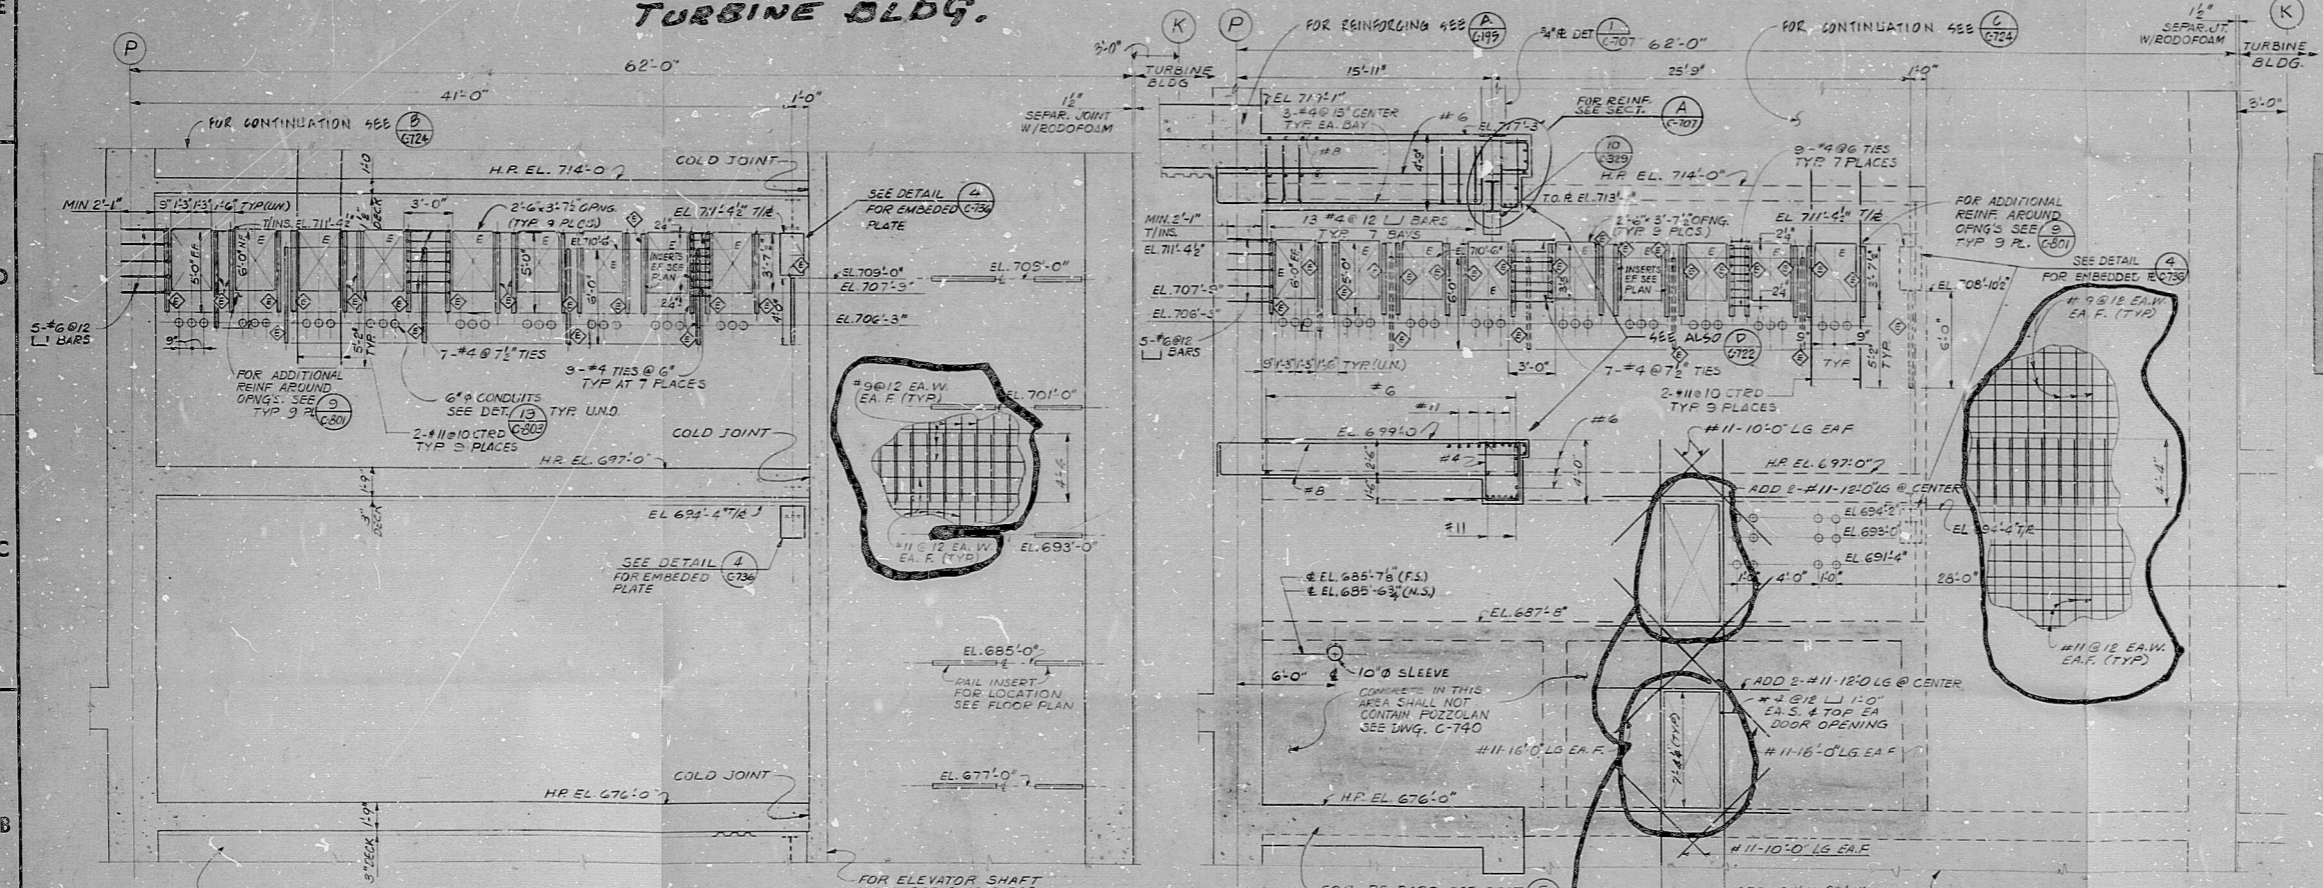

- NOTES:**
- FOR NOTES, REFERENCE DRAWINGS & GENERAL NOTES SEE DRAWINGS C-103, C-104 & C-801 RESPECTIVELY.
  - REFERENCE DRAWINGS LISTED AND OPENINGS SHOWN HEREON ARE NOT COMPLETE. PRIOR TO CONSTRUCTION, FIELD SHALL LOCATE OPENINGS, BLOCKOUTS AND EMBEDDED PIPING FROM LATEST MECHANICAL DRAWINGS AND EMBEDDED CONDUITS FROM LATEST ELECTRICAL DRAWINGS.
  - CONCRETE SHALL BE 4,000 PSI (F) U.N.O.
  - FOR ADDITIONAL PENETRATIONS SEE PLANT DESIGN & SERIES OF DRAWINGS, WHERE CONFLICTS EXIST, DRAWING SHALL GOVERN.
  - ALL OPENINGS THRU WALL EXCEPT HWY SHALL HAVE KEYS AS PER DET. 20, DWG. C-803.

REFERENCE DWG'S.		REFERENCE DWG'S.	
BECHTEL NO.	PL. NO.	BECHTEL NO.	PL. NO.
C-103	E-105199 SH1	C-730	E-105531 SH1
C-104	E-105199 SH2	C-731	E-105531 SH2
C-103	E-105519 SH1	C-801	E-105578 SH1
C-104	E-105519 SH2	C-729	E-105531 SH2
C-705	E-105580 SH1	C-707	E-105521 SH1
C-706	E-105580 SH2		
C-722	E-105529 SH1		
C-728	E-105530 SH1		

NO.	DESCRIPTION	DATE	BY	CHKD.
1	ADDED BARRIERS IN CABLE CHASE AREA			
2	INCORP. DCN #1, HOLD @ REVISED			
3	INCORP. DCN #1, ADD EOODFRAM PENETRATIONS, INCORP. DCN #1			
4	INCORP. DCN #2, HOLD DCN #1			
5	INCORP. DCN #1, 2, 3, ADDED REIN @ SEC. C, NOTES			
6	INCORP. DCN #1, 2, 3, 100			

**PENNSYLVANIA POWER & LIGHT COMPANY**  
 SUSQUEHANNA STEAM ELECTRIC STATION - UNIT 1, UNIT 2

BECHTEL - SAN FRANCISCO

**CENTRAL CONTROL BUILDING UNITS 1&2 WALL ELEVATIONS EL. 676'-0" TO EL. 714'-0"**

JOB No. 8856 DRAWING No. C-723 REV. 10

E-105529-SH2



RIDS — PDR

8012180571

