
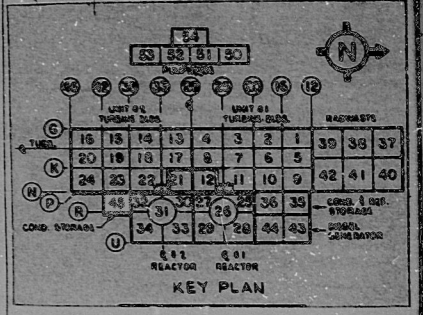
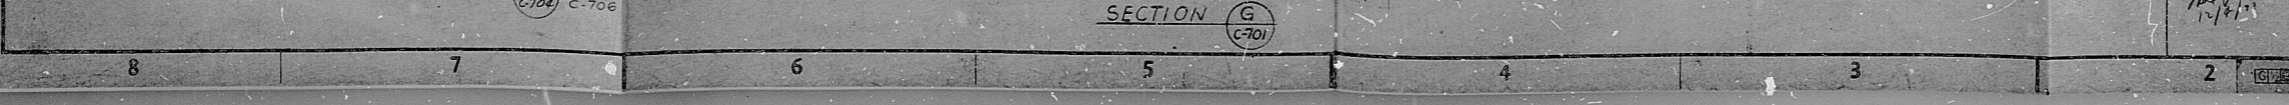
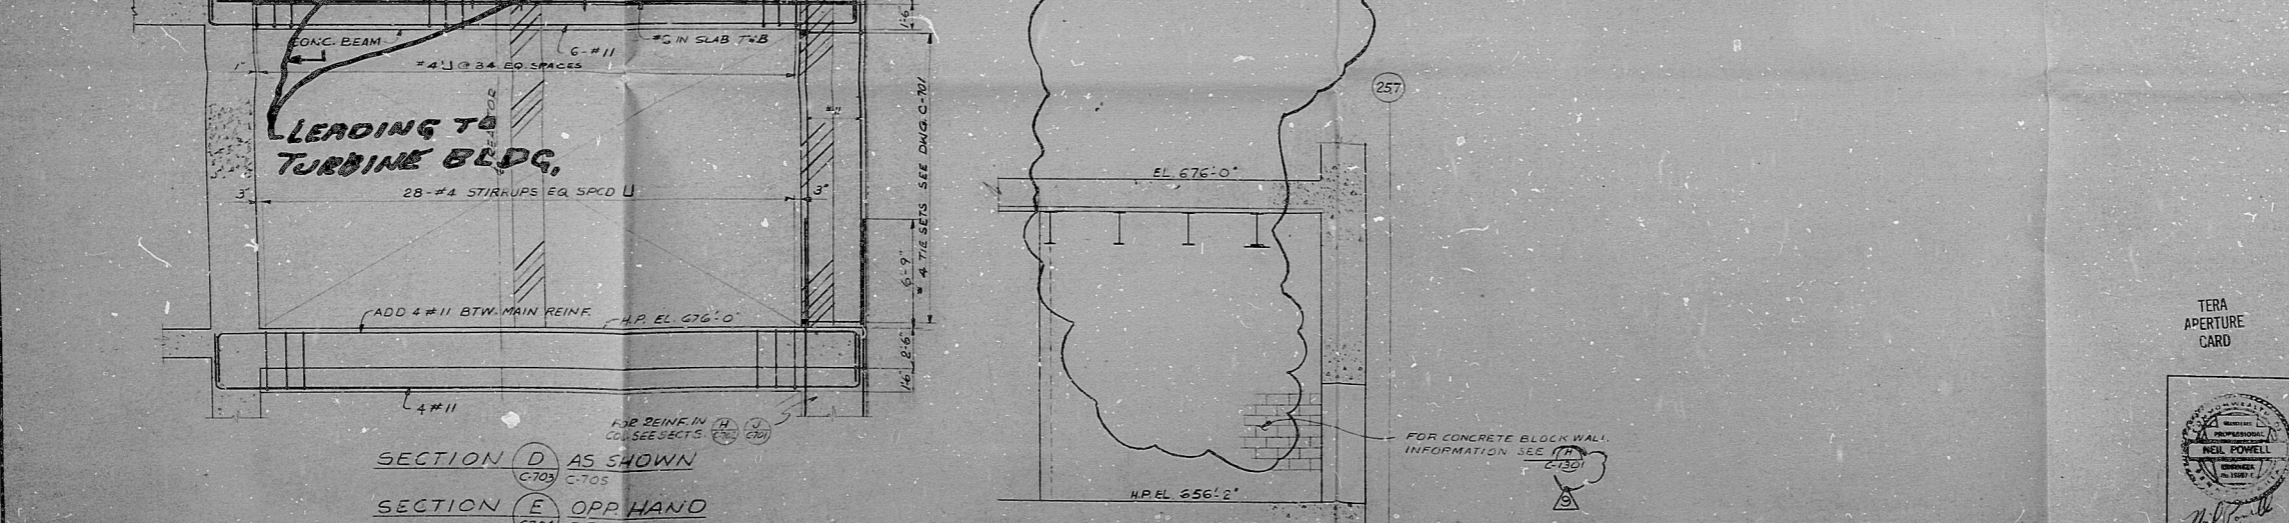
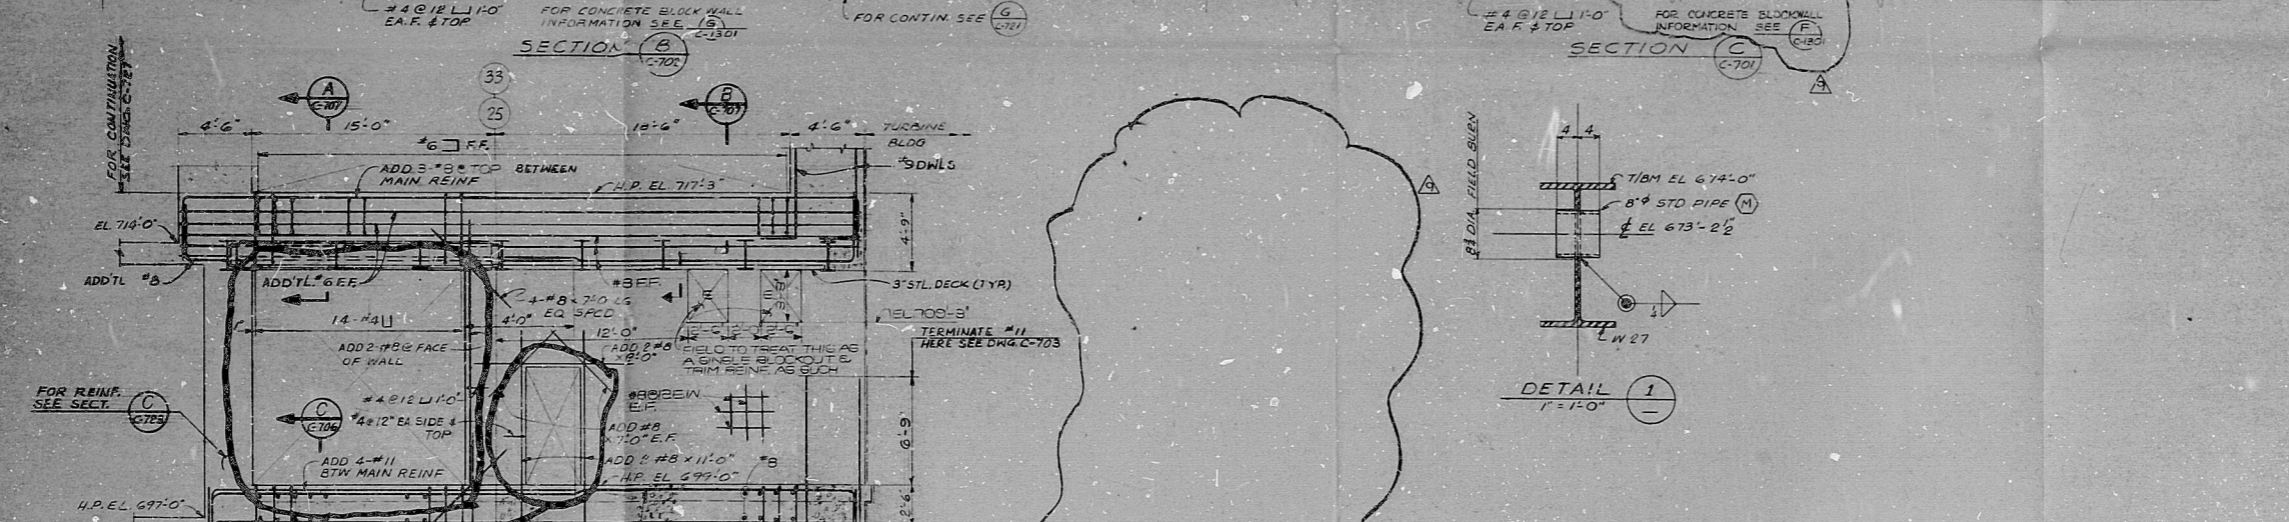
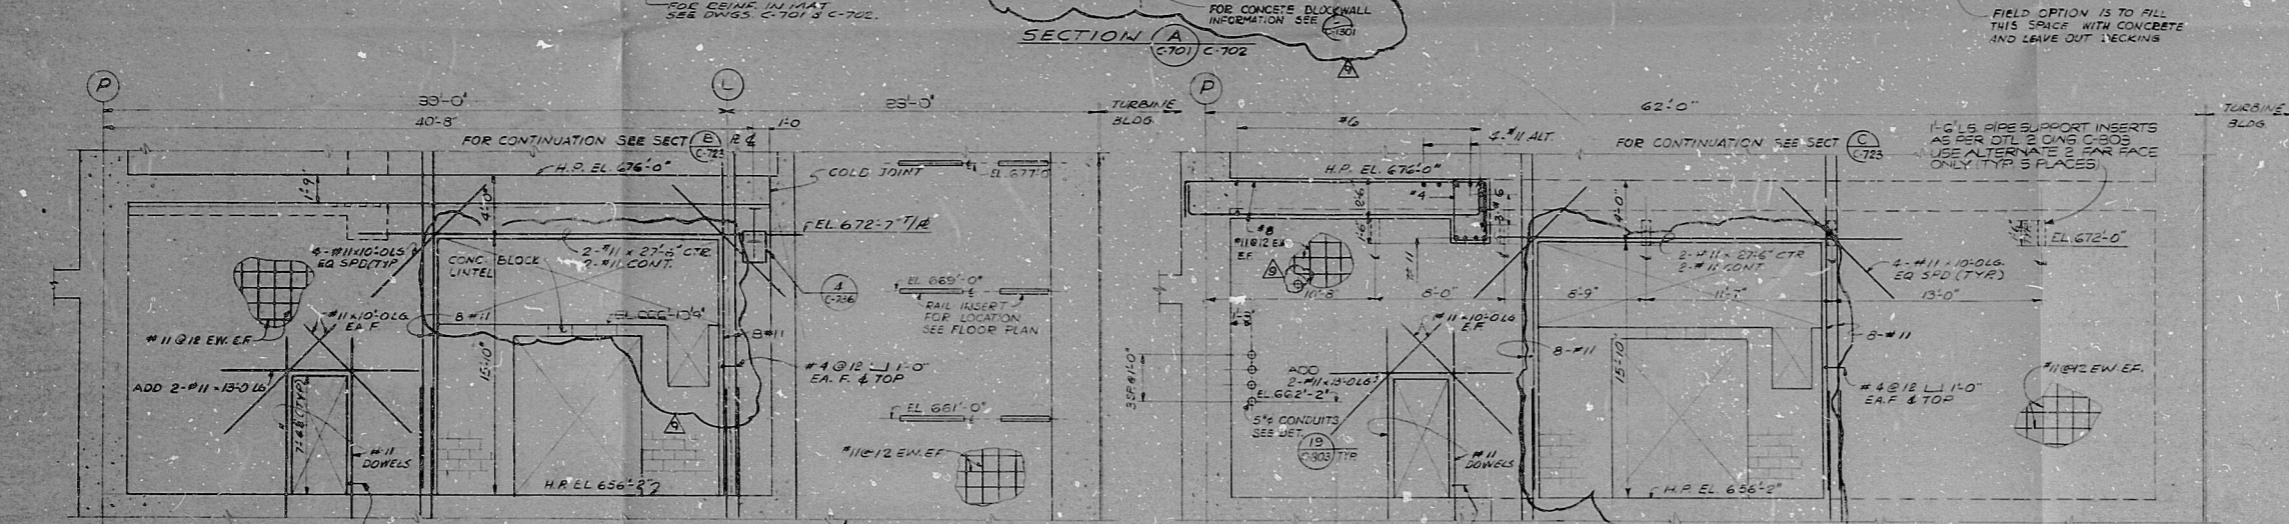


8956-C-722

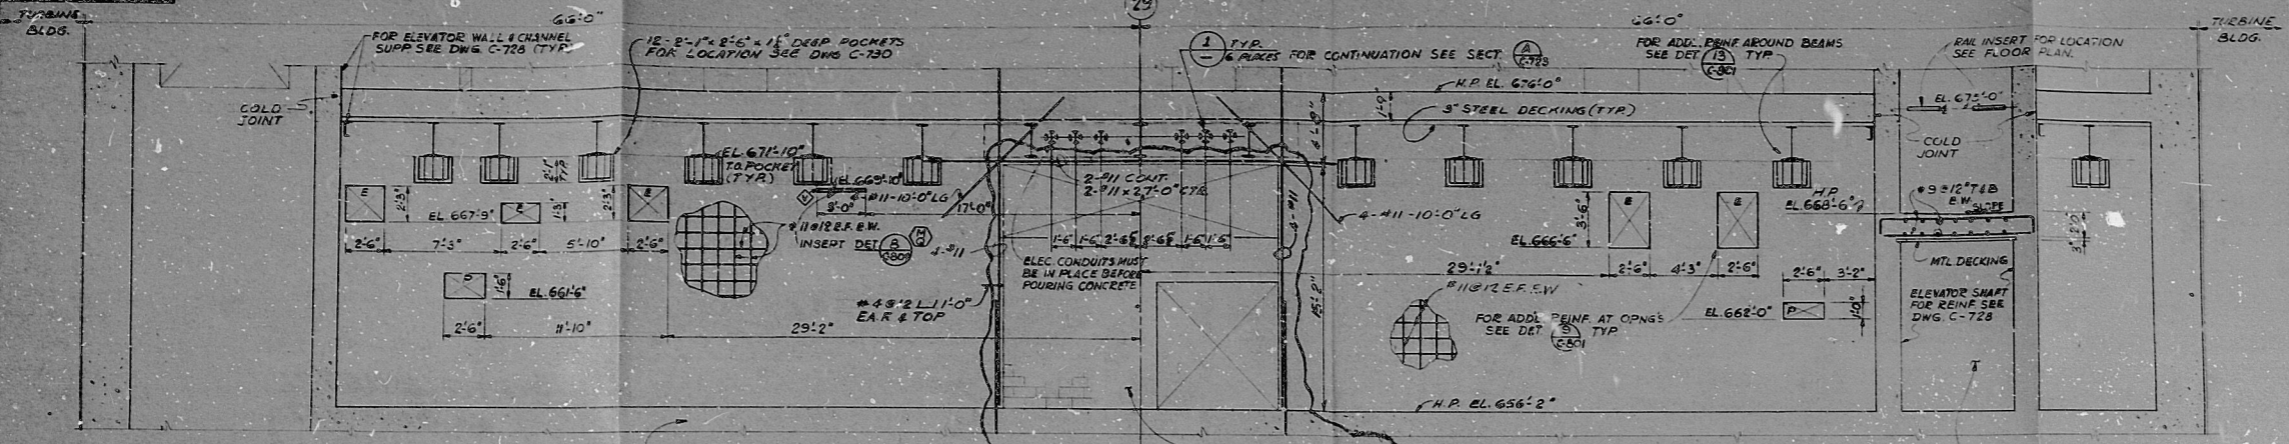

NOTES  
 1 FOR NOTES, REFERENCE DRAWINGS AND GENERAL NOTES SEE DRAWINGS C103, C-104 & C801 RESPECTIVELY.  
 2 REFERENCE DRAWINGS LISTED AND OPENINGS SHOWN HEREON ARE NOT COMPLETE PRIOR TO CONSTRUCTION. FIELD SHALL LOCATE OPENINGS, BLOCKOUTS AND EMBEDDED PIPING FROM LATEST MECHANICAL DRAWINGS AND EMBEDDED CONDUITS FROM LATEST ELECTRICAL DRAWINGS.  
 3 CONCRETE SHALL BE 4000 PSI (FC) UNO.

REFERENCE DWG'S.		REFERENCE DWG'S.	
BECHTEL NO.	PL. NO.	BECHTEL NO.	PL. NO.
C-103	E-105194-SH	C-801	E-105598-SH
C-102	E-105197-SH	C-728	E-105293-SH
C-701	E-105518-SH	C-730	E-105531-SH
C-702	E-105518-SH	C-723	E-105213-SH
C-703	E-105517-SH	C-727	E-105203-SH
C-704	E-105517-SH	C-706	E-105203-SH
C-721	E-105528	C-707	E-105213-SH
C-726	E-105528	C-803	E-105604-SH
C-805-1	E-105600-1	C-1501	E-105930-1
C-805-2	E-105600-2		
C-805-3	E-105600-3		

NO.	DATE	REVISIONS	BY	CHECKED
TERA APERTURE CARD

PENNSYLVANIA POWER & LIGHT COMPANY  
 ALLENTOWN, PENNSYLVANIA  
 SUSQUEHANNA STEAM ELECTRIC STATION - UNIT 1, UNIT 2

BECHTEL - SAN FRANCISCO

CENTRAL CONTROL BUILDING UNITS 1&2  
 WALL ELEVATIONS  
 EL. 656'-0" TO EL. 717'-3"

JOB NO.	DRAWING NO.	REV.
8856	C-722	9

E-105529-SH  
 8012-00577

RDX — PDR

8012180578

