


8856-C-720 SH-2

SIZE E

This drawing and the design it covers are the property of BECHTEL. They are hereby loaned to you for the purpose of preparing reports, proposals, contracts, and other documents. They are not to be reproduced, copied, or used in any way other than that authorized by BECHTEL. 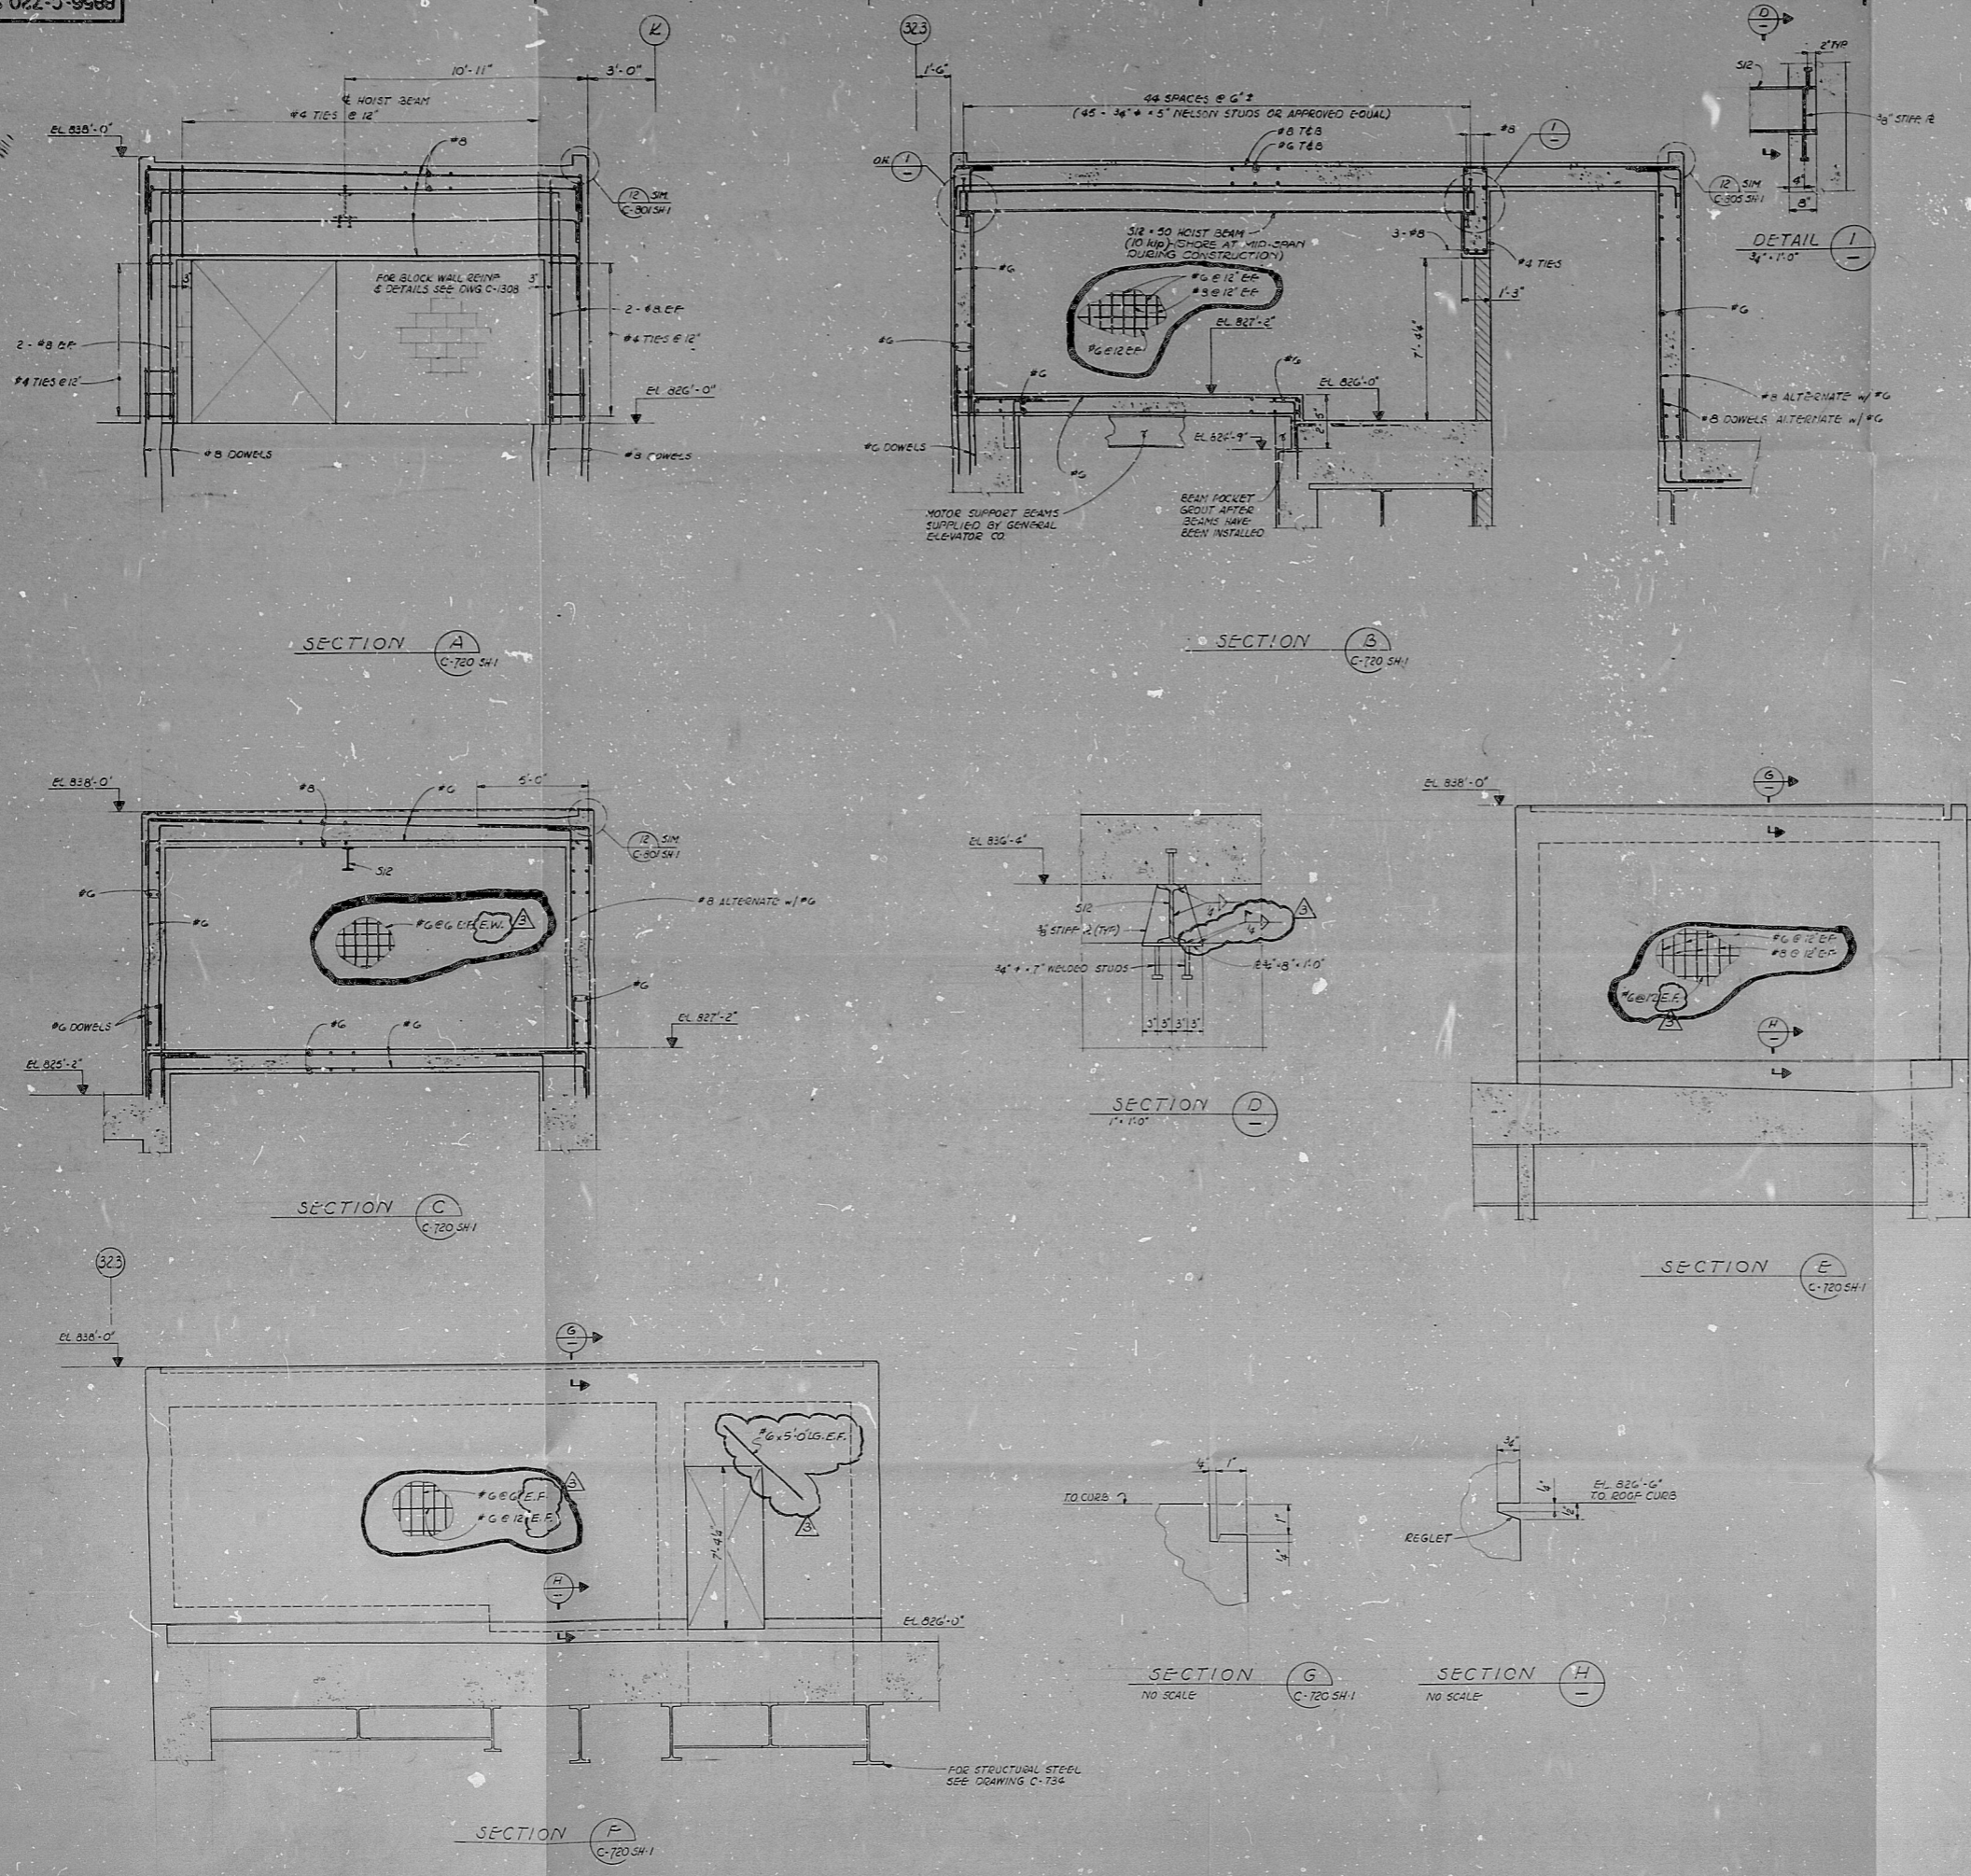

- NOTES**
1. FOR GENERAL NOTES AND REFERENCE DRAWINGS SEE DRAWING C-720 SH-1.
 2. PENETRATION LOCATION, TYPE AND SIZE SHALL BE VERIFIED FROM PLANT DESIGN & SERIES DRAWINGS. WHERE CONFLICTS EXIST, DRAWINGS SHALL CONTROL.
 3. FIELD OPTION: RAISE TOP OF ELEVATOR MACHINE ROOM ROOF SLAB 4" FROM ELEVATIONS SHOWN TO ACCOMMODATE USE OF METAL DECKING IN LIEU OF CONVENTIONAL FORMING.

REFERENCE DWG'S.

BECHTEL NO.	PL. NO.
C-720 SH-1	E-105527-2
C-734	E-105531-3
C-1808	E-105524-8


NO.	DATE	REVISIONS	BY	CHKD.	APP'D.
1		REV. BEING INCORP FOR C-2255			
2		INCORP DENT'S FOR C-1950			
3		REV. SECT'S 'A', 'B', 'C', 'E', 'F', 'G'			
4		ISSUED FOR CONSTRUCTION			

PENNSYLVANIA POWER & LIGHT COMPANY
 ALLENTOWN, PENNSYLVANIA
 SUDBURY/LANNA STEAM ELECTRIC STATION - UNIT 2

BECHTEL - SAN FRANCISCO
CENTRAL CONTROL BUILDING
 SECTIONS AND DETAILS

JOB NO. **8856** DRAWING NO. **C-720 SH-2** REV. **3**

Q E-105527-3

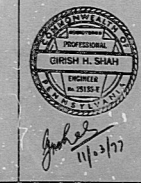

DATE: 11/1/72

SCALE: 3/4" = 1'-0" (AS SHOWN)

34"

REDS — PDR

8012180583

