


**SOUTH WALL ELEVATION**


**NORTH WALL ELEVATION**

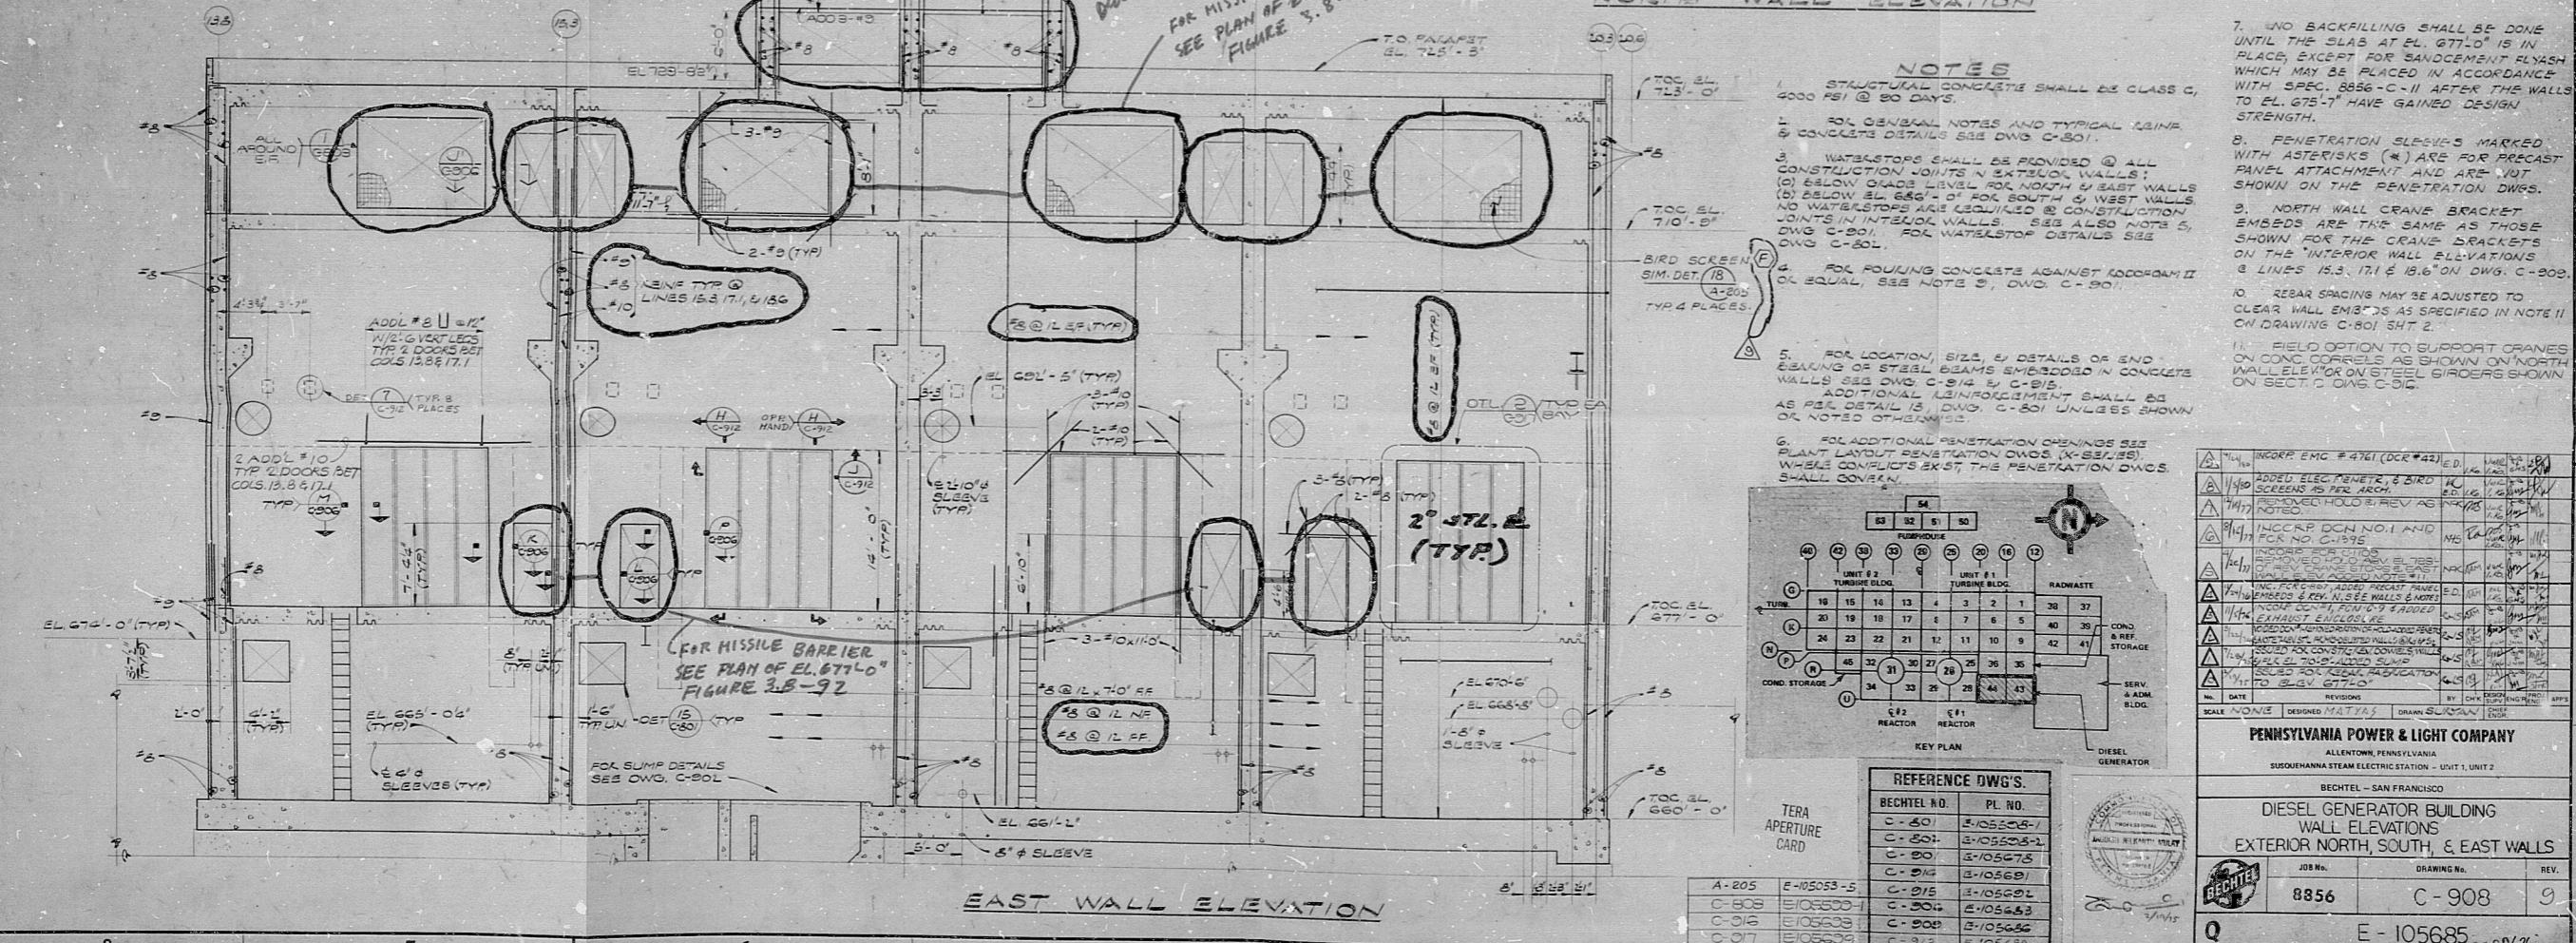

**EAST WALL ELEVATION**

**NOTES**


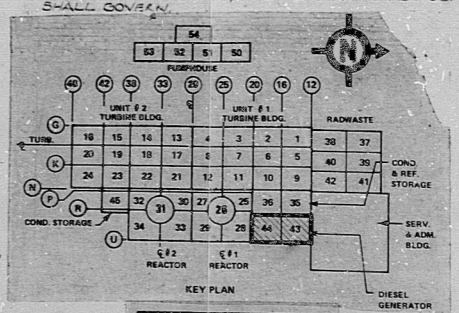

**KEY PLAN**


**REFERENCE DWG'S**


**TERA APERTURE CARD**

DATE	REVISIONS	BY	CHKD.	APP'D.

**SCALE**

PENNSYLVANIA POWER & LIGHT COMPANY  
ALLENTOWN, PENNSYLVANIA  
SUSQUEHANNA STEAM ELECTRIC STATION - UNIT 1, UNIT 2  
BECHTEL - SAN FRANCISCO

DIESEL GENERATOR BUILDING  
WALL ELEVATIONS  
EXTERIOR NORTH, SOUTH, & EAST WALLS

JOB NO. 8856 DRAWING NO. C-908 REV. 9  
E-105685

PDS — PDR

8012180 626

