



06-L-0-9588

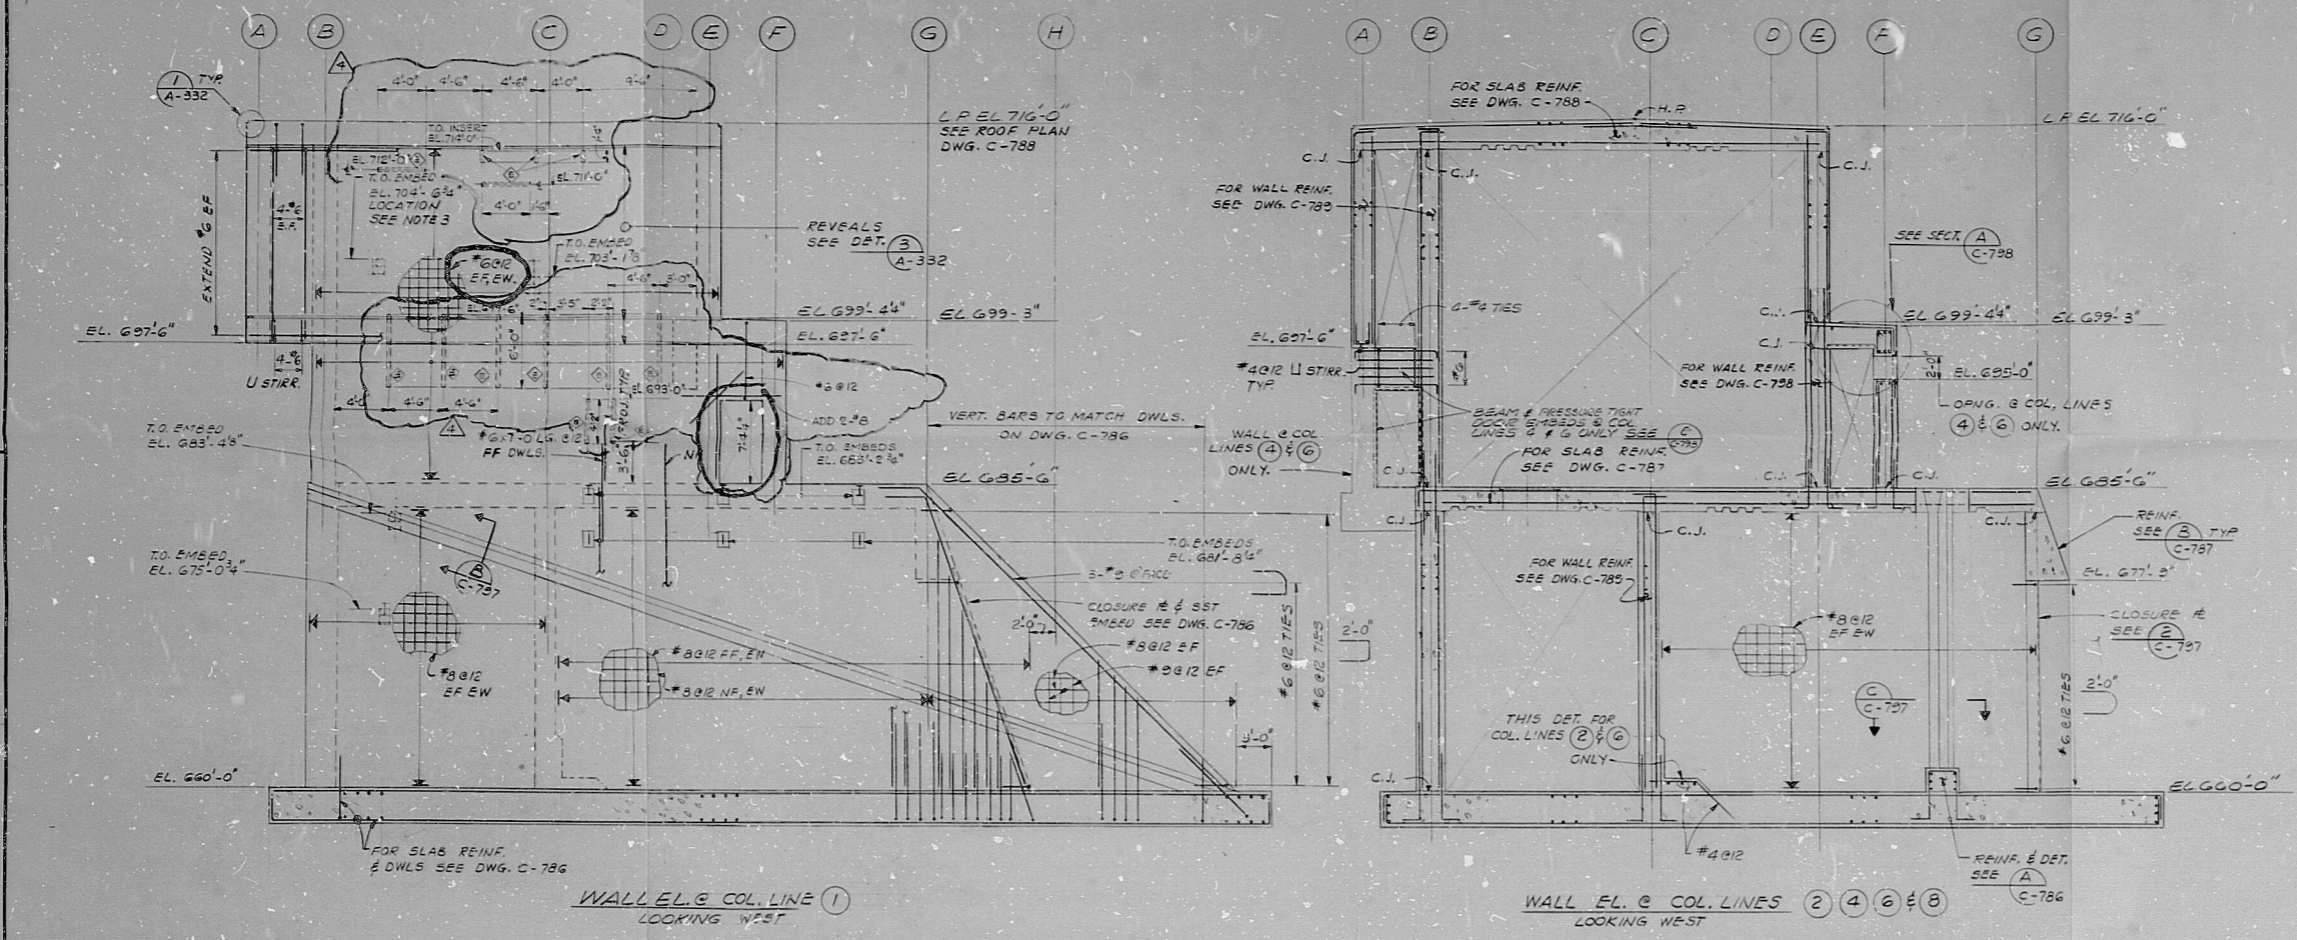

- NOTES:
- FOR NOTES & REFERENCE DRAWINGS SEE DWG. C-791.
  - FOR REINFORCING DETAILS & NOTES SEE DRAWINGS C-801 SH.1 & 2.
  - FOR LOCATIONS & TYPE OF EMBEDS SEE DRAWINGS C-792 & C-793.
  - ALL EMBEDS TO BE STRUCTURAL STEEL AS6 UNLESS NOTED OTHERWISE. ALL STAINLESS STEEL (SST) EMBEDS TO BE TYPE 316 L. ALL STRUCTURAL STEEL & STAINLESS STEEL EMBEDS TO BE IN ACCORDANCE WITH SPECIFICATION 8856-C-16 AND TO BE CLASS I (Q LISTED). STAINLESS STEEL EMBEDS MUST NOT BE IN CONTACT WITH THE REBARS.

REFERENCE DWG'S.

BECHTEL NO.	PL. NO.
C-786	E-105582
C-787	E-105584
C-788	E-105585
C-789	E-105586
C-791	E-105588
C-797	E-105594
C-798	E-105595
C-801 SH.1	E-105598-1
C-801 SH.2	E-105598-3
A-332	E-105685-2
C-792	E-105589
C-793	E-105590

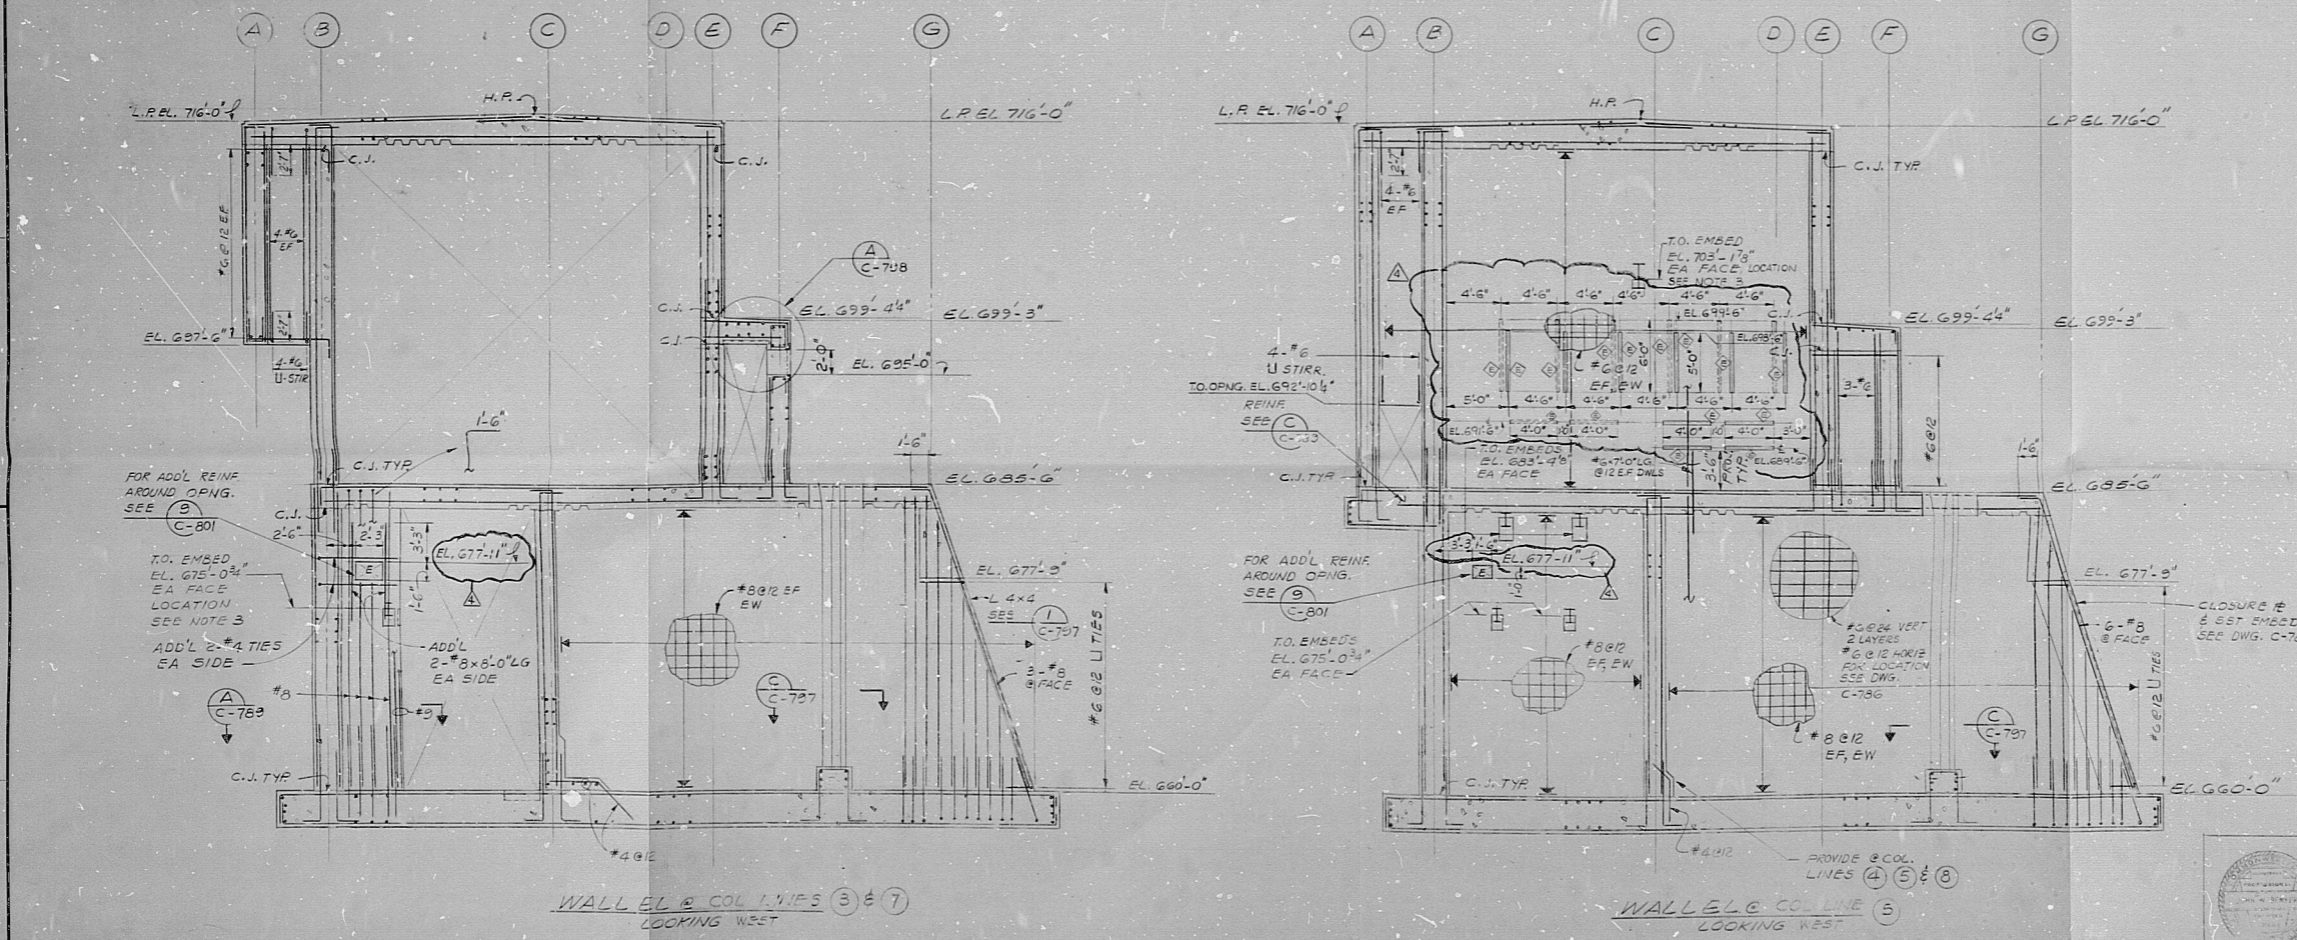

REVISIONS

NO.	DATE	REVISIONS	BY	CHKD.
1		ISSUED FOR CLIENT APPROVAL & REBAR FABRICATION		

PENNSYLVANIA POWER & LIGHT COMPANY  
ALLENTOWN, PENNSYLVANIA  
SUSQUEHANNA STEAM ELECTRIC STATION - UNIT 1, UNIT 2

BECHTEL - SAN FRANCISCO

ESSW PUMPHOUSE  
WALL ELEVATIONS

JOB NO.	DRAWING NO.	REV.
8856	C-790	4

E-105587  
5012 180676

This drawing and the design it covers are the property of BECHTEL. They are hereby loaned to you on the borrower's express agreement that they will not be reproduced, copied, imitated, published, nor used except in the limited way and under the conditions set forth herein.

8 7 6 5 4 3 2

H G F E D C B A



25DS — PDR

8012180646

