




RIDS

8204020080

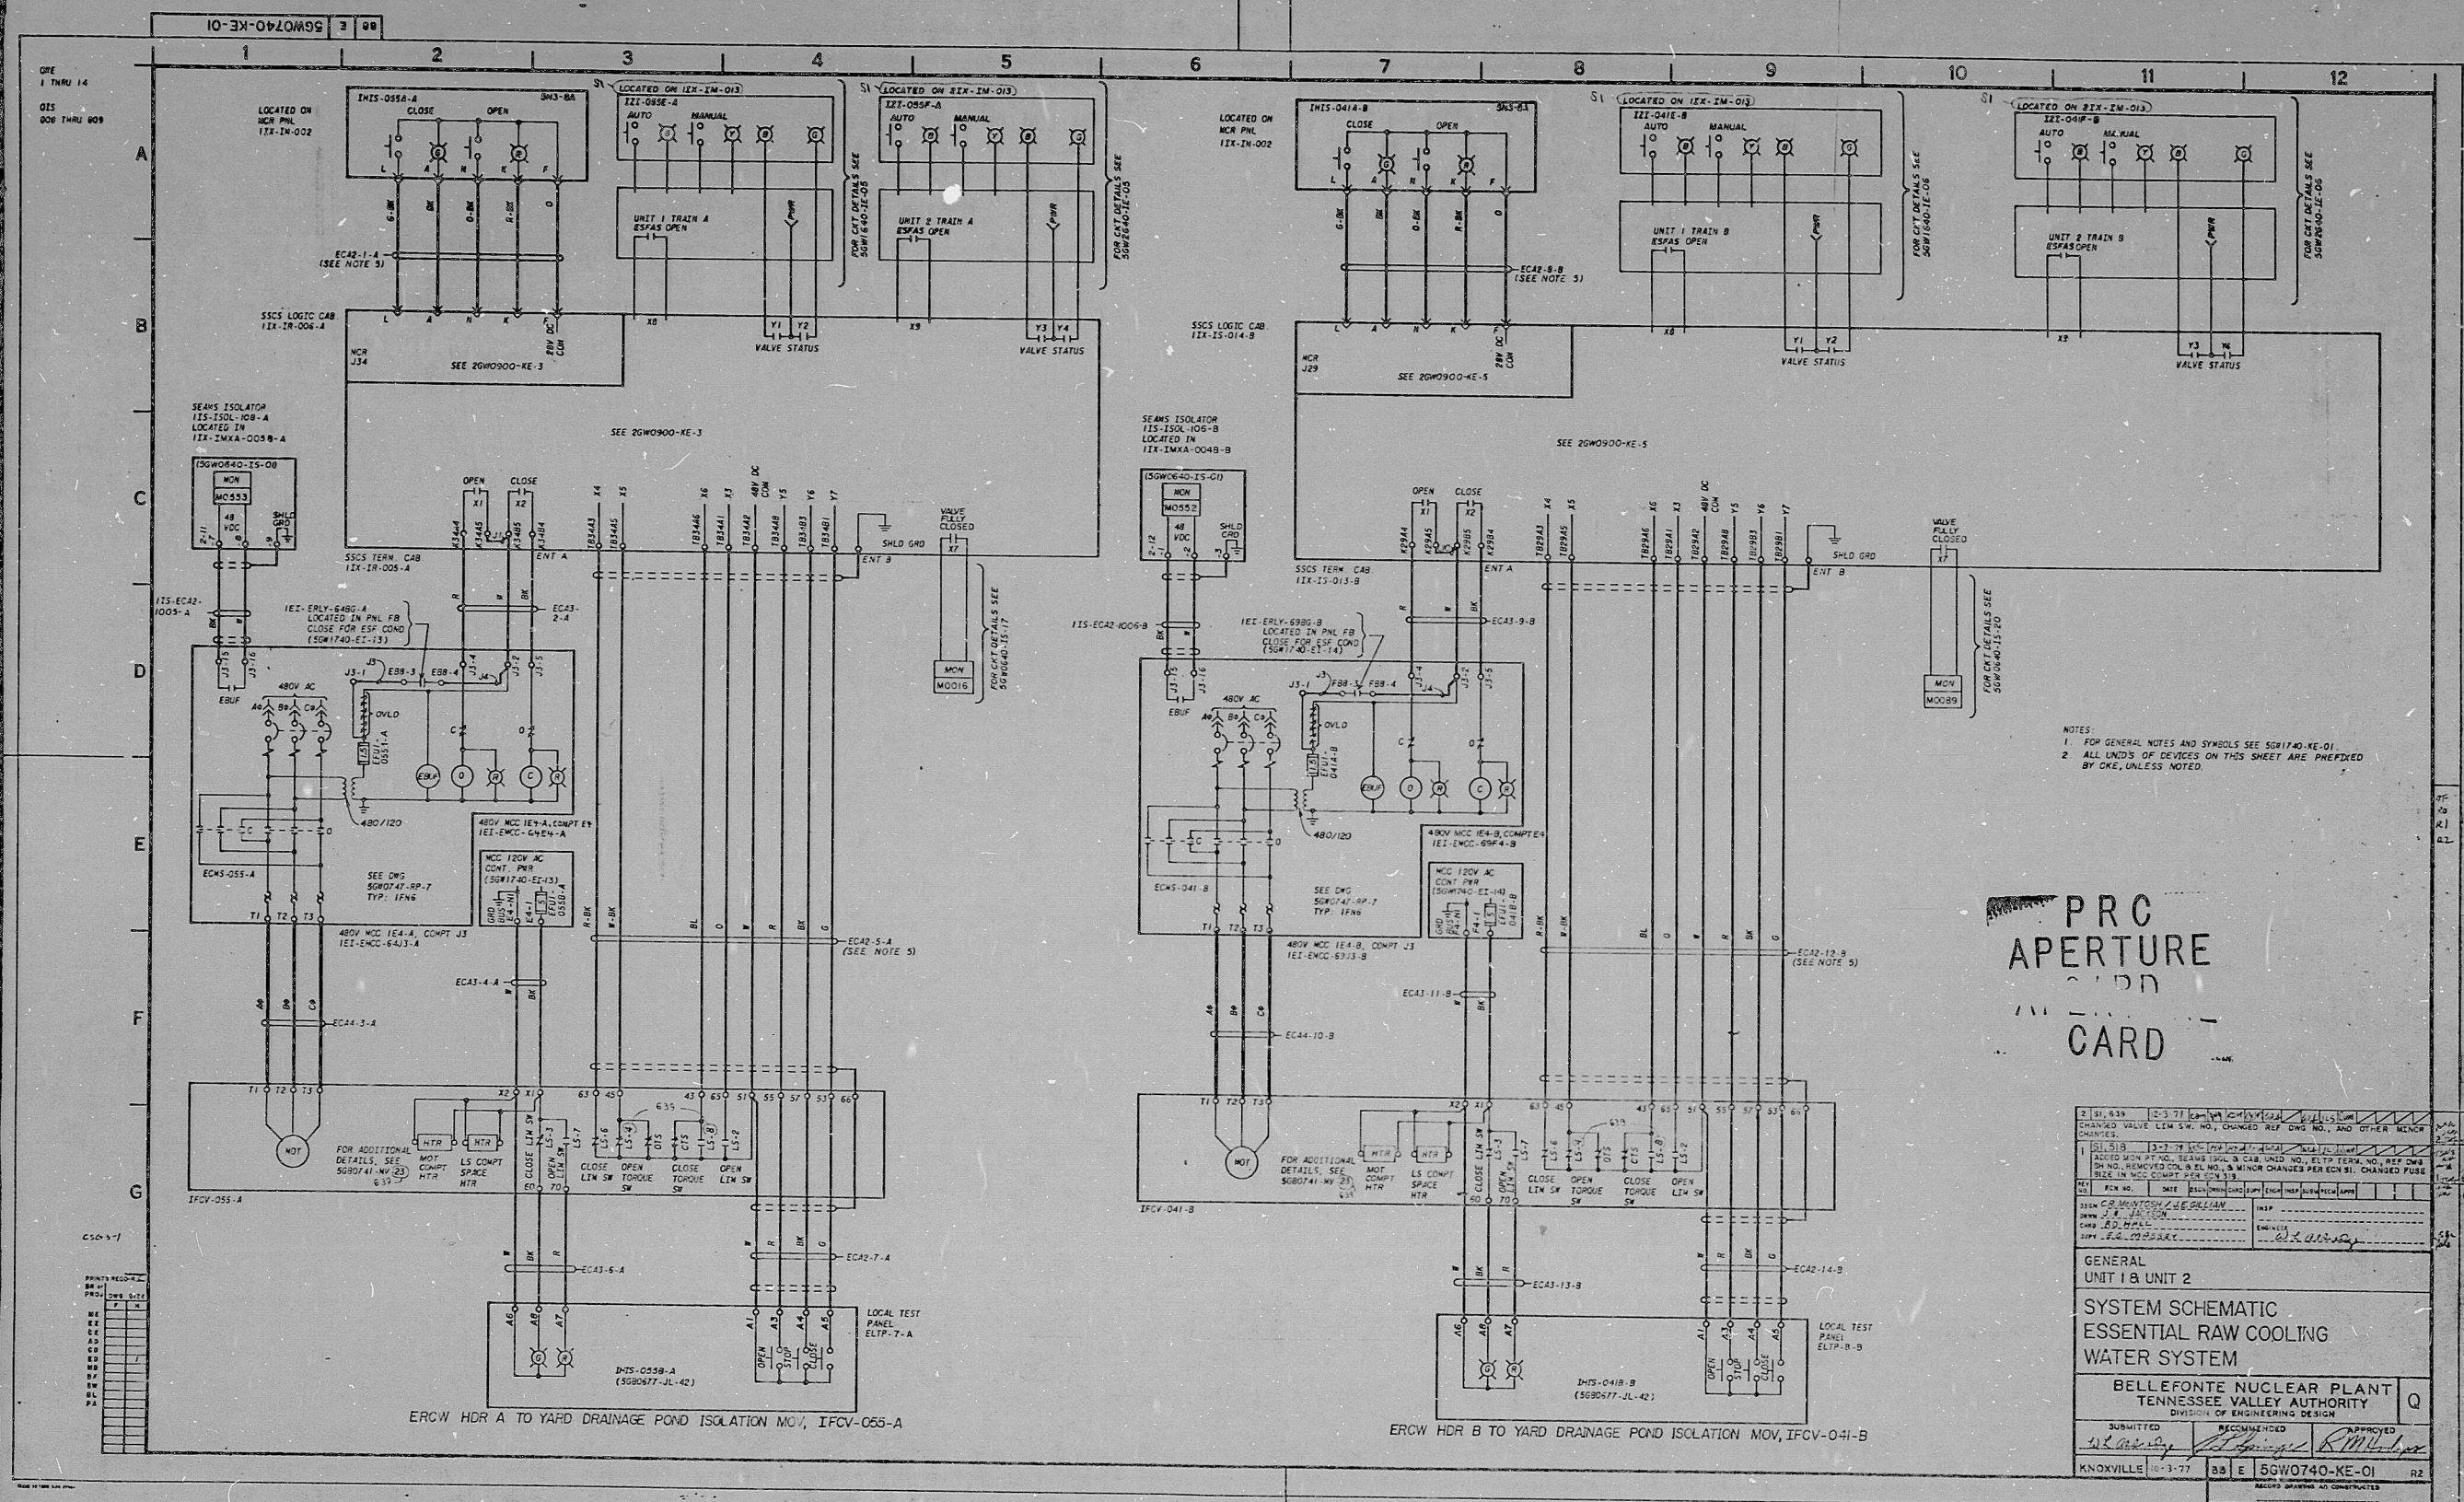